IREDELL COUNTY HEALTH DEPARTMENT

Statesville Office (704) 878-5305 Mooresville Office (704) 660-3625 PERMIT # 207767

IMPROVEMENT PERMIT / AUTHORIZATION TO CONSTRUCT / OPERATION PERMIT / EXISTING SYSTEM

PIN # 4664-87-0764.000

APPLICANT: Shea Homes APPLICANT ADDRESS: 8008 Corporate Center Dr. Charlotte NC

SITE ADDRESS: 205 Walking Horse Trail Davidson NC PHONE: — ALT. PHONE: —

SITE DIRECTIONS: Sherrers Rd. TL Anniston Way, TR Burnell, TL Walking Horse

SUBDIVISION: Anniston SECTION: 4 LOT # 125 LOT AREA: 0.79 acre DESIGN FLOW: 480 GPD L.T.A.R.: .3

Septic Tank 1000 (gal) STB 825 Date 6-3-15
Pump Tank 1000 (gal) PT 302 Date 6-11-15
Pump Make Zoeller Model N152 Serial #
Nitrification Fields 1 # Lines 4 @ 100' Linear Ft: 400'
Trench Width 36" Max. Trench Bottom Depth 36" Gravel Depth N/A

☒ New System ☐ Repair ☐ Expansion System Type: I II III IV V VI
System Description: 25% Reduction - Pump
Repair System Description: UPPERS
Maintenance Agreement Required: ☐ YES ☒ NO
☐ GRAVITY ☒ PRESSURE

☒ Residence No. Bedrooms 4
☐ Business No. Persons 8
☐ Other No. Employees
☐ Slab ☒ Crawl Space
☐ Basement w/plumbing ☐ Basement w/o plumbing

Water Supply: ☒ Private ☐ Public ☐ Community

Comments / Conditions: Follow all Septic Rules.

10/2/15 Checked elect & alarm

INITIAL SITE SKETCH

See Attached/Approved Plan
By Michael Athanas
Assoc. APPROVED JAN 12 2015

AS BUILT SKETCH

Checked Lines, Tanks, Set 2' PH
JA 10-8-15

Permit can be suspended or revoked if any false information is supplied toward securing the permit / any unauthorized changes are made to the site / any unauthorized changes are made in the installation of the system. **CONTACT A LOCATOR SERVICE PRIOR TO ANY EXCAVATION**

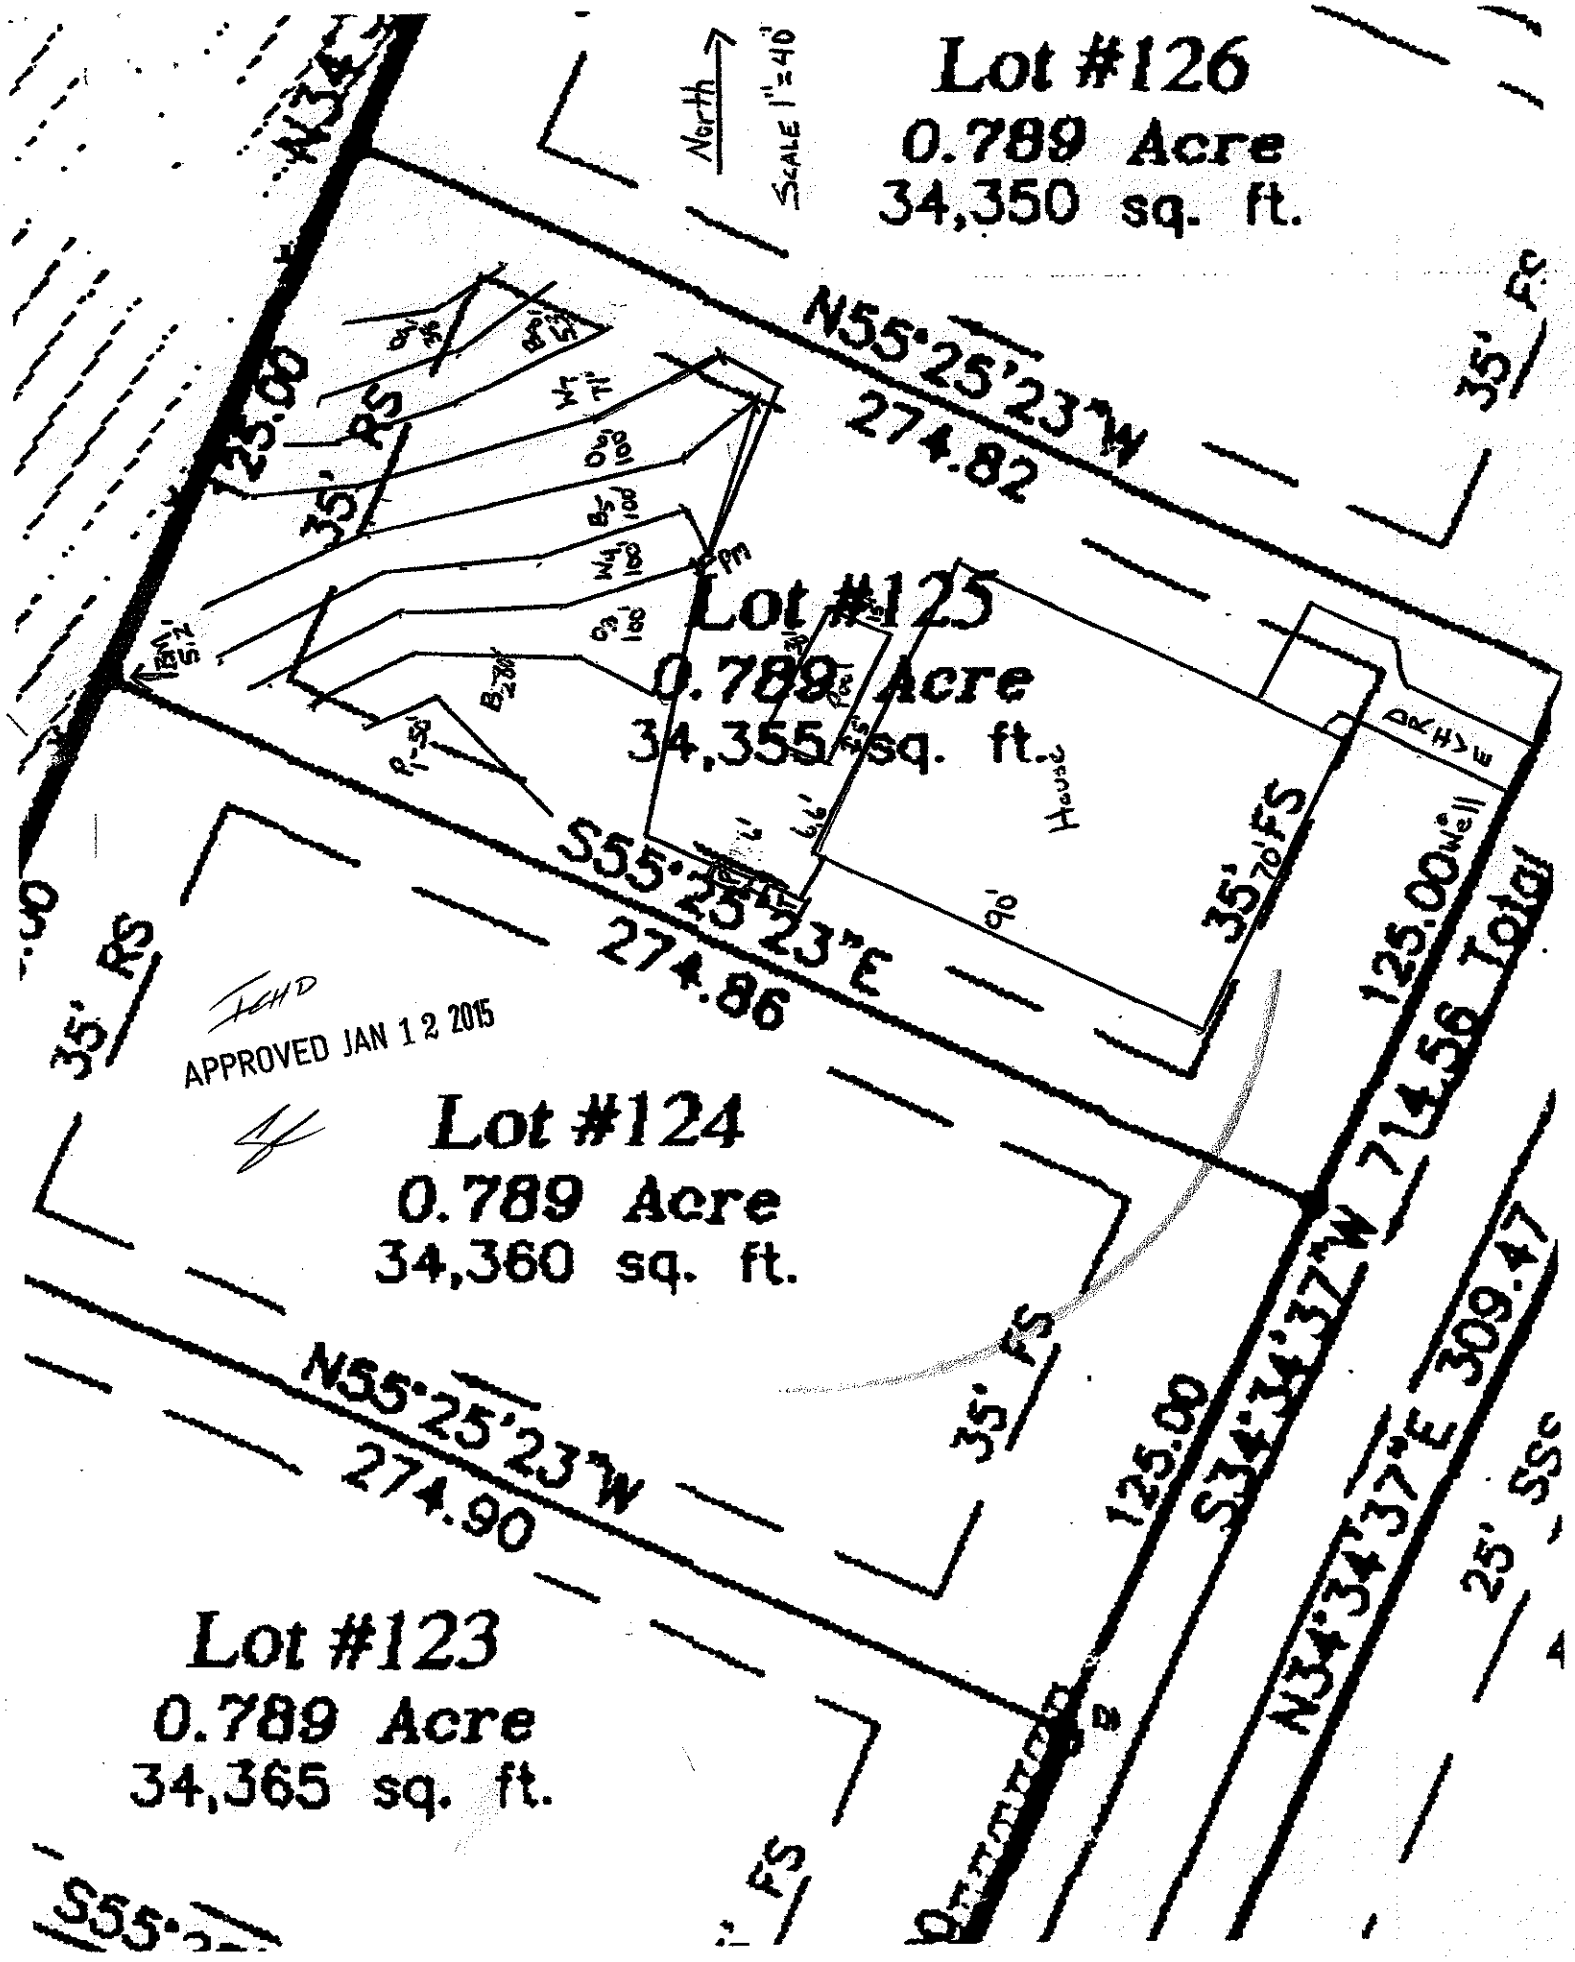
☐ **IMPROVEMENT PERMIT** *with plat valid without expiration.* ☒ **IMPROVEMENT PERMIT** *with site plan valid for 60 mos.* ☐ **AUTHORIZATION TO CONSTRUCT** *valid for period equal to IMPROVEMENT PERMIT--not to exceed 60 mo.*

Owner / Applicant Signature: [signature] Date: 1/23/15 Installed by: Rowan Septic

IMPROVEMENT PERMIT by: [signature] APPROVED JAN 12 2015 OPERATION PERMIT by: Marcus Dobson Date: 10/21/15

AUTHORIZATION TO CONSTRUCT by: Richard Farris Date: 1/30/15 Existing System inspected by: Date:

Health Dept. Copy - WHITE Applicant (Final Approval) - YELLOW Applicant (Conditional Approval) - PINK


Lot #126
0.789 Acre
34,350 sq. ft.
North
SCALE 1"=40'
N55°25'23"W
274.82
35' FS
25.00 RS
35' RS
Lot #125
0.789 Acre
34,355 sq. ft.
ARKYLE
House
S55°25'23"E
274.86
35' RS
35.70' FS
125.00 Neil
714.58 Total
APPROVED JAN 12 2015
Lot #124
0.789 Acre
34,360 sq. ft.
N55°25'23"W
274.90
35' FS
125.00
S34°34'37"W
N34°34'37"E 309.47
25' SSC
Lot #123
0.789 Acre
34,365 sq. ft.
S55°
FS