Site Address: 217 Walking Horse Trail

IREDELL COUNTY HEALTH DEPARTMENT

STATESVILLE 704-878-5305 MOORESVILLE 704-664-5281

IMPROVEMENT PERMIT / AUTHORIZATION TO CONSTRUCT / OPERATION PERMIT / EXISTING SYSTEM INSPECTION

PERMIT# ~~15164?~~ 21264 6 PIN# ~~4664878629~~ Shea 4664-87-8927 V DATE 8/5/08

OWNER OR APPLICANT Rollins Soil & Environmental Servs / Home PHONE: Business 704.658.1723 Home

ADDRESS 470 N Broad St, Suite D. Mooresville, NC 28115

LOCATION Shearers Rd, TL Anniston, TR Burnell, TL Walking Horse

SUBDIVISION Anniston BLOCK / SECTION 4 LOT 127 LOT AREA 0.85 acres SITE CLASS. P.S. DESIGN FLOW 480 T.A.R. 0.3

Septic Tank: 1500 Gallons: STB 7061 Date 1-4-16

Pump Tank: Gallons: PT Date

Pump Make: Model Serial No.

Nitrification Field: No Fields 1 Square Feet 1500 Linear Feet 500

No Lines 5 Trench Width 36" Max Trench Bottom Depth 36" Gravel Depth — ☑ Gravity ☐ Pressure

☑ New System ☐ Repair ☐ Expansion System Type: I II III IV V VI

System Description: 25% gravity

Repair System Description: LPPPBPS

Maintenance Agreement Required: ☐ Yes ☑ No

☑ House/Mod. Home No. Bedrooms 4

☐ Mobile Home No. Persons

☐ Business No. Employees

☐ Other

Water Supply: ☐ Individual ☐ Public ☐ Community

☐ Slab ☑ Crawl Space ☐ Basement w/plumbing ☐ Basement wo/plumbing

Comments:/Conditions:

- Fast Track Design by Rollins Env.
Note: Septic Drainfield is located 162 Ft off Front Pl.

INITIAL SITE SKETCH

Install per design specs by Rollins Env.

704.658.1723

Comments:/Conditions: 8/10/15 Reviewed Floor plans, in Compliance with Septic plan

AS BUILT SKETCH

INSTALLED AS SHOWN ON SITE PLAN

WHAT APPEARED TO BE DRAINAGE IN THE INITIAL AREA WAS FOUND TO BE MOSTLY LITHOCHROMIC BY BEN ALDRIDGE, ADRIAN FRUETT, ALAN MCKINNY. PERMIT LOWERED TO 4BR DUE TO SOIL CONDITIONS FOUND & SUGGESTION BY ALAN MCKINNY.


Permit can be suspended or revoked if any false information is supplied toward securing the permit/any unauthorized changes are made to the site/any unauthorized changes are made in the installation of the system. Improvement Permit with plat valid without expiration ☐ / Improvement Permit with site plan valid for sixty months ☑ Authorization to Construct is valid for a period equal to that of Improvement Permit – not to exceed sixty months.

Signed: [signature] date 8/8/08 Installed by: Rowan

Improvement Permit by: [signature] date 8/5/08 Operation Permit by: [signature] date 2-25-16

Authorization to Construct by: Maria Dotson RS date 8/10/15 Existing System Inspection by: date

HEALTH DEPT. COPY: WHITE OWNER COPY (FINAL): YELLOW OWNER COPY (INITIAL): PINK

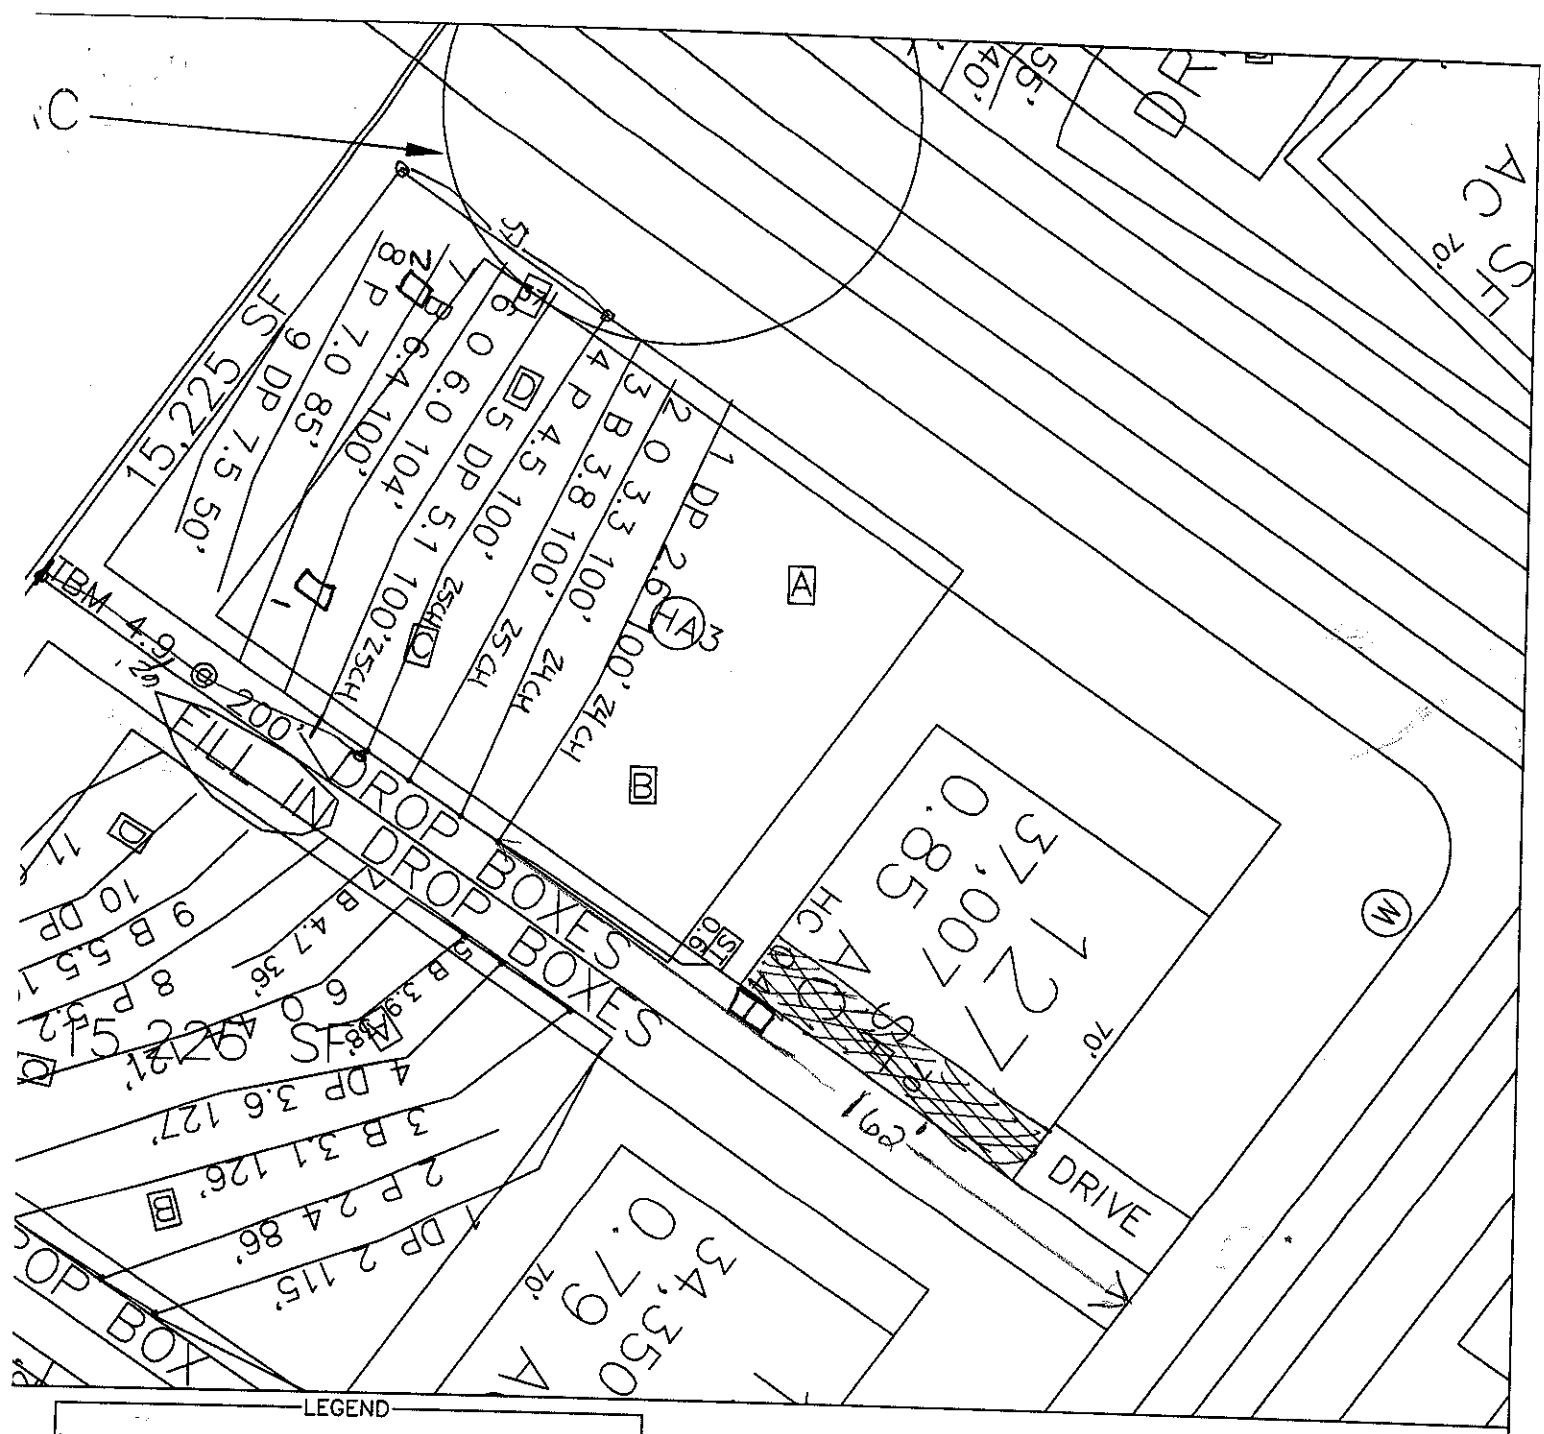

LEGEND

- Areas contain soils with 24 inches or more of useable material and have potential for conventional, modified conventional and low-pressure pipe (lpp) septic systems.
- House Footprint (All 70' x 70')
- System lines.
- Repair lines.
- TBM.
- Well Location.
- [A] RS&ES Pit Location.
- (25) RS&ES Boring Location.
- (28) Health Dept. Pit Location.

1-4-19
2001

GRAPHIC SCALE
1" = 40'

40 0 40 80

FOR PRELIMINARY PLANNING PURPOSES ONLY. ALL LOTS WILL REQUIRE FINAL APPROVAL BY THE COUNTY HEALTH DEPARTMENT ON A LOT BY LOT BASIS. THIS MAP SHOULD BY USED AS A GENERAL GUIDE, SOME ADJUSTMENTS WILL BE NECESSARY IN THE FIELD DUE TO SOIL VARIABILITY AND COMPLEX TOPOGRAPHIC FEATURES. THIS MAP ONLY REFLECTS EXISTING SOIL SUITABILITY FOR ON-SITE SEPTIC TANK SYSTEMS.

PLEASE REFER TO ATTACHED SOIL REPORT FOR ADDITIONAL SITE SPECIFIC INFORMATION

ROLLANS SOIL & ENVIRONMENTAL SERVICES
470 NORTH BROAD ST., SUITE D
MOORESVILLE, NC 28115
PHONE: 704.658.1723 FAX: 704.658.1724
ASHLEY ROLLANS, NC LICENSED SOIL SCIENTIST
MOBILE: (704) 746 - 5046
EMAIL: ROLLANS@WINDSTREAM.NET

MAP TITLE: SITE PLAN & DRAINFIELD AREAS

LOCATION/DATE: SHEARER CHAPEL ROAD, IREDELL COUNTY, NORTH CAROLINA, JULY 2000

PROJECT NAME: NIBLOCK DEVEOPMENT CORP. / ANNISTON PHASE IV

JOB # : 01-1005
FILE: C:\JOBS\01-1005
PROJECT MGR.: S.A.R.
FIELD WORK: S.A.R.
DRAWN BY: S.A.R.