BF 206043 ✓

IREDELL COUNTY HEALTH DEPARTMENT

Statesville Office (704) 878-5305 Mooresville Office (704) 660-3625 PERMIT # ~~LS1 #18~~

IMPROVEMENT PERMIT / AUTHORIZATION TO CONSTRUCT / OPERATION PERMIT / EXISTING SYSTEM

PIN # 4664-~~97-3411.~~ ~~163~~ 87-9456

APPLICANT: ANNISTON II LLC/Mark Benitez APPLICANT ADDRESS: PO Box 39 CORNELIUS 28031

SITE ADDRESS: 117 OVERLOOK RIDGE LN. PHONE: 704-658-1723 ALT. PHONE:

SITE DIRECTIONS: SHEARERS, TL ANNISTON WAY, TR BURNELL, TL WALKING HORSE TR, TR OVERLOOK

SUBDIVISION: ANNISTON SECTION: 4 LOT # 163 LOT AREA: DESIGN FLOW: 480 L.T.A.R.: 13

Septic Tank 1000 (gal) STB 794 Date 3-25-15
Pump Tank (gal) PT Date
Pump Make Model Serial #
Nitrification Fields 1 # Lines Linear Ft: 400'
Trench Width 36" Max. Trench Bottom Depth *24"* Gravel Depth

☒ New System ☐ Repair ☐ Expansion System Type: I II (III) IV V VI
System Description: GRAVITY 25% REDUCTION
Repair System Description: LP - PANEL BLOCK
Maintenance Agreement Required: ☐ YES ☒ NO ☐ GRAVITY ☒ PRESSURE

☒ Residence No. Bedrooms 4
☐ Business No. Persons
☐ Other No. Employees
☐ Slab ☒ Crawl Space
☐ Basement w/plumbing ☐ Basement w/o plumbing

Water Supply: ☒ Private ☐ Public ☐ Community

Comments / Conditions: 7/22/14 Reviewed Floor plans, In compliance with original Septic plan

* No vehicular traffic over tanks (STOP) Driveway must stop before tank location
** total dimensions of House footprint including decks & porches can not exceed 70'x70'

INITIAL SITE SKETCH

SEE PLAN FROM ROLLANS SOIL & ENV. SERVICES

APPROVED FEB 24 2014

BA

AS BUILT SKETCH

400' CHAMBERS INSTALLED

Permit can be suspended or revoked if any false information is supplied toward securing the permit / any unauthorized changes are made to the site / any unauthorized changes are made in the installation of the system. **CONTACT A LOCATOR SERVICE PRIOR TO ANY EXCAVATION**

☐ **IMPROVEMENT PERMIT** *with plat valid without expiration* ☒ **IMPROVEMENT PERMIT** *with site plan valid for 60 mos.* ☒ **AUTHORIZATION TO CONSTRUCT** *valid for period equal to IMPROVEMENT PERMIT--not to exceed 60 mo.*

Owner / Applicant Signature: Robin Belcher Date: 3-3-14

IMPROVEMENT PERMIT by: APPROVED FEB 24 2014 Date:


AUTHORIZATION TO CONSTRUCT by: Date: 7/22/14

Installed by: ABERNATHY

OPERATION PERMIT by: APPROVED Date: JUN 18 2015

Existing System Inspected by: Date:

Health Dept. Copy - WHITE Applicant (Final Approval) - YELLOW Applicant (Conditional Approval) - PINK

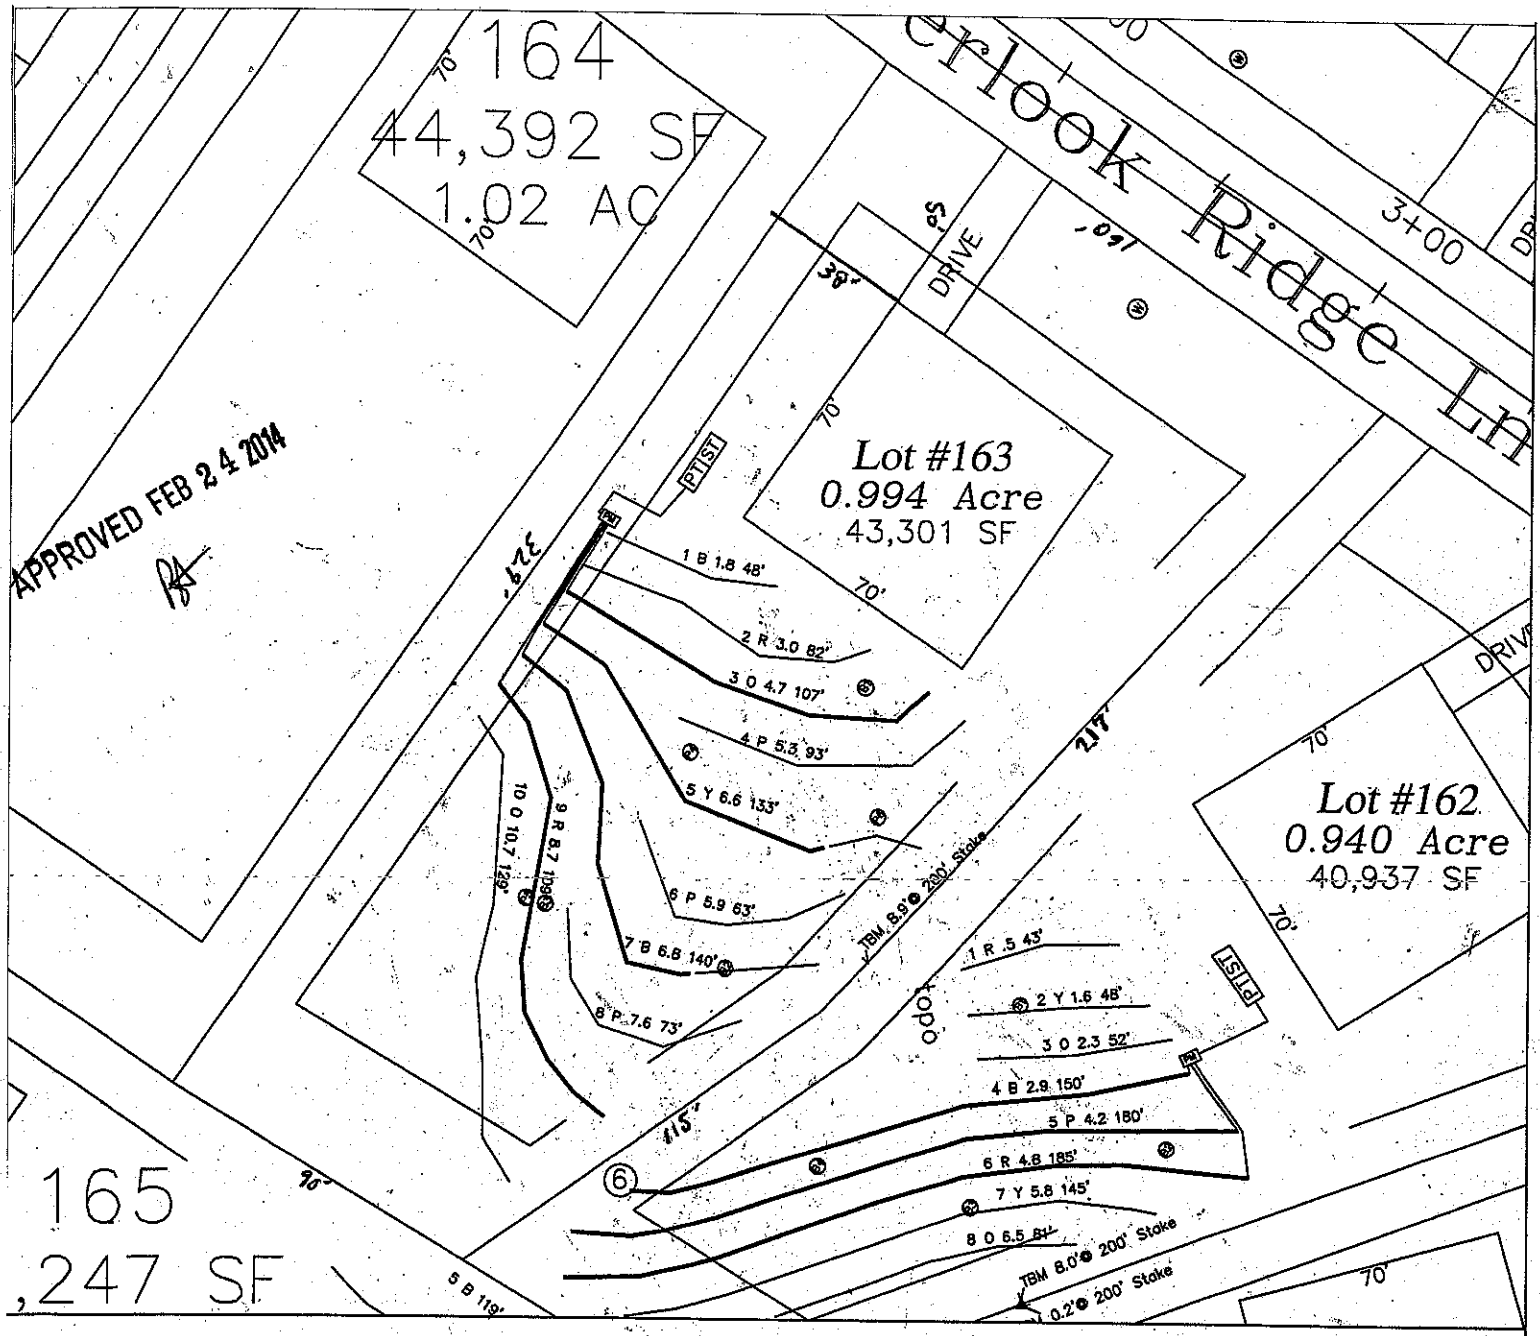

LEGEND

Areas contain soils with 24 inches or more of useable material and have potential for conventional, modified conventional and low-pressure pipe (lpp) septic systems.

House Footprint

System lines.

Repair lines.

Temporary Bench Mark (TBM)

Well Location. (25) Pit/Boring Location.

GRAPHIC SCALE
1" = 50'

50 0 50 100

FOR PRELIMINARY PLANNING PURPOSES ONLY. ALL LOTS WILL REQUIRE FINAL APPROVAL BY THE COUNTY HEALTH DEPARTMENT ON A LOT BY LOT BASIS. THIS MAP SHOULD BY USED AS A GENERAL GUIDE, SOME ADJUSTMENTS WILL BE NECESSARY IN THE FIELD DUE TO SOIL VARIABILITY AND COMPLEX TOPOGRAPHIC FEATURES. THIS MAP ONLY REFLECTS EXISTING SOIL SUITABILITY FOR ON-SITE SEPTIC TANK SYSTEMS.

PLEASE REFER TO ATTACHED SOIL REPORT FOR ADDITIONAL SITE SPECIFIC INFORMATION

ROLLANS SOIL & ENVIRONMENTAL SERVICES, PA
P.O. BOX 832
MOORESVILLE, NC 28115
PHONE/FAX: (704) 278-0989
ASHLEY ROLLANS, NC LICENSED SOIL SCIENTIST
MOBILE: (704) 746-5046
EMAIL: rollans.ashley@yahoo.com

MAP TITLE: SITE PLAN & DRAINFIELD AREAS

PROJECT NAME: GREG MOTON / ANNISTON SUBDIVISION LOT 47

LOCATION/DATE: SHEARER CHAPEL ROAD IREDELL COUNTY, NORTH CAROLINA JANUARY 2014

JOB # : 01-1852
FILE: C:\JOBS\01-1852
PROJECT MGR.: S.A.R.
FIELD WORK: S.A.R.
DRAWN BY: S.A.R.