# IREDELL COUNTY HEALTH DEPARTMENT

Statesville Office (704) 878-5305 Mooresville Office (704) 660-3625

PERMIT # 213|86

## IMPROVEMENT PERMIT / AUTHORIZATION TO CONSTRUCT / OPERATION PERMIT / EXISTING SYSTEM

PIN # 466 488 9102

APPLICANT: Shea Homes APPLICANT ADDRESS: 8008 Corporate Center Dr Ste 300 Charlotte, NC

SITE ADDRESS: 225 Walking Horse Trail Davidson NC PHONE: 704 301 3229 ALT. PHONE:

SITE DIRECTIONS: Shearers Rd TL Anniston Way TR Burnell TL Walking Horse @ intersection w/ Riverstone Dr

SUBDIVISION: Anniston SECTION: 4 LOT # 128 LOT AREA: .854 Ac DESIGN FLOW: 480 gpd L.T.A.R.: .3

Septic Tank 1000 (gal) STB 825 Date 1-4-16
Pump Tank (gal) PT Date
Pump Make Model Serial #
# Nitrification Fields 1 # Lines 4 @ 100' Linear Ft: 400'
Trench Width 36" Max. Trench Bottom Depth 36" Gravel Depth N/A

[X] New System [ ] Repair [ ] Expansion System Type: I II (III) IV V VI
System Description: Gravity - 25% Reduction
Repair System Description: PPB-DS
Maintenance Agreement Required: [ ] YES [X] NO
[X] GRAVITY [ ] PRESSURE

[X] Residence No. Bedrooms 4
[ ] Business No. Persons 8
[ ] Other No. Employees
[ ] Slab [X] Crawl Space
[ ] Basement w/plumbing [ ] Basement w/o plumbing

Water Supply: [X] Private [ ] Public [ ] Community

Comments / Conditions:

Note: Gully in rear of lot must be filled "properly"

INITIAL SITE SKETCH

See attached / approved plan by Michael Athanas & Assoc. dated 10/1/2015

AS BUILT SKETCH

INSTALLED AS SHOWN

*Permit can be suspended or revoked if any false information is supplied toward securing the permit / any unauthorized changes are made to the site / any unauthorized changes are made in the installation of the system.* **CONTACT A LOCATOR SERVICE PRIOR TO ANY EXCAVATION**

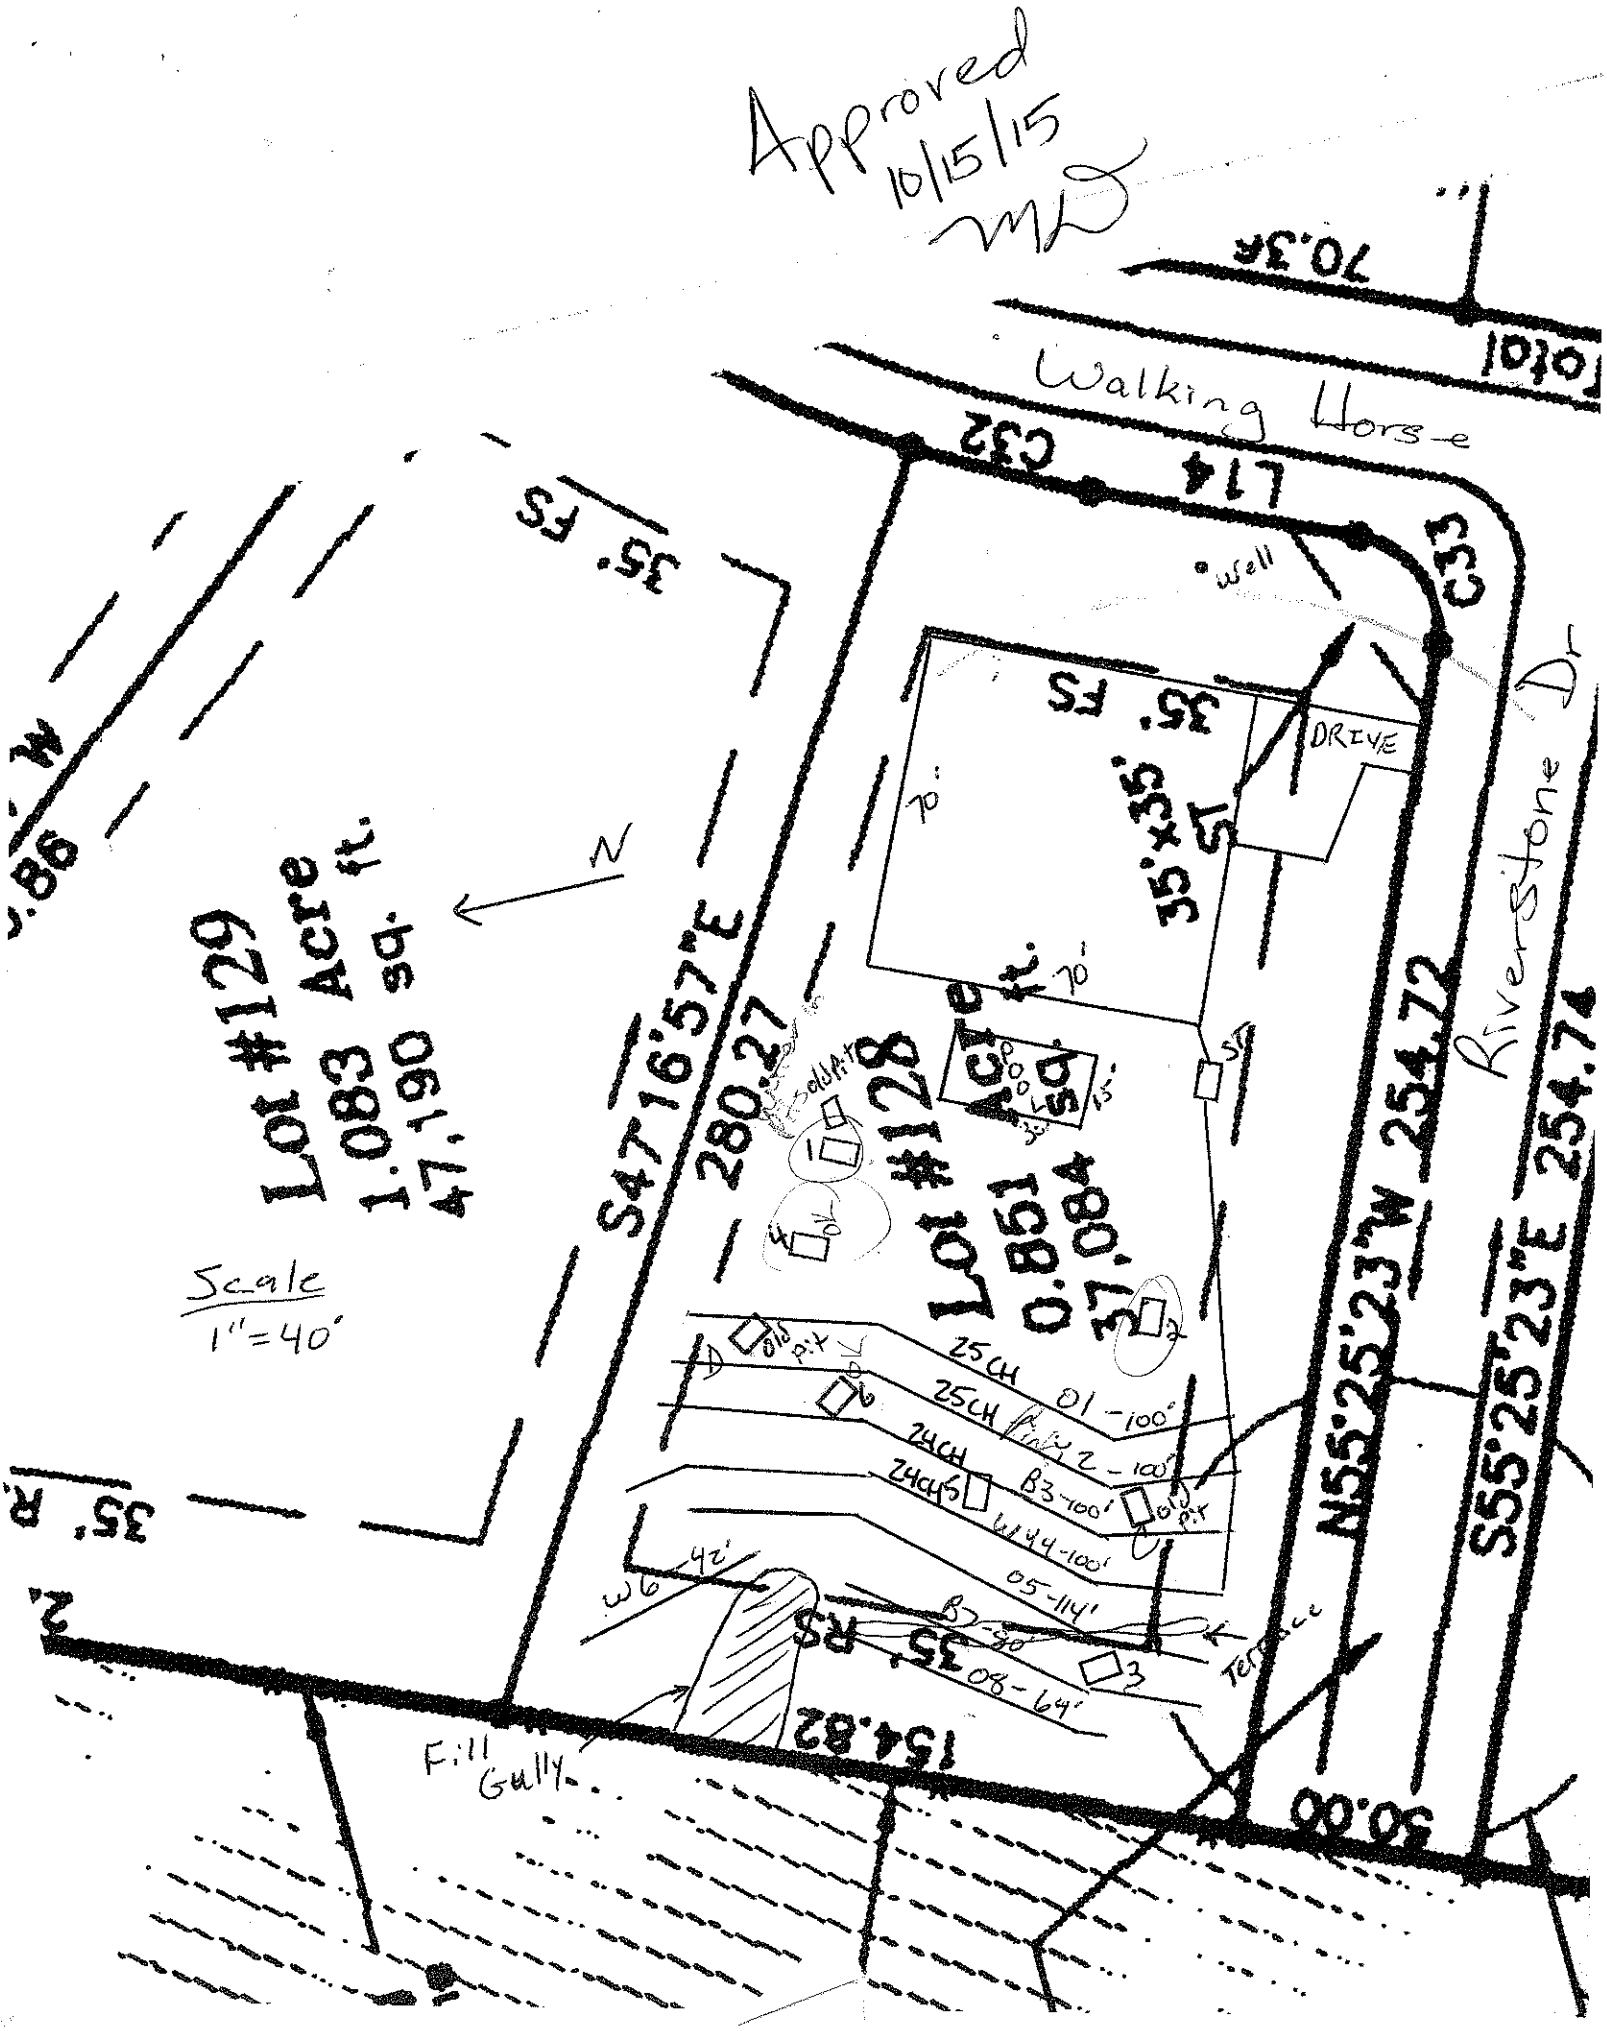
[ ] **IMPROVEMENT PERMIT** *with plat valid without expiration.* [ ] **IMPROVEMENT PERMIT** *with site plan valid for 60 mos.* [ ] **AUTHORIZATION TO CONSTRUCT** *valid for period equal to IMPROVEMENT PERMIT--not to exceed 60 mo.*

Owner / Applicant Signature: Date: 11-3-15 Installed by: Rowan

IMPROVEMENT PERMIT by: Marina Dotson RS Date: 10/15/15 OPERATION PERMIT by: Date: 3-21-16

AUTHORIZATION TO CONSTRUCT by: Marina Dotson RS Date: 10/15/15 Existing System Inspected by: Date:

Health Dept. Copy - WHITE Applicant (Final Approval) - YELLOW Applicant (Conditional Approval) - PINK


Approved
10/15/15
Walking Horse
Riverstone Dr
Well
DRIVE
Lot #129
1.083 Acre
47,160 sq. ft.
Lot #128
0.851 Acre
37,084 sq. ft.
S47°16'57"E
280.27
N55°25'23"W 254.72
S55°25'23"E 254.74
154.82
35' FS
35' RS
C32
C33
L14
70.3A
Scale
1"=40'
Fill
Gully
Terrace
25CH 01-100'
25CH B1-100'
24CH B3-100'
24CH W4-100'
05-114'
08-64'
W6
42'