IREDELL COUNTY HEALTH DEPARTMENT

Statesville Office (704) 878-5305 Mooresville Office (704) 660-3625 PERMIT # 180962

IMPROVEMENT PERMIT / AUTHORIZATION TO CONSTRUCT / OPERATION PERMIT / EXISTING SYSTEM

PIN # 4664.97.3~~44.156~~-1722

APPLICANT: ANNISTON LLC / Mark Benitez APPLICANT ADDRESS: PO BOX 39 CORNELIUS

SITE ADDRESS: 111 OVERLOOK RIDGE LN. PHONE: ALT. PHONE:

SITE DIRECTIONS: STARKERS - TL ANNISTON WAY - TL BURNELL - TL WALKING HORSE - TR OVERLOOK - ON LT

SUBDIVISION: ANNISTON SECTION: IV LOT # 155 LOT AREA: .91AC DESIGN FLOW: 600 L.T.A.R.: .3

Septic Tank	~~1000~~ 1500 (gal)	STB	444	Date	7-9-15	☑ New System ☐ Repair ☐ Expansion	System Type: I II (III) IV V VI	☑ Residence	No. Bedrooms	5	Water Supply
Pump Tank	1500 (gal)	PT	477	Date	7-14-15	System Description:	PUMP 25% REDUCTION	☐ Business	No. Persons	10	☑ Private
Pump Make		Model		Serial #		Repair System Description:	LPP PEBPS	☐ Other	No. Employees		☐ Public
# Nitrification Fields	1	# Lines	4	Linear Ft:	500	Maintenance Agreement Required:	☐ YES ☑ NO	☐ Slab	☑ Crawl Space		☐ Community
Trench Width	36"	Max. Trench Bottom Depth	22"	Gravel Depth	N/A		☐ GRAVITY ☑ PRESSURE	☐ Basement w/plumbing			☐ Basement w/o plumbing

Comments / Conditions: 7/22/14 Reviewed floor plans, in compliance with original plan.
★ Note: No vehicular traffic over tanks, drive must not be in area of tanks

10/12/15 Set 2ft pressure, checked effluent alarm

INITIAL SITE SKETCH

ST/PT

SEE ROLLANS SOIL & ENVIRONMENTAL'S PLAN

AS BUILT SKETCH

CHECKED TANKS & LINES & PM 1/2" 40 TAPS 8-25-15 JA

Permit can be suspended or revoked if any false information is supplied toward securing the permit / any unauthorized changes are made to the site / any unauthorized changes are made in the installation of the system. **CONTACT A LOCATOR SERVICE PRIOR TO ANY EXCAVATION**


☐ **IMPROVEMENT PERMIT** ***with plat*** *valid without expiration.* ☑ **IMPROVEMENT PERMIT** ***with site plan*** *valid for 60 mos.* ☐ **AUTHORIZATION TO CONSTRUCT** *valid for period equal to IMPROVEMENT PERMIT--not to exceed 60 mo.*

Owner / Applicant Signature: [signature] Date: 11/22/13 Installed by: Richard Abernathy

IMPROVEMENT PERMIT by: [signature] Date: 9/17/13 OPERATION PERMIT by: Maria Dotson RS Date: 10/12/15

AUTHORIZATION TO CONSTRUCT by: Maria Dotson RS Date: 7/22/14 Existing System Inspected by: Date:

Health Dept. Copy - WHITE Applicant (Final Approval) - YELLOW Applicant (Conditional Approval) - PINK

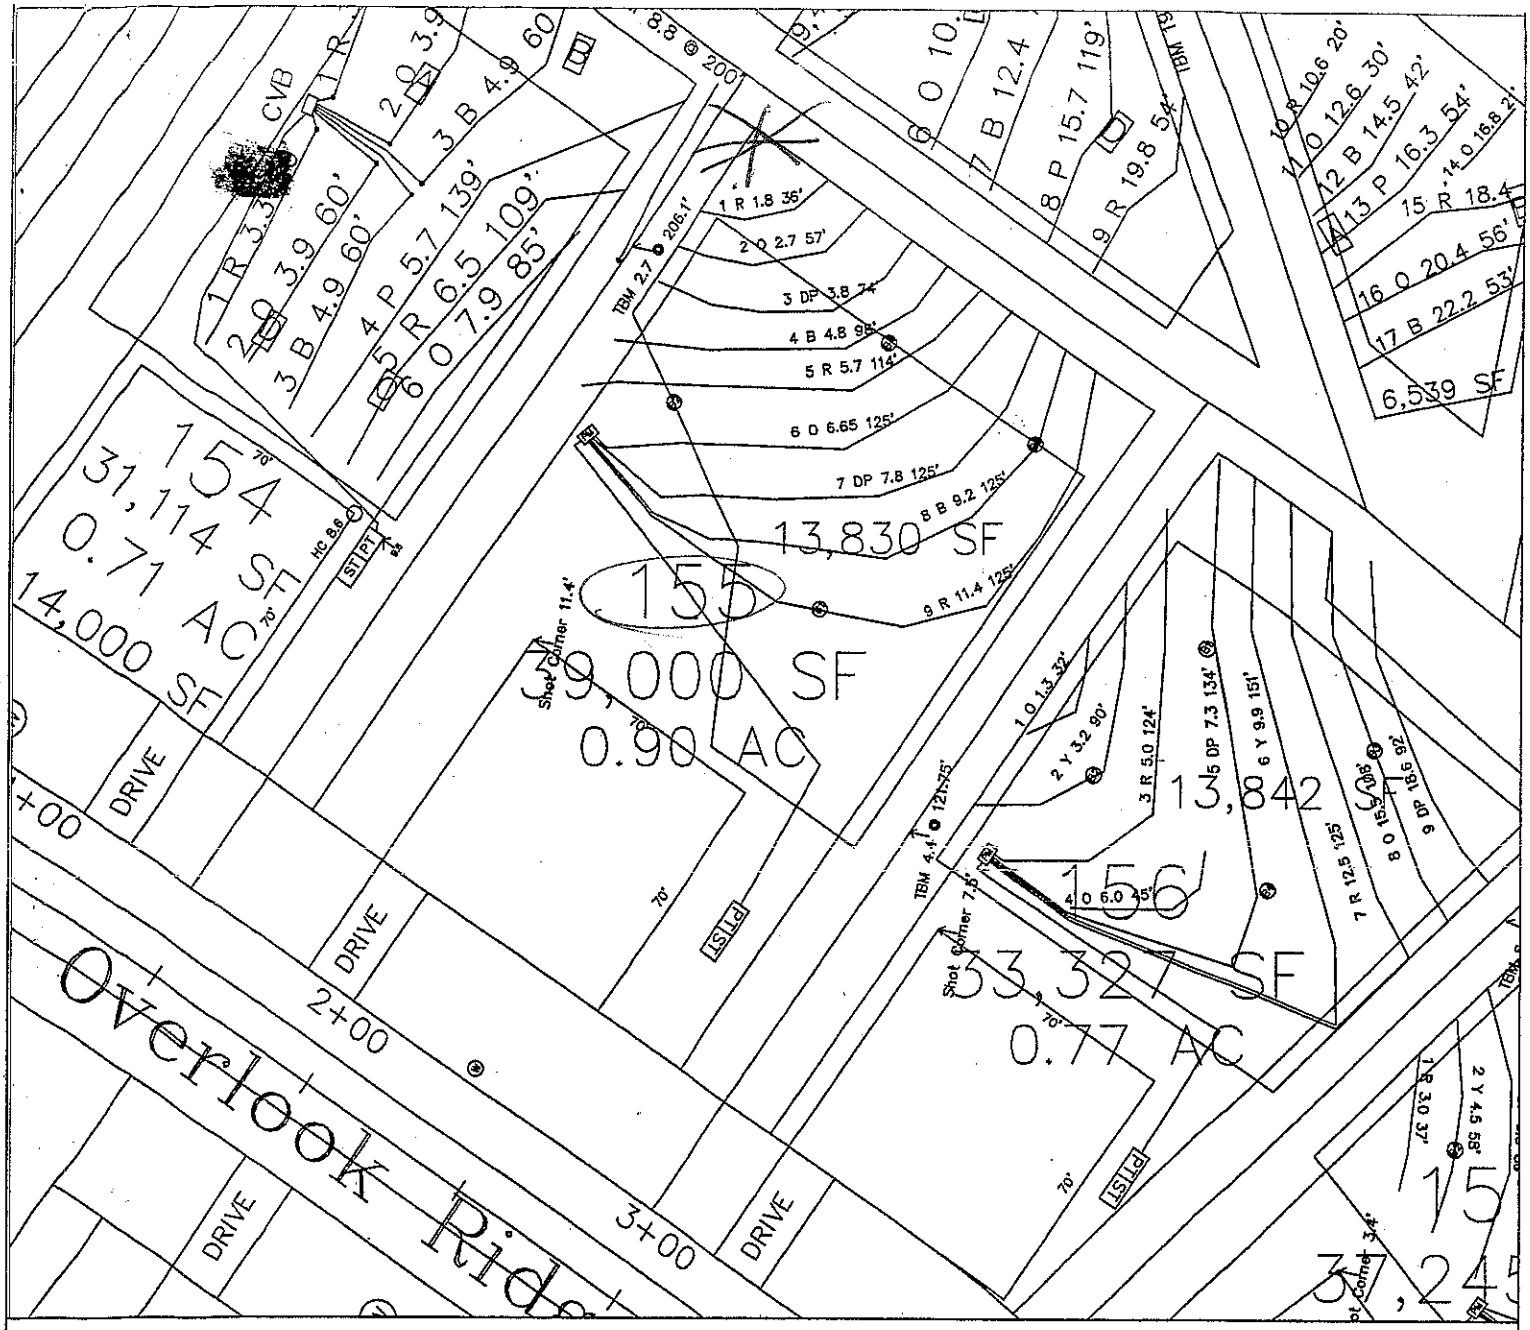

LEGEND

Areas contain soils with 24 inches or more of useable material and have potential for conventional, modified conventional and low-pressure pipe (lpp) septic systems.

House Footprint

System lines.

Repair lines.

Temporary Bench Mark (TBM)

Well Location. (25) Pit Location.

OVL
SF

GRAPHIC SCALE
1" = 50'

50 0 50 100

FOR PRELIMINARY PLANNING PURPOSES ONLY. ALL LOTS WILL REQUIRE FINAL APPROVAL BY THE COUNTY HEALTH DEPARTMENT ON A LOT BY LOT BASIS. THIS MAP SHOULD BY USED AS A GENERAL GUIDE, SOME ADJUSTMENTS WILL BE NECESSARY IN THE FIELD DUE TO SOIL VARIABILITY AND COMPLEX TOPOGRAPHIC FEATURES. THIS MAP ONLY REFLECTS EXISTING SOIL SUITABILITY FOR ON-SITE SEPTIC TANK SYSTEMS.

PLEASE REFER TO ATTACHED SOIL REPORT FOR ADDITIONAL SITE SPECIFIC INFORMATION

ROLLANS SOIL & ENVIRONMENTAL SERVICES, PA
P.O. BOX 832
MOORESVILLE, NC 28115
PHONE/FAX: (704) 278-0989
ASHLEY ROLLANS, NC LICENSED SOIL SCIENTIST
MOBILE: (704) 746-5046
EMAIL: rollans.ashley@yahoo.com

MAP TITLE: SITE PLAN & DRAINFIELD AREAS

PROJECT NAME: ANNISTON II, LLC / ANNISTON SUBDIVISION

LOCATION/DATE: SHEARER CHAPEL ROAD, IREDELL COUNTY, NORTH CAROLINA, SEPTEMBER 2013

JOB # : 01-1005
FILE: C:\JOBS\01-1005
PROJECT MGR.: S.A.R.
FIELD WORK: S.A.R.
DRAWN BY: S.A.R.