IREDELL COUNTY HEALTH DEPARTMENT

Statesville Office (704) 878-5305 Mooresville Office (704) 660-3625 PERMIT # 4664972068 - 18123

IMPROVEMENT PERMIT / AUTHORIZATION TO CONSTRUCT / OPERATION PERMIT / EXISTING SYSTEM

PIN # 9664973411.160 211180

APPLICANT: ~~Rollins~~ ANNISTON LLC/Peachtree APPLICANT ADDRESS: PO BOX 39 CORNELIUS, NC 28031

SITE ADDRESS: 132 OVERLOOK Ridge Ln PHONE: ALT. PHONE:

SITE DIRECTIONS: SHEARERS - TL ANNISTON - TR BURNELL PL - TL WALKING HORSE TL - TR OVERLOOK.

SUBDIVISION: ANNISTON SECTION: 4 LOT # 160 LOT AREA: DESIGN FLOW: 600 L.T.A.R.: .3

Septic Tank	1500.✓	(gal)	STB	338	Date	1-4-16	☑ New System	☐ Repair	☐ Expansion	System Type: I II (III) IV V VI	☑ Residence	No. Bedrooms	5	Water Supply	
Pump Tank	—	(gal)	PT	—	Date	—	System Description:	GRAVITY 25% REDUCTION			☐ Business	No. Persons	10	☑ Private	
Pump Make	—		Model	—	Serial #	—	Repair System Description:	LATERALS			☐ Other	No. Employees		☐ Public	
# Nitrification Fields	1	# Lines		8	Linear Ft:	500	Maintenance Agreement Required:	☐ YES	☑ NO		☐ Slab	☐ Crawl Space		☐ Community	
Trench Width	36"	Max. Trench Bottom Depth		28"	Gravel Depth	N/P		☑ GRAVITY	☐ PRESSURE		☑ Basement w/plumbing			☐ Basement w/o plumbing	


Comments / Conditions: SET TANK SHALLOW TO ACHIEVE GRAVITY - SLOPE MAY NEED TO BE MODIFIED TO ACHIEVE GRAVITY

Note: Floor plans only show 4 Bedrooms 6/17/15 Reviewed Floor plans in Compliance with Septic Plan.

INITIAL SITE SKETCH

SEE ROLLINS SOIL & ENVIRONMENTAL SERVICES PLAN.

AS BUILT SKETCH

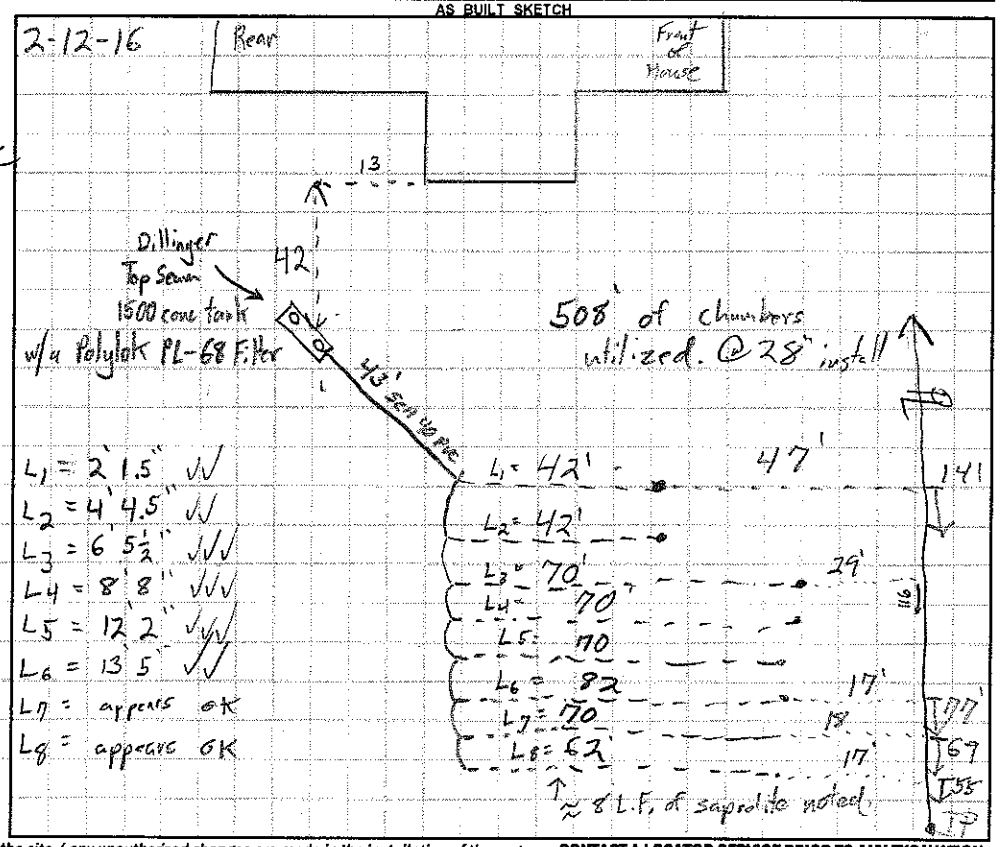

Permit can be suspended or revoked if any false information is supplied toward securing the permit / any unauthorized changes are made to the site / any unauthorized changes are made in the installation of the system. **CONTACT A LOCATOR SERVICE PRIOR TO ANY EXCAVATION**


☐ **IMPROVEMENT PERMIT** *with plat valid without expiration.* ☑ **IMPROVEMENT PERMIT** *with site plan valid for 60 mos.* ☒ **AUTHORIZATION TO CONSTRUCT** *valid for period equal to IMPROVEMENT PERMIT--not to exceed 60 mo.*

Owner / Applicant Signature: W. Kelly Date: 11/22/13 Installed by: Richard Abernathy

IMPROVEMENT PERMIT by: Date: 11/21/13 OPERATION PERMIT by: Tom Shuck Date: 2-26-16

AUTHORIZATION TO CONSTRUCT by: Date: 6/17/15 Existing System Inspected by: Date:

Health Dept. Copy - WHITE Applicant (Final Approval) - YELLOW Applicant (Conditional Approval) - PINK

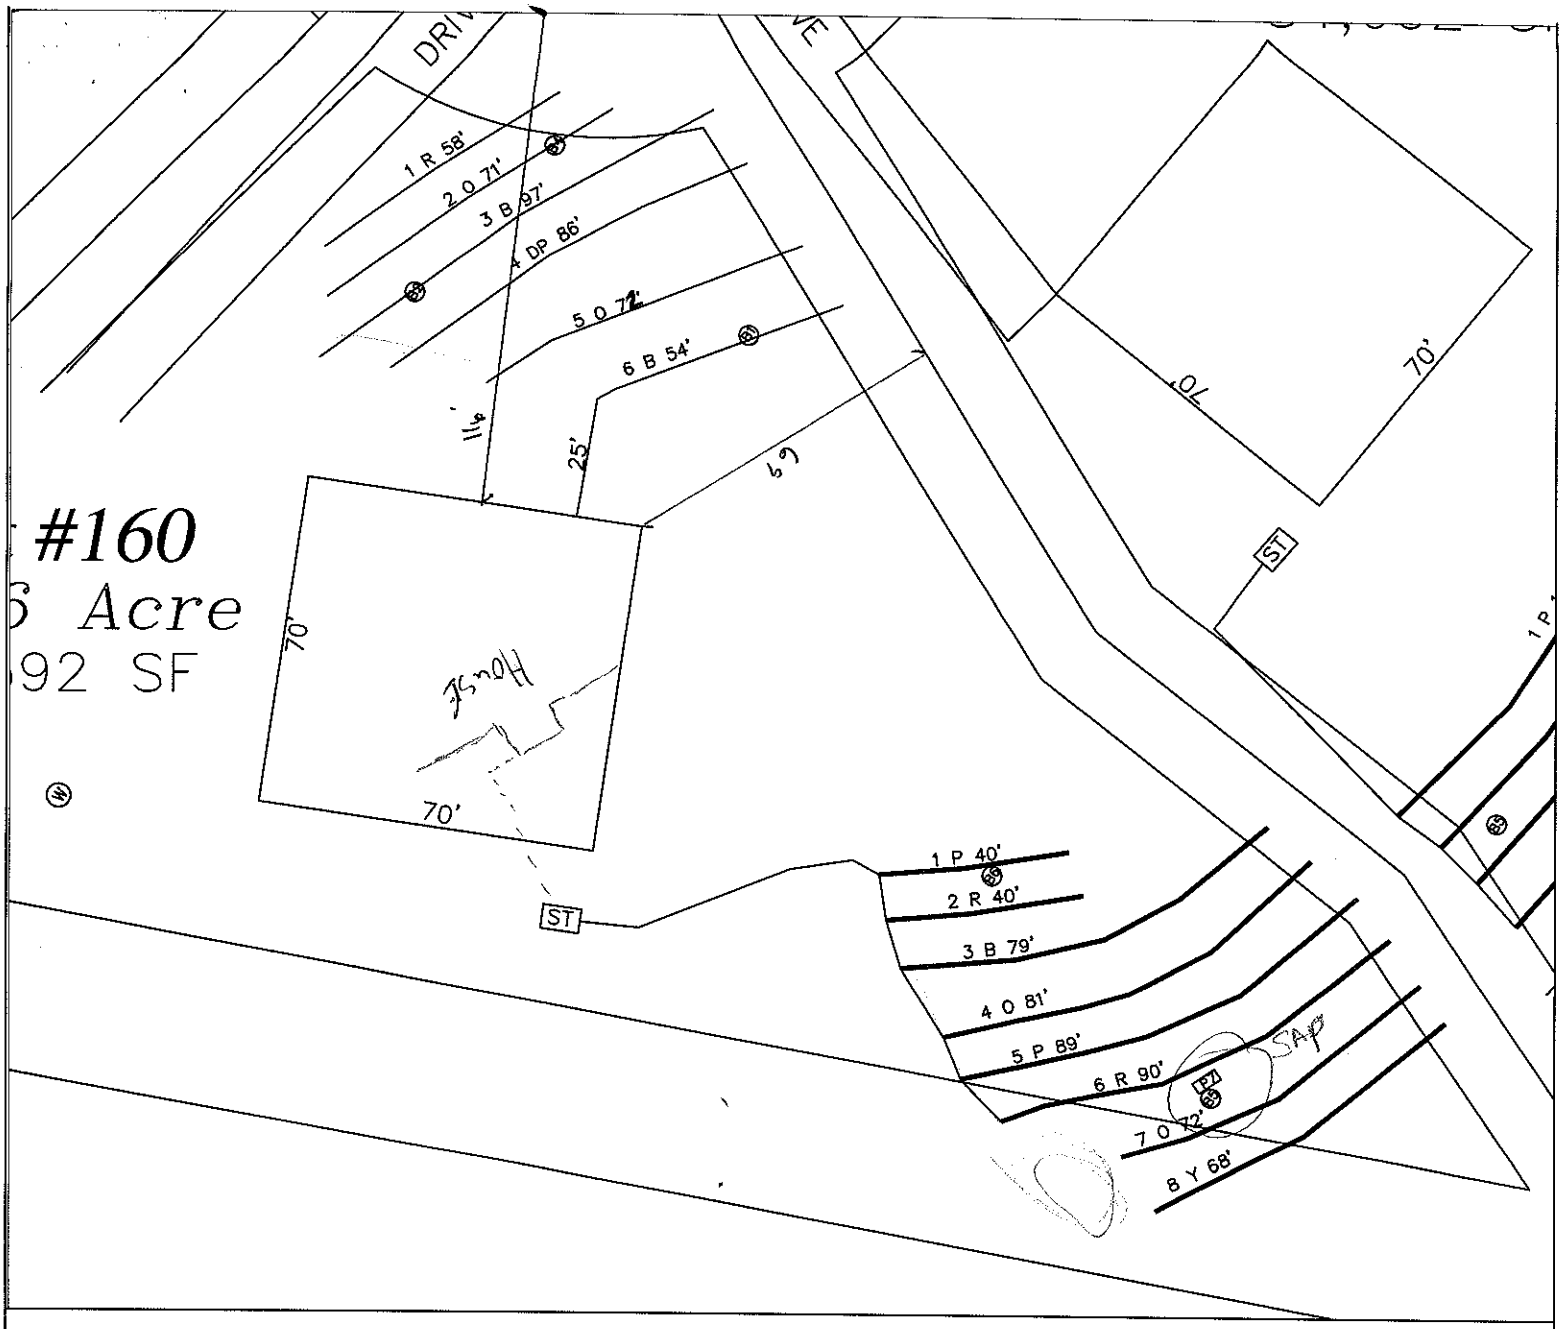

LEGEND

- Areas contain soils with 24 inches or more of useable material and have potential for conventional, modified conventional and low–pressure pipe (lpp) septic systems.
- House Footprint
- System lines.
- Repair lines.
- Temporary Bench Mark (TBM)
- (W) Well Location.
- (25) Pit/Boring Location.

OK CMP 12/30/13

GRAPHIC SCALE

1" = 40'

40 0 40 80

FOR PRELIMINARY PLANNING PURPOSES ONLY. ALL LOTS WILL REQUIRE FINAL APPROVAL BY THE COUNTY HEALTH DEPARTMENT ON A LOT BY LOT BASIS. THIS MAP SHOULD BY USED AS A GENERAL GUIDE, SOME ADJUSTMENTS WILL BE NECESSARY IN THE FIELD DUE TO SOIL VARIABILITY AND COMPLEX TOPOGRAPHIC FEATURES. THIS MAP ONLY REFLECTS EXISTING SOIL SUITABILITY FOR ON–SITE SEPTIC TANK SYSTEMS.

PLEASE REFER TO ATTACHED SOIL REPORT FOR ADDITIONAL SITE SPECIFIC INFORMATION

ROLLANS SOIL & ENVIRONMENTAL SERVICES, PA

P.O. BOX 832
MOORESVILLE, NC 28115
PHONE/FAX: (704) 278 - 0989

ASHLEY ROLLANS, NC LICENSED SOIL SCIENTIST
MOBILE: (704) 746 - 5046
EMAIL: rollans.ashley@yahoo.com

MAP TITLE: SITE PLAN & DRAINFIELD AREAS

PROJECT NAME: ANNISTON II, LLC / ANNISTON SUBDIVISION

LOCATION/DATE: SHEARER CHAPEL ROAD, IREDELL COUNTY, NORTH CAROLINA, SEPTEMBER 2013

JOB # :	01–1005
FILE:	C:\JOBS\01–1005
PROJECT MGR.:	S.A.R.
FIELD WORK:	S.A.R.
DRAWN BY:	S.A.R.