Site Address: 240 Walking Horse Trail

IREDELL COUNTY HEALTH DEPARTMENT

Statesville Office (704) 878-5305 Mooresville Office (704) 660-3625 PERMIT # 205173

IMPROVEMENT PERMIT / AUTHORIZATION TO CONSTRUCT / OPERATION PERMIT / EXISTING SYSTEM

PIN # ~~4664984440~~ 4664-97-3947

APPLICANT: SHEA HOMES APPLICANT ADDRESS: 8008 CORPORATE LAKE DR

SITE ADDRESS: WALKING HORSE ~~LA~~ LOT 152 PHONE: ALT. PHONE: 704-576-3887

SITE DIRECTIONS: SHEARS RD (L) ANNISTON (R) BYRNES (L) WALKING HORSE TO LOTON (R)

SUBDIVISION: ANNISTON SECTION: 4 LOT # 152 LOT AREA: 43,340 sqft DESIGN FLOW: 600 L.T.A.R.: .35

Septic Tank	1500 (gal)	STB	2061	Date	10-15-15	☑ New System ☐ Repair ☐ Expansion System Type: I II (III) IV V VI	☑ Residence	No. Bedrooms	5	Water Supply
Pump Tank	1500 (gal)	PT	46	Date	9-11-15	System Description: 25% REDUCTION	☐ Business	No. Persons	10	☑ Private
Pump Make	ZOELLER Model	N152		Serial #		Repair System Description: ~~25% RED~~ PUMPS	☐ Other	No. Employees		☐ Public
# Nitrification Fields	1 # Lines	6		Linear Ft:	430'	Maintenance Agreement Required: ☐ YES ☐ NO	☐ Slab	☑ Crawl Space		☐ Community
Trench Width	3' Max. Trench Bottom Depth	30"		Gravel Depth	NA	☐ GRAVITY ☒ PRESSURE	☒ Basement w/plumbing	☐ Basement w/o plumbing		

Comments / Conditions: KEEP LINES ON CONTOUR AS PER DESIGN
Keep Septic 100ft from well

7/13/15 Reviewed floor plans, in Compliance with Septic plan
Note: Application stated 4 Bedrooms.

INITIAL SITE SKETCH

SEE ATTACHED DESIGN BY MICHAEL ATHANAS & ASSOC
approved 8-14-14

AS BUILT SKETCH

INSTALLED 3C70' & 3C72'
CHECKED TANKS, LINES, SET 2' PH
2-2-16
~~BA~~ SA

3-1-2016:
Alarm Float - Not functional 2" feather
Pump On/Off Float - Not functional 6" feather
Center-to-center of floats 8"
* - Broken Power Line between control panel & electrical relay point * [Both Broken Out]

3-2-2016: Electrical OK. Pumps functional. Alarm ok

Permit can be suspended or revoked if any false information is supplied toward securing the permit / any unauthorized changes are made to the site / any unauthorized changes are made in the installation of the system. **CONTACT A LOCATOR SERVICE PRIOR TO ANY EXCAVATION**

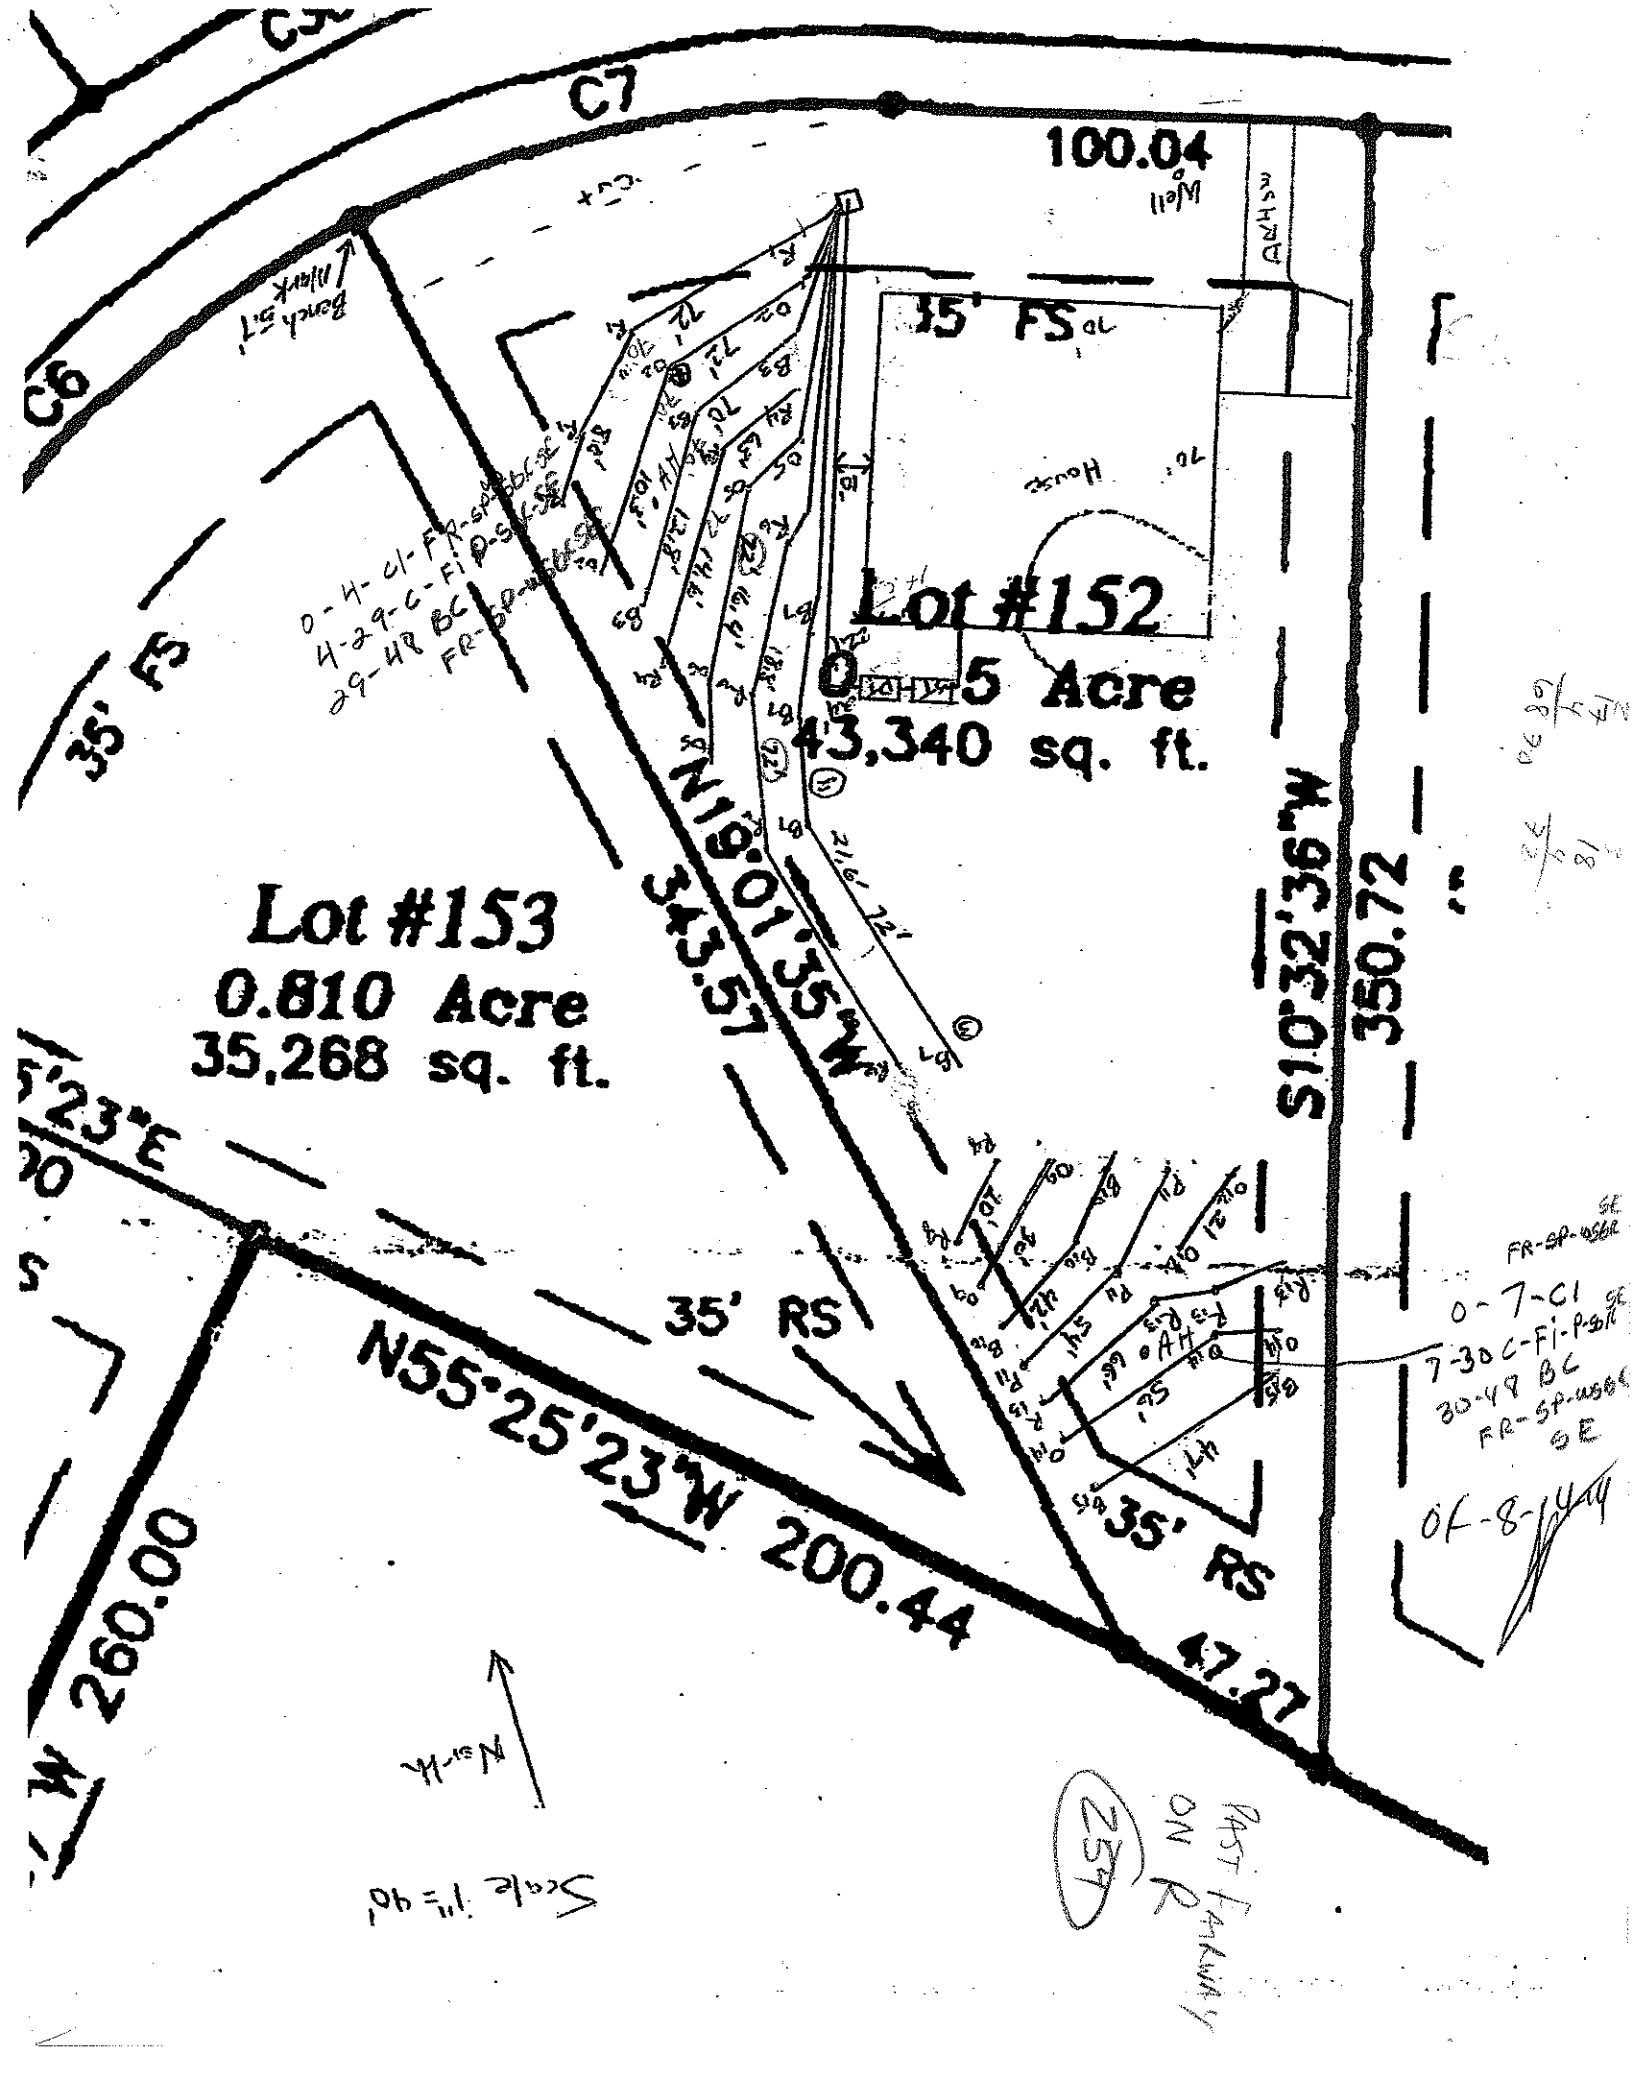
☐ **IMPROVEMENT PERMIT** *with plat valid without expiration.* ☒ **IMPROVEMENT PERMIT** *with site plan valid for 60 mos.* ☒ **AUTHORIZATION TO CONSTRUCT** *valid for period equal to IMPROVEMENT PERMIT--not to exceed 60 mo.*

Owner / Applicant Signature: Date: 11/25/14 Installed by: ROWAN

IMPROVEMENT PERMIT by: Date: 8-14-14 OPERATION PERMIT by: Date: 3-2-2016

AUTHORIZATION TO CONSTRUCT by: Date: 7.1.3.15 Existing System Inspected by: Date:

Health Dept. Copy - WHITE Applicant (Final Approval) - YELLOW Applicant (Conditional Approval) - PINK


C7
C6
100.04
Well
Shed
35' FS
House
Lot #152
0.5 Acre
43,340 sq. ft.
Lot #153
0.810 Acre
35,268 sq. ft.
N19°01'35"W
343.57
S10°32'36"W
350.72
35' FS
35' RS
N55°25'23"W 200.44
47.27
35' RS
N 260.00
Scale 1" = 40'
N
Bank St
Alley
0-4-C1-FR-SP-WSBC SE
4-29-C-Fi-P-SE
29-49 BC
FR-SP-WSBC SE
FR-SP-WSBC SE
0-7-C1
7-30 C-Fi-P-SE
30-49 BC
FR-SP-WSBC SE
0F-8-1/4
254
PAST PARKWAY ON R