IREDELL COUNTY HEALTH DEPARTMENT

Statesville Office (704) 878-5305 Mooresville Office (704) 660-3625

IMPROVEMENT PERMIT / AUTHORIZATION TO CONSTRUCT / OPERATION PERMIT / EXISTING SYSTEM

4664974088 PERMIT # 181724

PIN # ~~4664974088~~

APPLICANT: ANNISTON LLC / Peachtree APPLICANT ADDRESS: PO BOX 39 CORNELIUS NC 28031

SITE ADDRESS: 133 OVERLOOK Ridge Ln. PHONE: ALT. PHONE:

SITE DIRECTIONS: SHEARERS - TL ANNISTON WAY - TR BURNELL - TL WALKING HORSE - TR OVERLOOK -

SUBDIVISION: ANNISTON SECTION: 4 LOT # 159 LOT AREA: DESIGN FLOW: 600 L.T.A.R.: 3

Septic Tank	~~1000~~ 1500 (gal)	STB	444	Date	1-4-16	☐ New System ☐ Repair ☐ Expansion	System Type: I II (III) IV V VI	☑ Residence	No. Bedrooms 5
Pump Tank	— (gal)	PT	—	Date	—	System Description:	GRAVITY 25% REDUCTION	☐ Business	No. Persons 10
Pump Make	—	Model	—	Serial #	—	Repair System Description:	SAME	☐ Other	No. Employees
# Nitrification Fields	1	# Lines	~~6~~ 4	Linear Ft:	500	Maintenance Agreement Required:	☐ YES ☑ NO	☐ Slab	☑ Crawl Space
Trench Width	36"	Max. Trench Bottom Depth	28"	Gravel Depth	N/A		☑ GRAVITY ☐ PRESSURE	☑ Basement w/plumbing	☐ Basement w/o plumbing

Water Supply: ☑ Private ☐ Public ☐ Community


Comments / Conditions:

6/23/15 Reviewed Floorplans, in Compliance with Septic plan / TPP

INITIAL SITE SKETCH

SEE ROLLANS SOIL & ENVIRONMENTAL SERVICES PLAN.

AS BUILT SKETCH

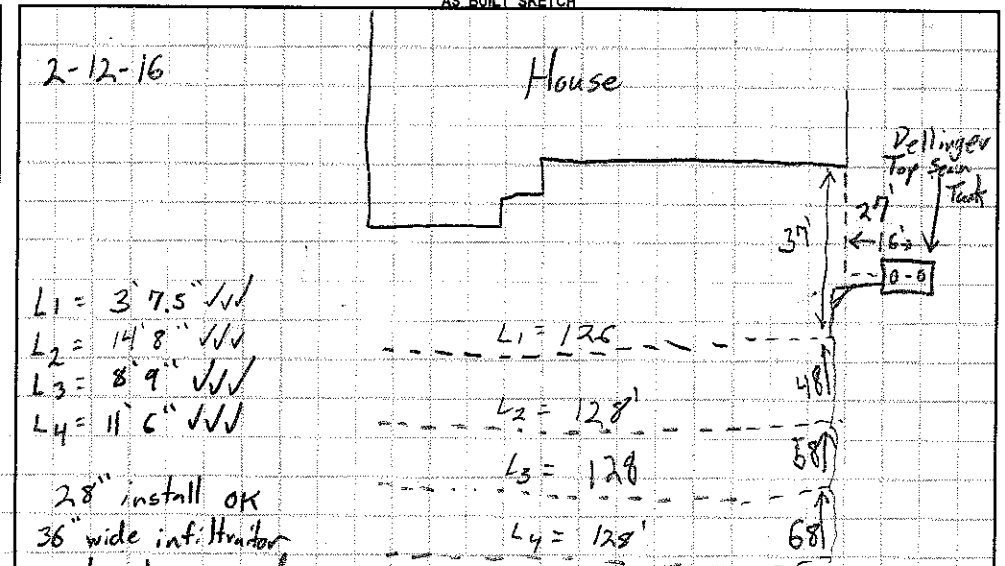

* Appears that house location has changed from the originally permitted location. It is unclear what impact this has had on the site + functionality of the septic system.

Permit can be suspended or revoked if any false information is supplied toward securing the permit / any unauthorized changes are made to the site / any unauthorized changes are made in the installation of the system. **CONTACT A LOCATOR SERVICE PRIOR TO ANY EXCAVATION**

☐ **IMPROVEMENT PERMIT** *with plat valid without expiration.* ☑ **IMPROVEMENT PERMIT** *with site plan valid for 60 mos.* ☒ **AUTHORIZATION TO CONSTRUCT** *valid for period equal to IMPROVEMENT PERMIT--not to exceed 60 mo.*

Owner / Applicant Signature: W. Todd [illegible] Date: 11/22/13 Installed by: Richard Abernathy

IMPROVEMENT PERMIT by: [illegible] Date: 11/21/13 OPERATION PERMIT by: Tom Shuck Date: 2-15-16

AUTHORIZATION TO CONSTRUCT by: [illegible] RS Date: 6/23/15 Existing System Inspected by: Date:

Health Dept. Copy - WHITE Applicant (Final Approval) - YELLOW Applicant (Conditional Approval) - PINK



LEGEND

Areas contain soils with 24 inches or more of useable material and have potential for conventional, modified conventional and low-pressure pipe (lpp) septic systems.

House Footprint

System lines.

Repair lines.

Temporary Bench Mark (TBM)

Well Location. (25) Pit/Boring Location.

GRAPHIC SCALE

1" = 40'

40 0 40 80

FOR PRELIMINARY PLANNING PURPOSES ONLY. ALL LOTS WILL REQUIRE FINAL APPROVAL BY THE COUNTY HEALTH DEPARTMENT ON A LOT BY LOT BASIS. THIS MAP SHOULD BY USED AS A GENERAL GUIDE, SOME ADJUSTMENTS WILL BE NECESSARY IN THE FIELD DUE TO SOIL VARIABILITY AND COMPLEX TOPOGRAPHIC FEATURES. THIS MAP ONLY REFLECTS EXISTING SOIL SUITABILITY FOR ON-SITE SEPTIC TANK SYSTEMS.

PLEASE REFER TO ATTACHED SOIL REPORT FOR ADDITIONAL SITE SPECIFIC INFORMATION


ROLLANS SOIL & ENVIRONMENTAL SERVICES, PA
P.O. BOX 832
MOORESVILLE, NC 28115
PHONE/FAX: (704) 278 - 0989
ASHLEY ROLLANS, NC LICENSED SOIL SCIENTIST
MOBILE: (704) 746 - 5046
EMAIL: rollans.ashley@yahoo.com

MAP TITLE: SITE PLAN & DRAINFIELD AREAS

PROJECT NAME: ANNISTON II, LLC / ANNISTON SUBDIVISION

LOCATION/DATE: SHEARER CHAPEL ROAD, IREDELL COUNTY, NORTH CAROLINA, SEPTEMBER 2013

JOB # : 01-1005
FILE: C:\JOBS\01-1005
PROJECT MGR.: S.A.R.
FIELD WORK: S.A.R.
DRAWN BY: S.A.R.

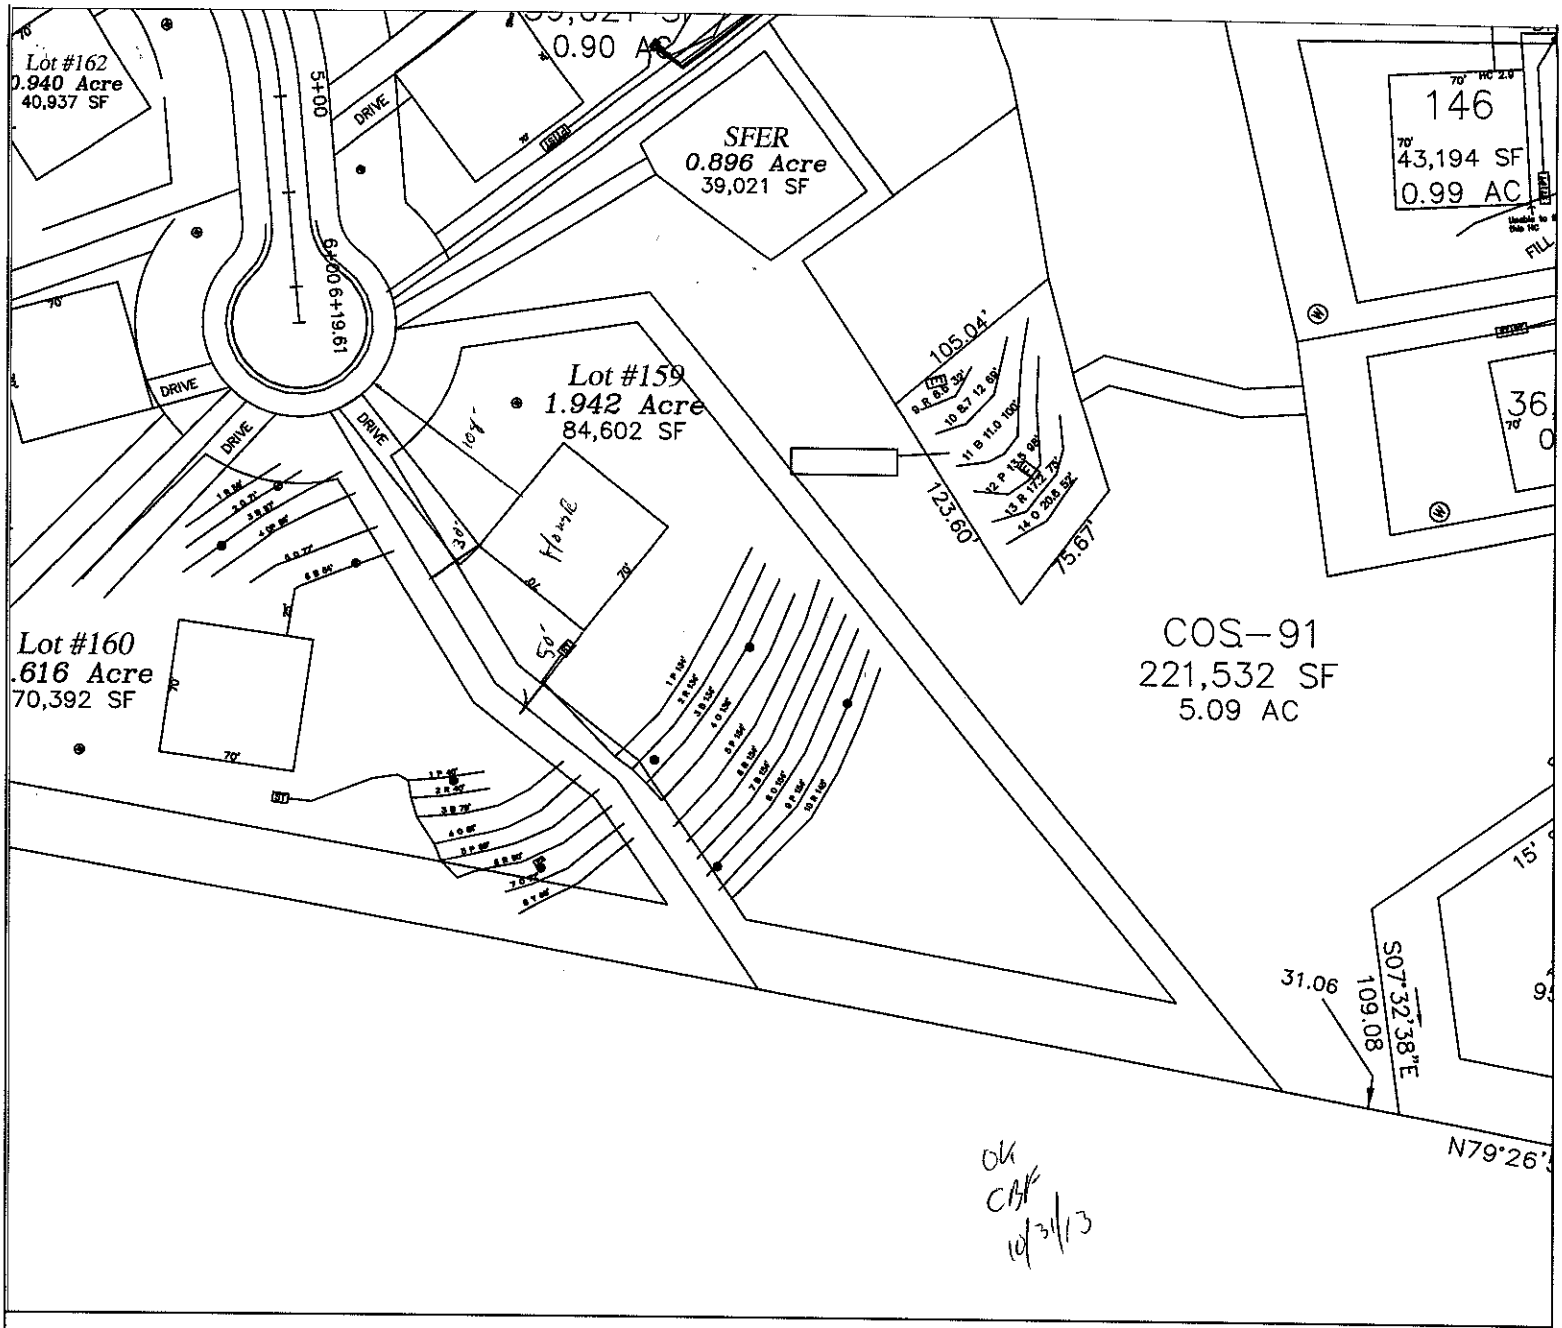

LEGEND

- Areas contain soils with 24 inches or more of useable material and have potential for conventional, modified conventional and low-pressure pipe (lpp) septic systems.
- House Footprint
- System lines.
- Repair lines.
- Temporary Bench Mark (TBM)
- Well Location.
- (25) Pit/Boring Location.

GRAPHIC SCALE
1" = 100'

100 0 100 200

FOR PRELIMINARY PLANNING PURPOSES ONLY. ALL LOTS WILL REQUIRE FINAL APPROVAL BY THE COUNTY HEALTH DEPARTMENT ON A LOT BY LOT BASIS. THIS MAP SHOULD BY USED AS A GENERAL GUIDE, SOME ADJUSTMENTS WILL BE NECESSARY IN THE FIELD DUE TO SOIL VARIABILITY AND COMPLEX TOPOGRAPHIC FEATURES.
THIS MAP ONLY REFLECTS EXISTING SOIL SUITABILITY FOR ON-SITE SEPTIC TANK SYSTEMS.

PLEASE REFER TO ATTACHED SOIL REPORT FOR ADDITIONAL SITE SPECIFIC INFORMATION

ROLLANS SOIL & ENVIRONMENTAL SERVICES, PA
P.O. BOX 832
MOORESVILLE, NC 28115
PHONE/FAX: (704) 278-0989
ASHLEY ROLLANS, NC LICENSED SOIL SCIENTIST
MOBILE: (704) 746-5046
EMAIL: rollans.ashley@yahoo.com

MAP TITLE: SITE PLAN & DRAINFIELD AREAS

PROJECT NAME: ANNISTON II, LLC / ANNISTON SUBDIVISION

LOCATION/DATE: SHEARER CHAPEL ROAD, IREDELL COUNTY, NORTH CAROLINA, SEPTEMBER 2013

JOB # :	01-1005
FILE:	C:\JOBS\01-1005
PROJECT MGR.:	S.A.R.
FIELD WORK:	S.A.R.
DRAWN BY:	S.A.R.