# IREDELL COUNTY HEALTH DEPARTMENT

Statesville Office (704) 878-5305 Mooresville Office (704) 660-3625 PERMIT # 214807

## IMPROVEMENT PERMIT / AUTHORIZATION TO CONSTRUCT / OPERATION PERMIT / EXISTING SYSTEM

PIN # 4664 97 8490

APPLICANT: Backyard Amenities APPLICANT ADDRESS: 360 George W. Liles Pkwy NW Concord, NC 28027

SITE ADDRESS: 298 Walking Horse Trail PHONE: ALT. PHONE: Stan 704 241 1205

SITE DIRECTIONS: Shearers Rd TL Anniston Loop TR Burnell TL Walking Horse lot on right near end

SUBDIVISION: Anniston SECTION: 4 LOT # 146 LOT AREA: .992 Ac DESIGN FLOW: 600 gpd L.T.A.R.: .3

Septic Tank 1500 (gal) STB Date
Pump Tank (gal) PT Date
Pump Make Model Serial #
# Nitrification Fields 1 # Lines 5 Linear Ft: 500'
Trench Width 36" Max. Trench Bottom Depth 36" Gravel Depth N/A

☐ New System ☒ Repair ☐ Expansion System Type: I II III IV V VI
System Description: Existing Gravity -25% Reduction
Repair System Description: 1 PPBPS
Maintenance Agreement Required: ☐ YES ☒ NO
☒ GRAVITY ☐ PRESSURE


☒ Residence No. Bedrooms 5
☐ Business No. Persons 10
☐ Other No. Employees
☐ Slab ☒ Crawl Space
☐ Basement w/plumbing ☐ Basement w/o plumbing

Water Supply: ☒ Private ☐ Public ☐ Community


Comments / Conditions: Must keep pool "cut" at least 15ft to Septic System.

The proposed inground swimming pool does not appear to impact the Existing Septic System. Meets setbacks to well & Septic.

INITIAL SITE SKETCH

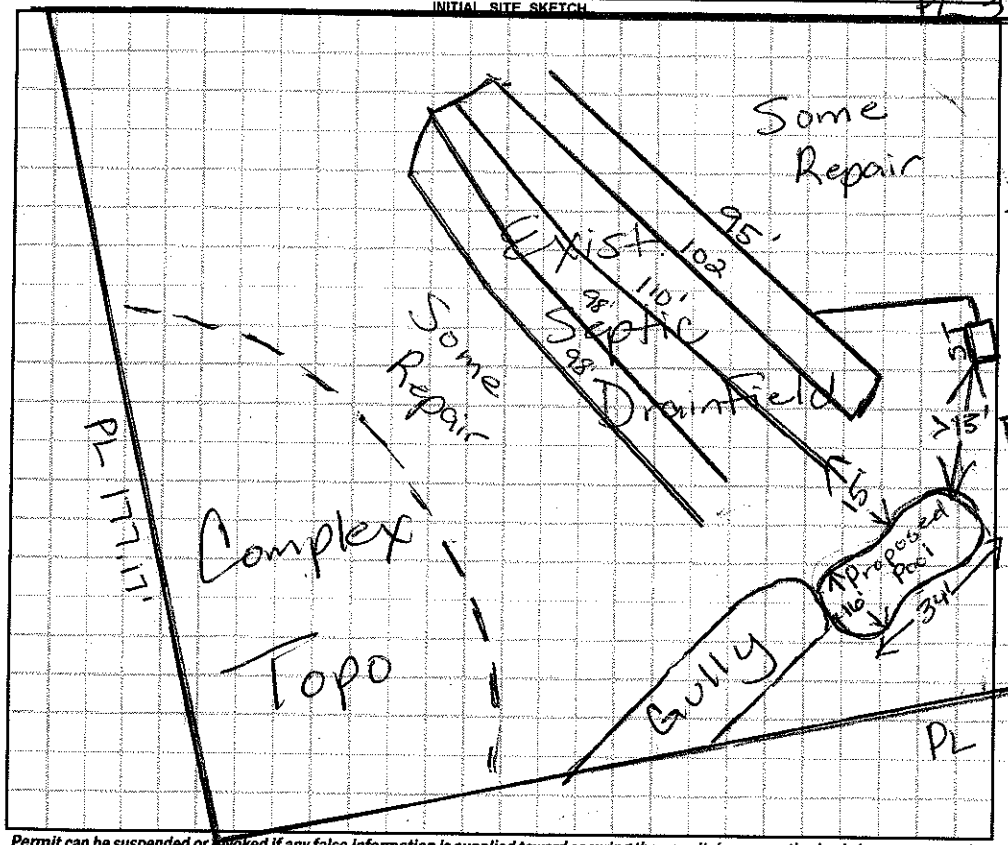


AS BUILT SKETCH

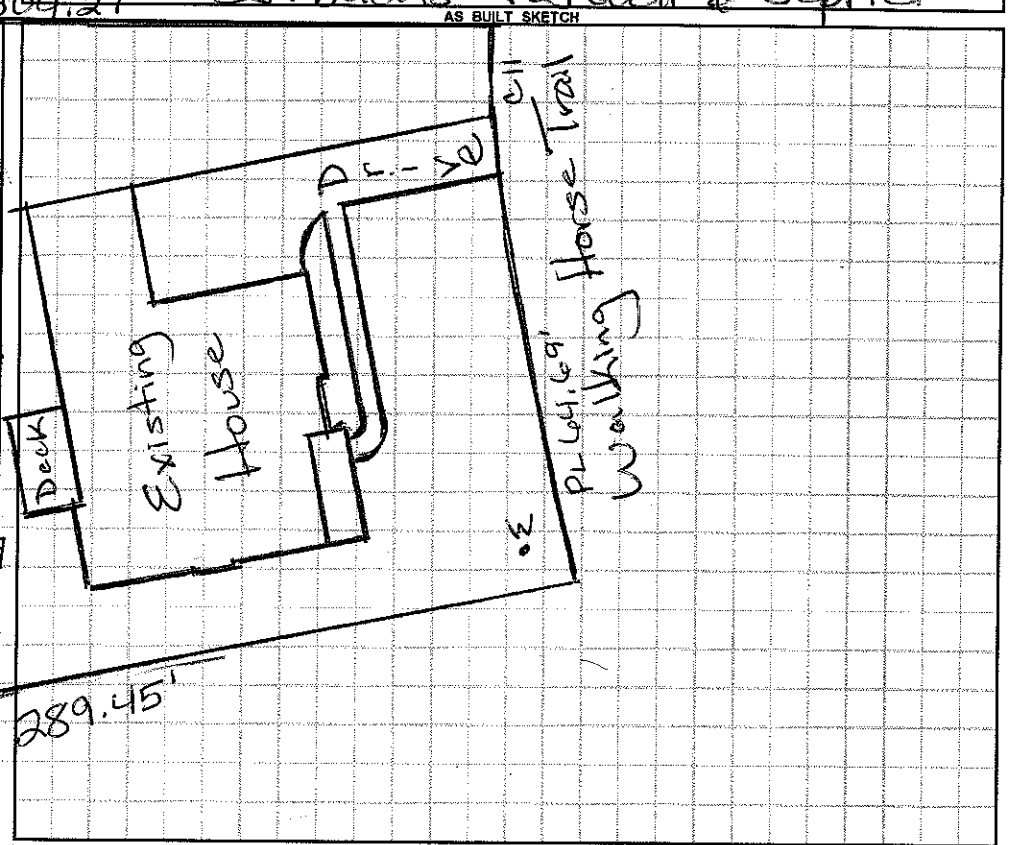


*Permit can be suspended or revoked if any false information is supplied toward securing the permit / any unauthorized changes are made to the site / any unauthorized changes are made in the installation of the system.* **CONTACT A LOCATOR SERVICE PRIOR TO ANY EXCAVATION**


☐ **IMPROVEMENT PERMIT** *with plat valid without expiration.* ☐ **IMPROVEMENT PERMIT** *with site plan valid for 60 mos.* ☐ **AUTHORIZATION TO CONSTRUCT** *valid for period equal to IMPROVEMENT PERMIT--not to exceed 60 mo.*

Owner / Applicant Signature: Date: 12/28/15 Installed by:

IMPROVEMENT PERMIT by: Date: OPERATION PERMIT by: Date:

AUTHORIZATION TO CONSTRUCT by: Date: Existing System Inspected by: RS Date: 12/14/15

Health Dept. Copy - WHITE Applicant (Final Approval) - YELLOW Applicant (Conditional Approval) - PINK

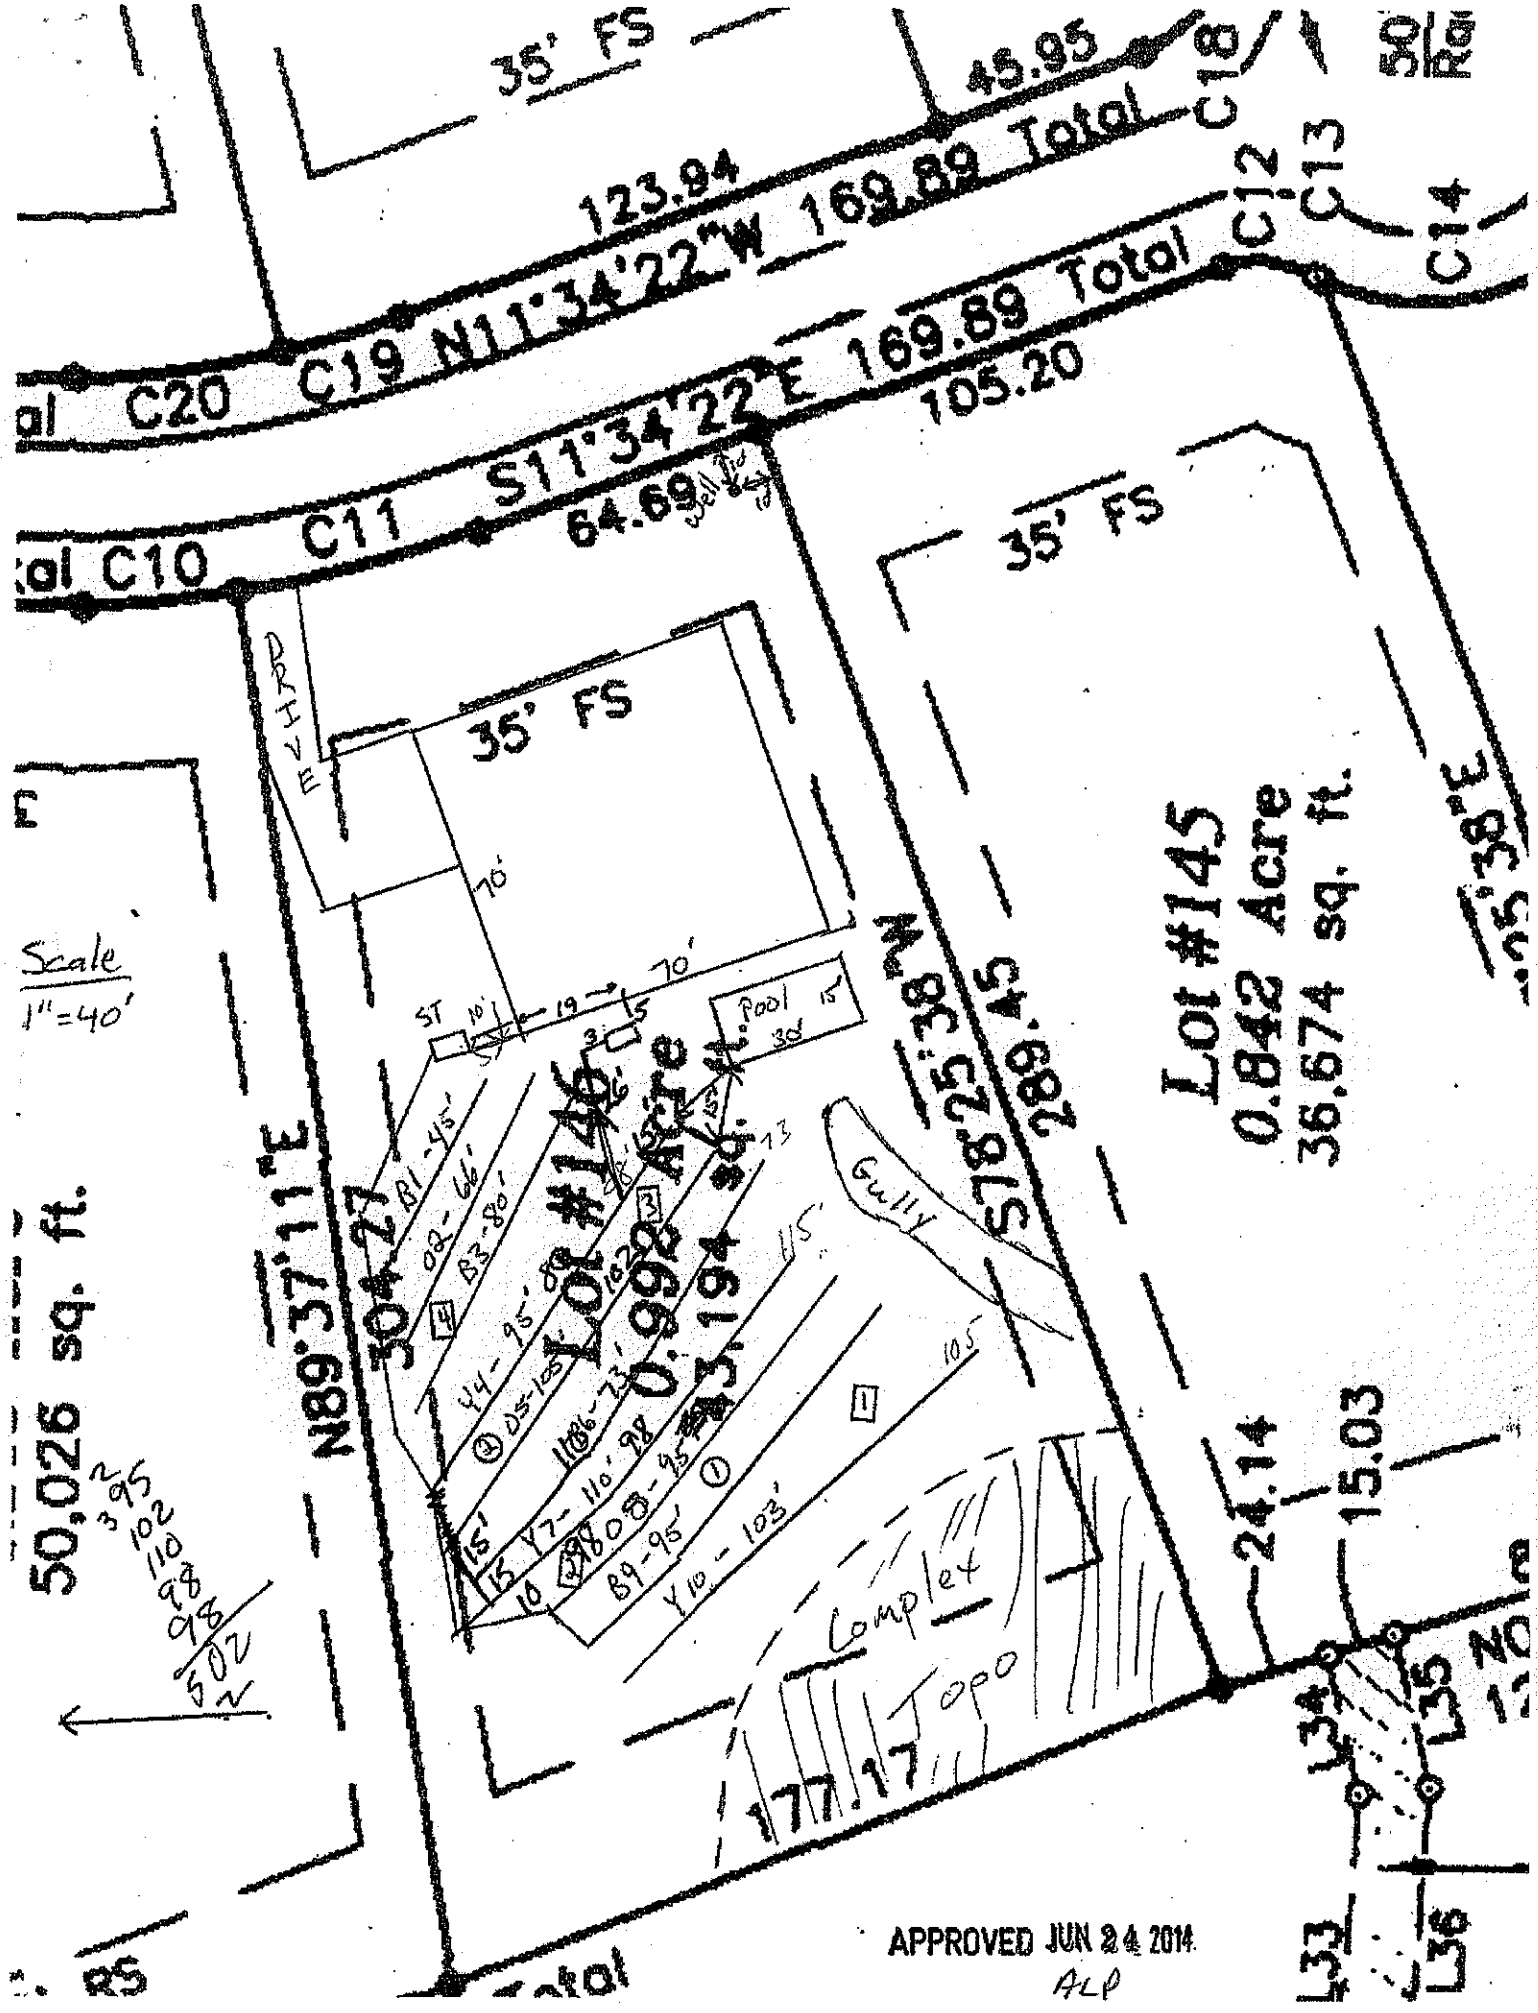
35' FS
45.95
123.94
C18
C13
C12
C14
C20 C19 N11°34'22"W 169.89 Total
S11°34'22"E 169.89 Total
105.20
C10 C11
64.69
35' FS
DRIVE
35' FS
70'
Scale
1"=40'
ST
Pool
30'
Lot #145
0.842 Acre
36,674 sq. ft.
N89°37'11"E
304.27
S78°25'38"W
289.45
1.016 Acre
44,268 sq. ft.
0.992 Acre
43,194 sq. ft.
Gully
50,026 sq. ft.
Complet
Topo
177.17
24.14
15.03
APPROVED JUN 24 2014
ALP