chcs 515.00

IREDELL COUNTY HEALTH DEPARTMENT

STATESVILLE 704-878-5305 MOORESVILLE 704-664-5281

IMPROVEMENT PERMIT / AUTHORIZATION TO CONSTRUCT / OPERATION PERMIT / EXISTING SYSTEM INSPECTION

PERMIT# ~~1505470~~ 207045 PIN# ~~4664284416.130~~ 4664 98-1320 DATE 7/22/08

OWNER OR APPLICANT Niblock Development Co PHONE: Business ~~704~~ Home

ADDRESS 300 McGill Ave. NW Concord NC. 28027 Site: 233 Walking Horse Trail

LOCATION Shearers Rd. TL Anniston TR Burnell TL Walking Horse on Lot 4

SUBDIVISION Anniston BLOCK / SECTION ph 4 LOT 130 LOT AREA 1.251 AC SITE CLASS. PS DESIGN FLOW 600 L.T.A.R. .3

Septic Tank: 1500 Gallons; STB 1014 Date 4-7-15

Pump Tank: 1500 Gallons; PT 302 Date 3-8-15

Pump Make: Model NT52 Serial No.

Nitrification Field: No Fields 1 Square Feet 1500 Linear Feet 500

No Lines 4 Trench Width 36" Max Trench Bottom Depth 36"

☑ New System ☐ Repair ☐ Expansion System Type: I II III IV V VI

System Description: Pump PM 25% Reduction

Repair System Description: LP PPBPS

Maintenance Agreement Required: ☐ Yes ☑ No Initial

☑ House/Mod. Home No. Bedrooms 5

☐ Mobile Home No. Persons

☐ Business No. Employees

☐ Other

Water Supply: ☑ Individual ☐ Public ☐ Community

Gravel Depth N/A ☐ Gravity ☑ Pressure ☐ Slab ☑ Crawl Space ☐ Basement w/plumbing ☐ Basement wo/plumbing

Comments/Conditions: See Attached Plan for Pressure Manifold Specs + Tap sizes.

Comments/Conditions: 8/4/15 Checked tanks lines pressure manifold & set PT pressure

INITIAL SITE SKETCH

See Plan by Rollins Environmental Services, Inc. Soil +

AS BUILT SKETCH

	Date	Initials
Drain Lines Checked	8/4/15	MD
Tanks Checked	8/4/15	MD
Pressure Manifold or Valve Box Checked	8/4/15	MD
Pressure Head Set	8/4/15	MD
Electrical Checked	8/17/15	SC
Floats Set	8/17/15	SC
Alarm Checked	8/17/15	SC
Maintenance Contract Y / N	—	—


Permit can be suspended or revoked if any false information is supplied toward securing the permit/any unauthorized changes are made to the site/any unauthorized changes are made in the installation of the system. Improvement Permit with plat valid without expiration ☐ Improvement Permit with site plan valid for sixty months ☑ Authorization to Construct is valid for a period equal to that of Improvement Permit – not to exceed sixty months.

Signed: date 8-13-08 Installed by: Rowan Septic

Improvement Permit by: Anthony Cobb R.S. date 7/22/08 Operation Permit by: APPROVED AUG 18 2015 date

Authorization to Construct by: APPROVED NOV 20 2014 date Existing System Inspection by: date

HEALTH DEPT. COPY: WHITE OWNER COPY (FINAL): YELLOW OWNER COPY (INITIAL): PINK

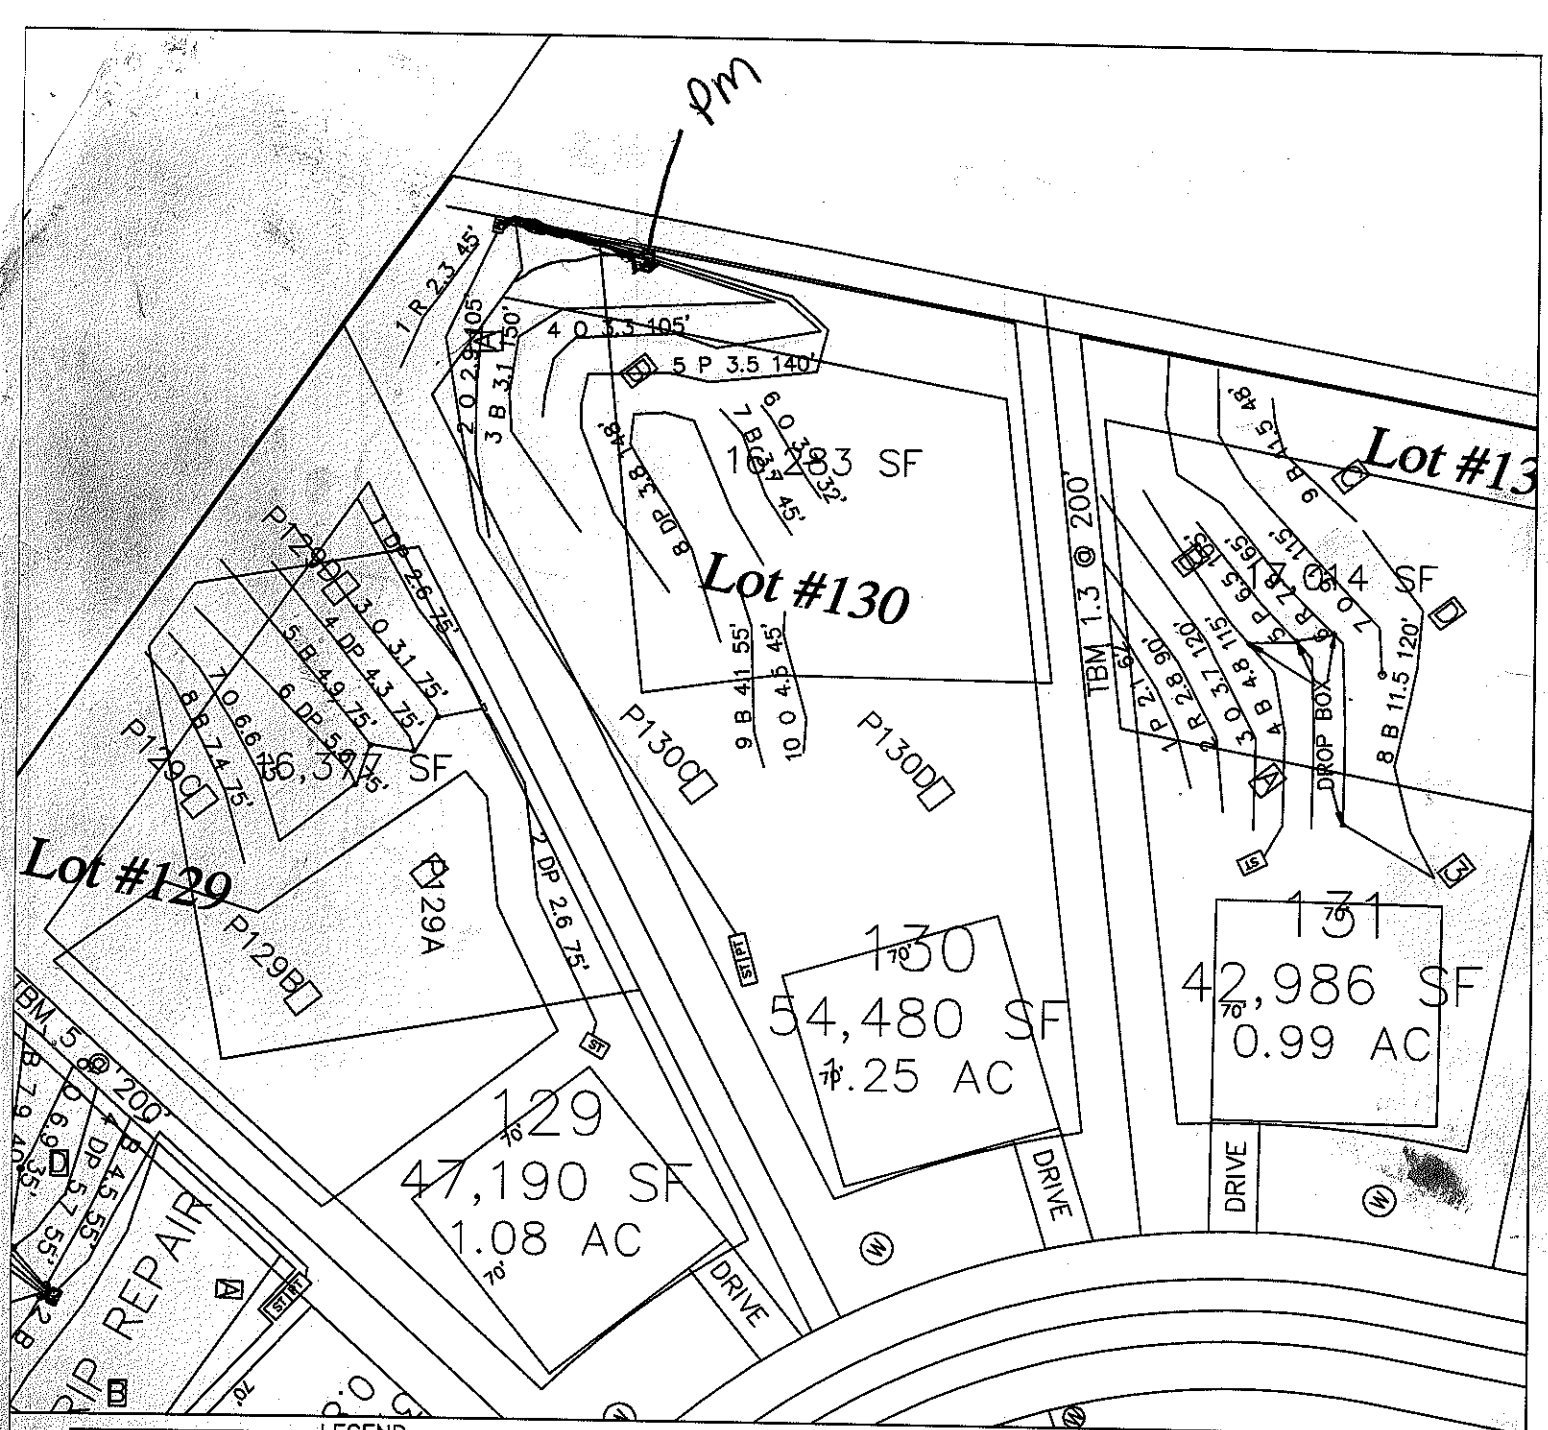

LEGEND

- Areas contain soils with 24 inches or more of useable material and have potential for conventional, modified conventional and low-pressure pipe (lpp) septic systems.
- House Footprint (All 70' x 70')
- System lines.
- Repair lines.
- TBM.
- Well Location.
- [A] RS&ES Pit Location.
- (25) RS&ES Boring Location.
- (28) Health Dept. Pit Location.

GRAPHIC SCALE

1" = 60'

60 0 60 120

FOR PRELIMINARY PLANNING PURPOSES ONLY. ALL LOTS WILL REQUIRE FINAL APPROVAL BY THE COUNTY HEALTH DEPARTMENT ON A LOT BY LOT BASIS. THIS MAP SHOULD BY USED AS A GENERAL GUIDE, SOME ADJUSTMENTS WILL BE NECESSARY IN THE FIELD DUE TO SOIL VARIABILITY AND COMPLEX TOPOGRAPHIC FEATURES. THIS MAP ONLY REFLECTS EXISTING SOIL SUITABILITY FOR ON-SITE SEPTIC TANK SYSTEMS.

PLEASE REFER TO ATTACHED SOIL REPORT FOR ADDITIONAL SITE SPECIFIC INFORMATION

ROLLANS SOIL & ENVIRONMENTAL SERVICES
470 NORTH BROAD ST., SUITE D
MOORESVILLE, NC 28115
PHONE: 704.658.1723 FAX: 704.658.1724
ASHLEY ROLLANS, NC LICENSED SOIL SCIENTIST
MOBILE: (704) 746 - 5046
EMAIL: ROLLANS@WINDSTREAM.NET

MAP TITLE: SITE PLAN & DRAINFIELD AREAS

LOCATION/DATE: SHEARER CHAPEL ROAD, IREDELL COUNTY, NORTH CAROLINA, APRIL 2008

PROJECT NAME: NIBLOCK DEVEOPMENT CORP. / ANNISTON PHASE IV

JOB #: 01-1005
FILE: C:\JOBS\01-1005
PROJECT MGR.: S.A.R.
FIELD WORK: S.A.R.
DRAWN BY: S.A.R.