IREDELL COUNTY HEALTH DEPARTMENT

Statesville Office (704) 878-5305 Mooresville Office (704) 660-3625 BA PERMIT # 207042

IMPROVEMENT PERMIT / AUTHORIZATION TO CONSTRUCT / OPERATION PERMIT / EXISTING SYSTEM

PIN # 4664-98-3313

APPLICANT: Shea Homes APPLICANT ADDRESS: 8688 Corporate Cent. Dr Ste 300 Charlotte NC

SITE ADDRESS: 237 Walking Horse Trl PHONE: ALT. PHONE:

SITE DIRECTIONS: Shearers Rd S, TL on Anniston Hwy, TR on Burnell, TL on Walking Horse, Lot on L past Riverstone

SUBDIVISION: Anniston SECTION: 4 LOT # 131 LOT AREA: 0.987 ac DESIGN FLOW: 600 L.T.A.R.: 0.3

Septic Tank 1500 (gal) STB 1014 Date 5-5-15
Pump Tank 1000 (gal) PT 302 Date 2-4-15
Pump Make Zoeller Model Serial #
Nitrification Fields 1 # Lines 4 Linear Ft: 336'
Trench Width 24" Min. Max. Trench Bottom Depth 36" Gravel Depth N/A

☑ New System ☐ Repair ☐ Expansion System Type: I II III IV V VI
System Description: LP PPBPS
Repair System Description: LP PPBPS
Maintenance Agreement Required: ☐ YES ☐ NO ☐ GRAVITY ☐ PRESSURE

☑ Residence No. Bedrooms 5
☐ Business No. Persons 10
☐ Other No. Employees
☐ Slab ☑ Crawl Space
☐ Basement w/plumbing ☐ Basement w/o plumbing

Water Supply: ☑ Private ☐ Public ☐ Community

Comments / Conditions:

INITIAL SITE SKETCH

SEE DESIGN BY MICHAEL ATHANAS & ASSOCIATES

(Approved 12-18-14) MZP

AS BUILT SKETCH

CHECKED LINES, TANKS, SET 2' PH RA 7-9-15

CHECKED ECDC & AZALEA 8-6-15

Permit can be suspended or revoked if any false information is supplied toward securing the permit / any unauthorized changes are made to the site / any unauthorized changes are made in the installation of the system. **CONTACT A LOCATOR SERVICE PRIOR TO ANY EXCAVATION**

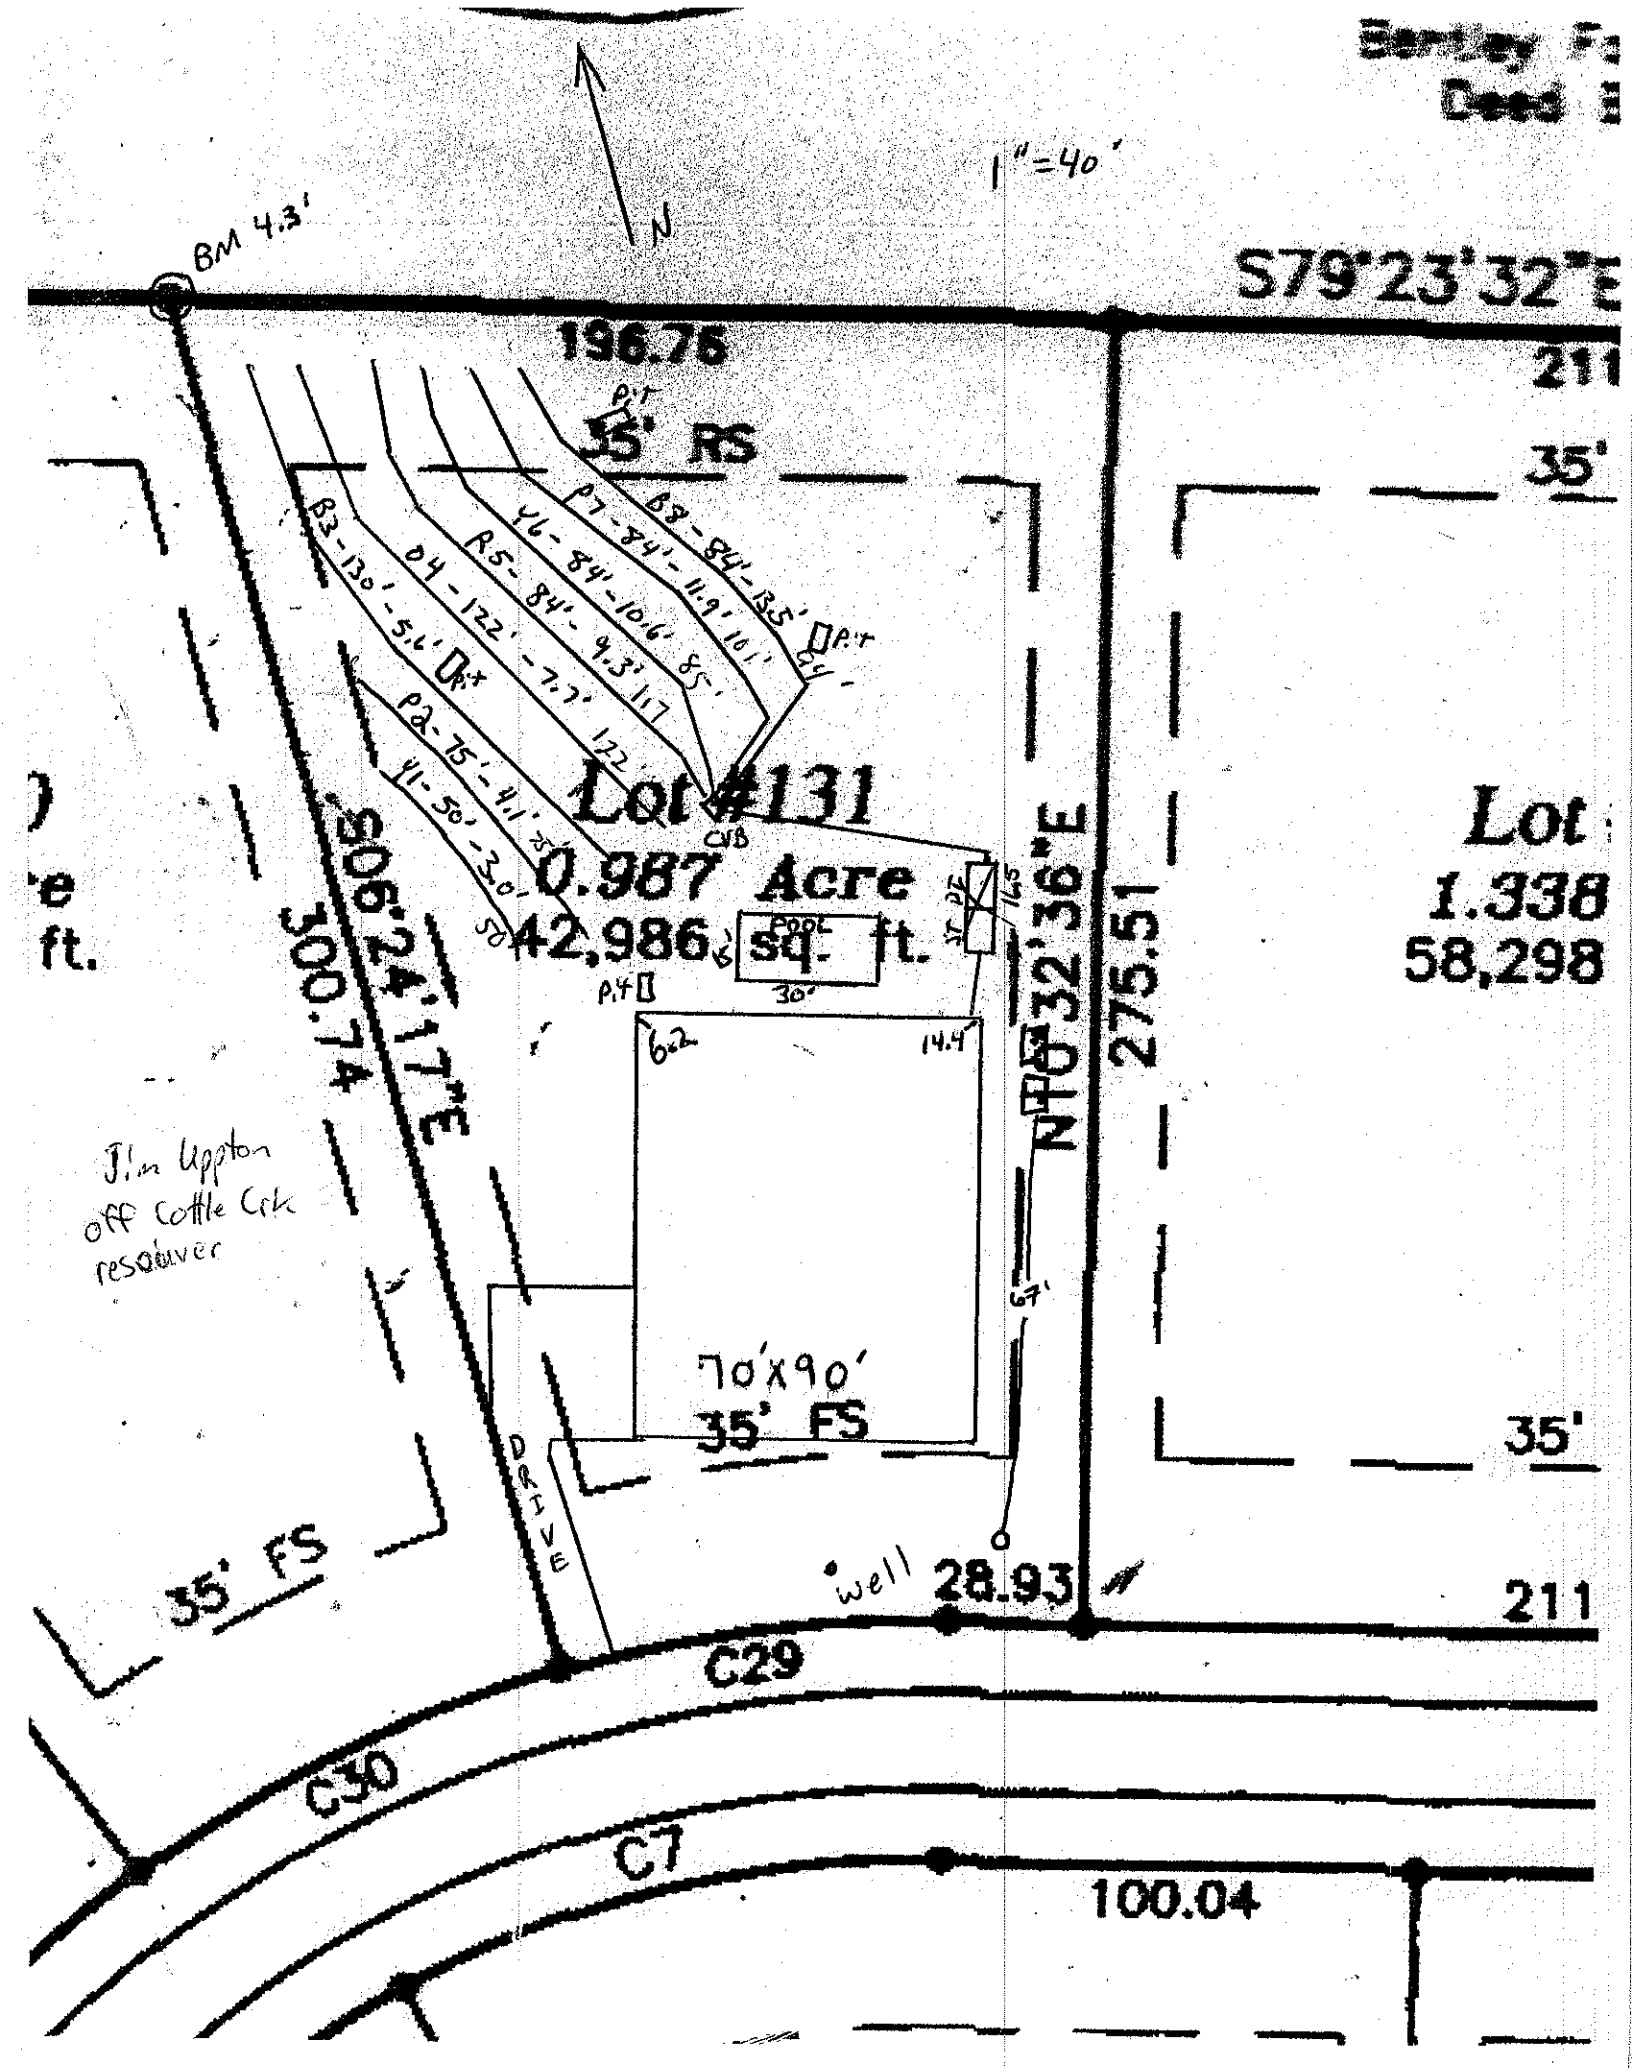
☐ **IMPROVEMENT PERMIT** *with plat valid without expiration.* ☐ **IMPROVEMENT PERMIT** *with site plan valid for 60 mos.* ☒ **AUTHORIZATION TO CONSTRUCT** *valid for period equal to IMPROVEMENT PERMIT--not to exceed 60 mo.*

Owner / Applicant Signature: Date: 1/23/15 Installed by: ROWAN

IMPROVEMENT PERMIT by: Date: 12-18-14 OPERATION PERMIT by: APPROVED Date: AUG 06 2015

AUTHORIZATION TO CONSTRUCT by: Date: 7-9-15 Existing System Inspected by: Date:

Health Dept. Copy - WHITE Applicant (Final Approval) - YELLOW Applicant (Conditional Approval) - PINK


1"=40'
N
BM 4.3'
S79°23'32"E
196.76
211
35' RS
35'
P7-84'-11.9'-10.1'
B3-84'-13.5'
Y6-84'-10.6'-8.5'
R5-84'-9.3'-11.7'
B4-122'-7.7'-12.2'
B3-130'-5.6'
P2-75'-4.1'-3.0'
Y1-50'-3.0'
Lot #131
0.987 Acre
42,986 sq. ft.
POOL
30'
P.I.T.
CVB
306.24'17"E
300.74'
NH 03°32'36"E
275.51'
Lot
1.338
58,298
Jim Upton
off Cattle Crk
reservoir
62'
14.4'
67'
70'x90'
35' FS
DRIVE
well
28.93
211
35' FS
35'
C29
C30
C7
100.04