IREDELL COUNTY HEALTH DEPARTMENT

Statesville Office (704) 878-5305 Mooresville Office (704) 660-3625 PERMIT # 203867 Y

IMPROVEMENT PERMIT / AUTHORIZATION TO CONSTRUCT / OPERATION PERMIT / EXISTING SYSTEM

PIN # 4664-98-4279

APPLICANT: Slea Homes APPLICANT ADDRESS: 8088 Corporate Center Ste 300 Charlotte NC

SITE ADDRESS: 243 Walking Horse PHONE: ALT. PHONE:

SITE DIRECTIONS: Shesrers Rd S, TL on Anniston Way, TR on Burnell, TL on Walking Horse, Lot on L before end

SUBDIVISION: Anniston SECTION: 4 LOT # 132 LOT AREA: 1.338 ac DESIGN FLOW: 480gpd L.T.A.R.: 0.3

Septic Tank 1000 (gal) STB Date
Pump Tank (gal) PT Date
Pump Make Model Serial #
Nitrification Fields 1 # Lines 5 Linear Ft: 400'
Trench Width 36" Max. Trench Bottom Depth 36" Gravel Depth N/A

☑ New System ☐ Repair ☐ Expansion System Type: I II (III) IV V VI
System Description: Gravity 25% Reduction
Repair System Description: LPP RRRS
Maintenance Agreement Required: ☐ YES ☑ NO
☑ GRAVITY ☐ PRESSURE

☑ Residence No. Bedrooms 4
☐ Business No. Persons 8
☐ Other No. Employees
☐ Slab ☑ Crawl Space
☐ Basement w/plumbing ☐ Basement w/o plumbing

Water Supply: ☑ Private ☐ Public ☐ Community

Comments / Conditions: This permit replaces previous permit dated 6-16-14.

INITIAL SITE SKETCH

SEE DESIGN BY MICHAEL ATHANAS & ASSOCIATES

(Approved 11-10-14 AZA)

AS BUILT SKETCH

Permit can be suspended or revoked if any false information is supplied toward securing the permit / any unauthorized changes are made to the site / any unauthorized changes are made in the installation of the system. **CONTACT A LOCATOR SERVICE PRIOR TO ANY EXCAVATION**

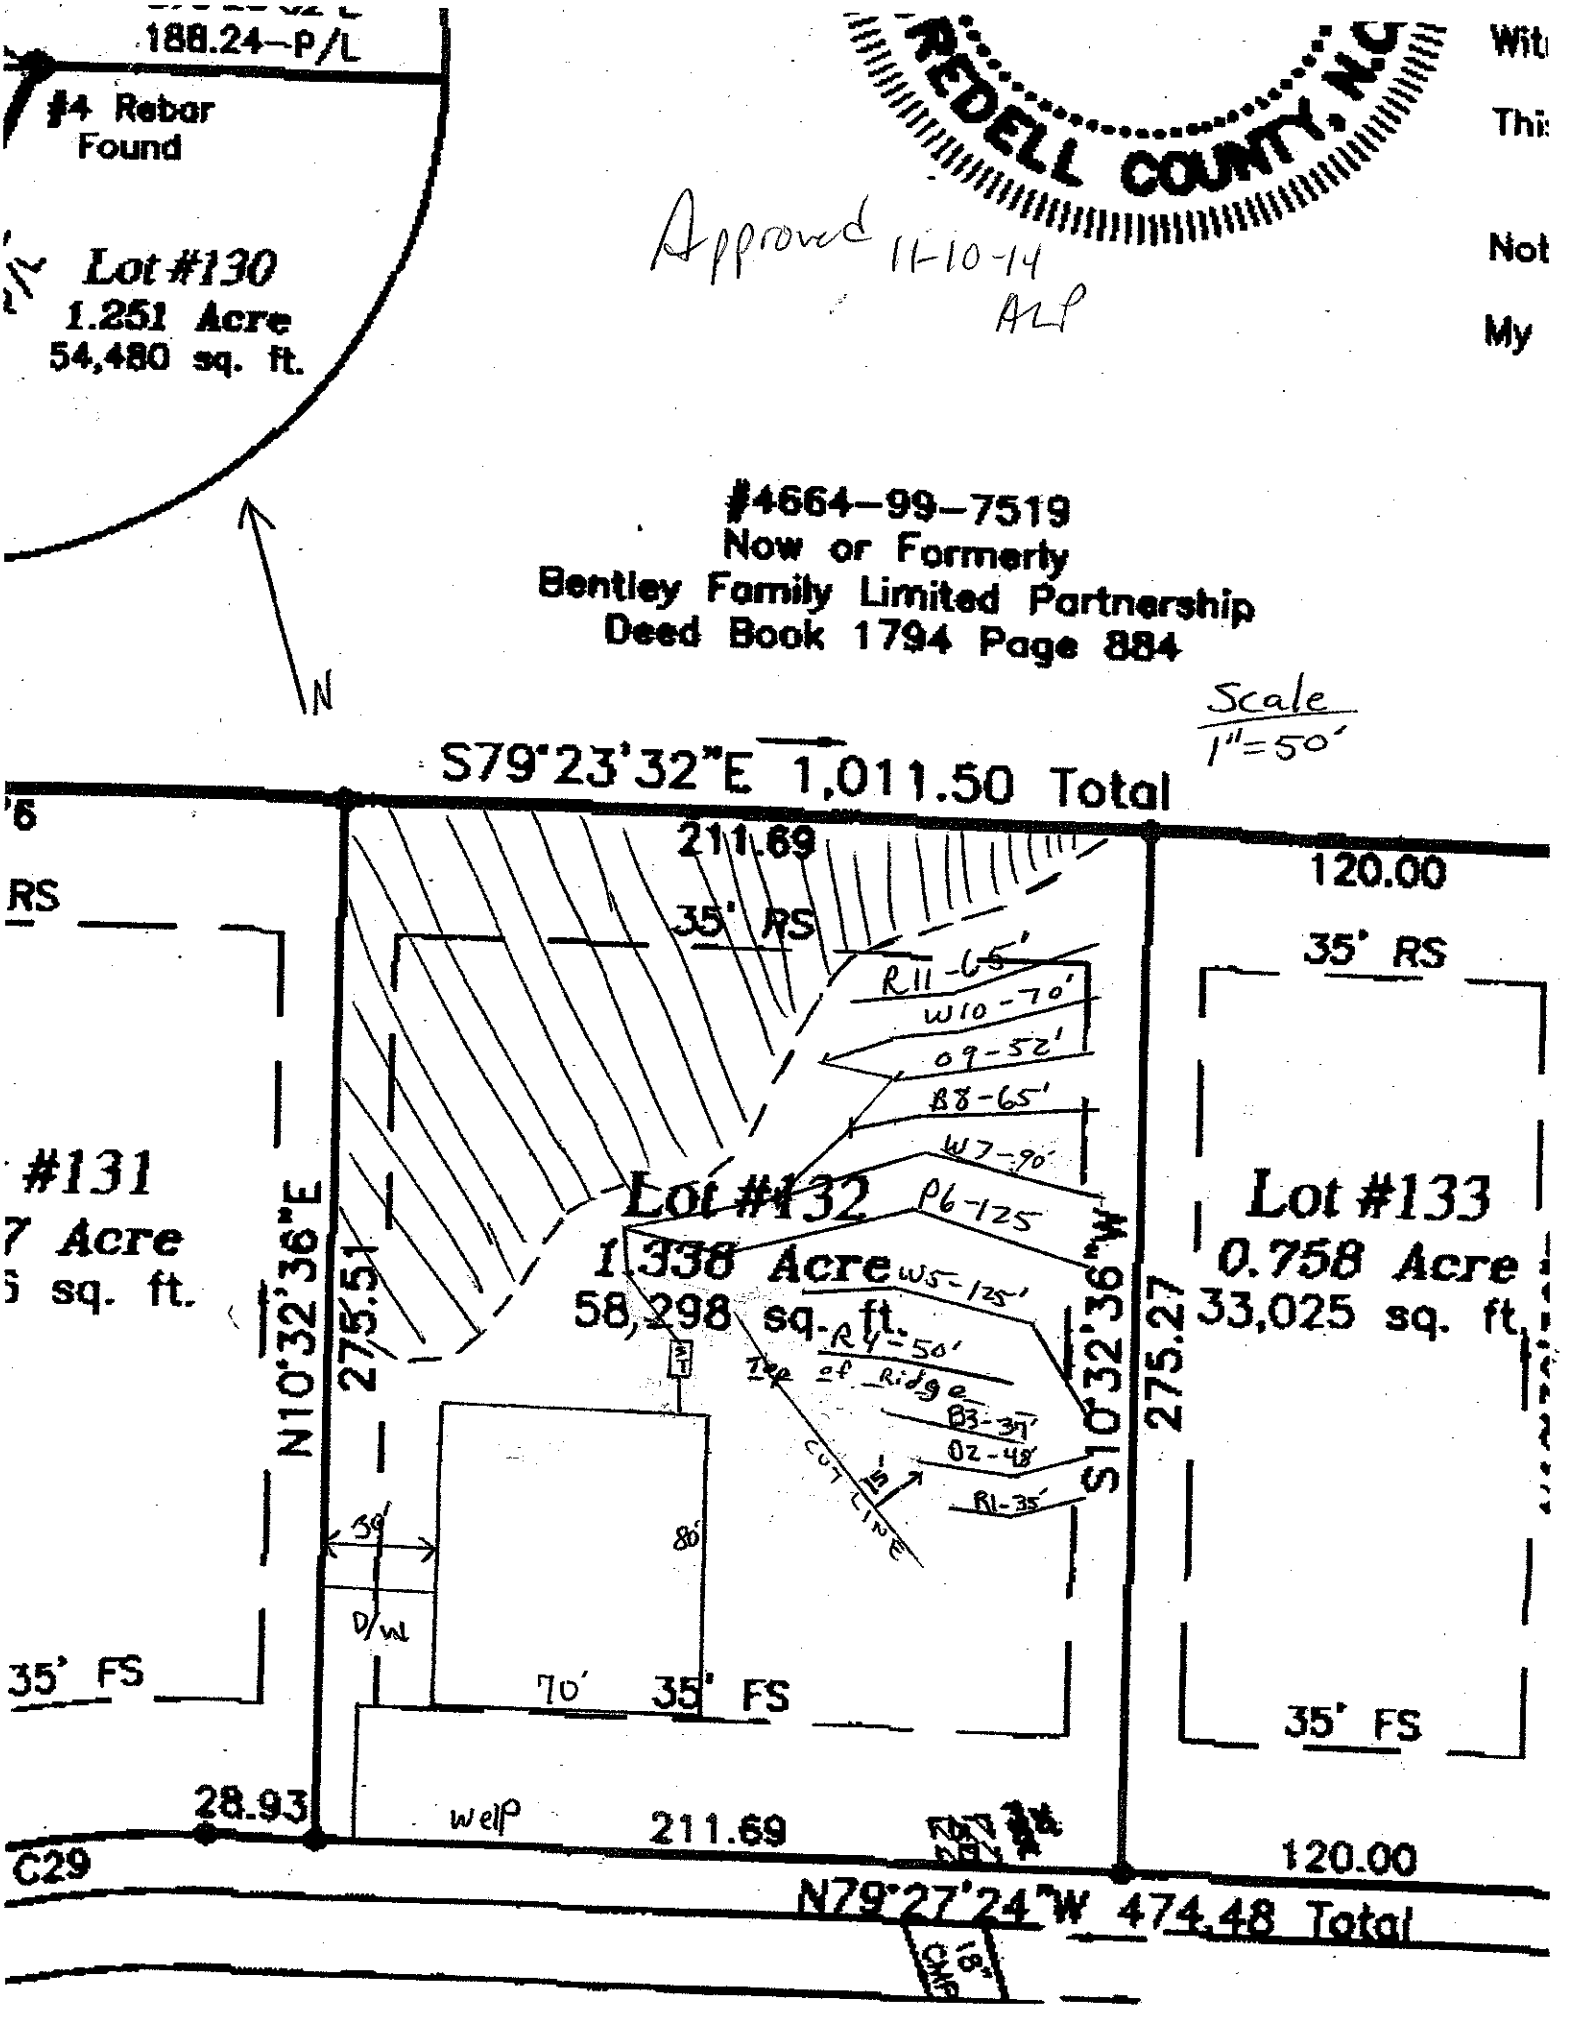
☐ **IMPROVEMENT PERMIT** *with plat valid without expiration.* ☑ **IMPROVEMENT PERMIT** *with site plan valid for 60 mos.* ☑ **AUTHORIZATION TO CONSTRUCT** *valid for period equal to IMPROVEMENT PERMIT--not to exceed 60 mo.*

Owner / Applicant Signature: Stan Pruitt Date: 11/25/14 Installed by: Rowan Septic

IMPROVEMENT PERMIT by: [signature] Date: 11-10-14 OPERATION PERMIT by: Richard Farris Date: 1/7/15

AUTHORIZATION TO CONSTRUCT by: [signature] Date: 11-10-14 Existing System Inspected by: Date:

Health Dept. Copy - WHITE Applicant (Final Approval) - YELLOW Applicant (Conditional Approval) - PINK


188.24–P/L
#4 Rebar Found
Lot #130
1.251 Acre
54,480 sq. ft.
REDELL COUNTY, N.C.
Approved 11-10-14 ALP
#4664–99–7519
Now or Formerly
Bentley Family Limited Partnership
Deed Book 1794 Page 884
N
Scale 1"=50'
S79°23'32"E 1,011.50 Total
211.69
120.00
35' RS
R11-65'
W10-70'
09-52'
B8-65'
W7-90'
P6-125
W5-125'
R4-50'
Top of Ridge
B3-37'
02-48'
R1-35'
CUT LINE
Lot #131
7 Acre
5 sq. ft.
Lot #132
1.338 Acre
58,298 sq. ft.
Lot #133
0.758 Acre
33,025 sq. ft.
N10°32'36"E 275.51
S10°32'36"W 275.27
30'
80'
D/W
70'
35' FS
28.93
well
211.69
120.00
C29
N79°27'24"W 474.48 Total
18" CMP