IREDELL COUNTY HEALTH DEPARTMENT

Statesville Office (704) 878-5305 Mooresville Office (704) 660-3625 PERMIT # 25177

IMPROVEMENT PERMIT / AUTHORIZATION TO CONSTRUCT / OPERATION PERMIT / EXISTING SYSTEM

PIN # 4664-98-4110 7296

APPLICANT: SHEA HOMES APPLICANT ADDRESS: 8088 CORPORATE CENTER DR CHARLOTTE

SITE ADDRESS: 259 WALKING HORSE TR. PHONE: ALT. PHONE:

SITE DIRECTIONS: ANNISTON WAY, TR BURNELL, TL WALKING HORSE, ON L

SUBDIVISION: ANNISTON SECTION: LOT # 134 LOT AREA: 1.034 AC DESIGN FLOW: 600 L.T.A.R.: 3

Septic Tank 1500 (gal) STB 1014 Date 10-8-14
Pump Tank (gal) PT Date
Pump Make Model Serial #
Nitrification Fields 1 # Lines 4 Linear Ft: 500'
Trench Width 36" Max. Trench Bottom Depth 30" Gravel Depth —

☒ New System ☐ Repair ☐ Expansion System Type: I II (III) IV V VI
System Description: 25% REDUCTION
Repair System Description: PANEL BLOCK
Maintenance Agreement Required: ☐ YES ☒ NO
☒ GRAVITY ☐ PRESSURE

☒ Residence No. Bedrooms 5
☐ Business No. Persons
☐ Other No. Employees
☐ Slab ☒ Crawl Space
☒ Basement w/plumbing ☐ Basement w/o plumbing


Water Supply: ☒ Private ☐ Public ☐ Community

Comments / Conditions:

INITIAL SITE SKETCH

SEE PLAN FROM MICHAEL ATHANAS & ASSOCIATES

AS BUILT SKETCH

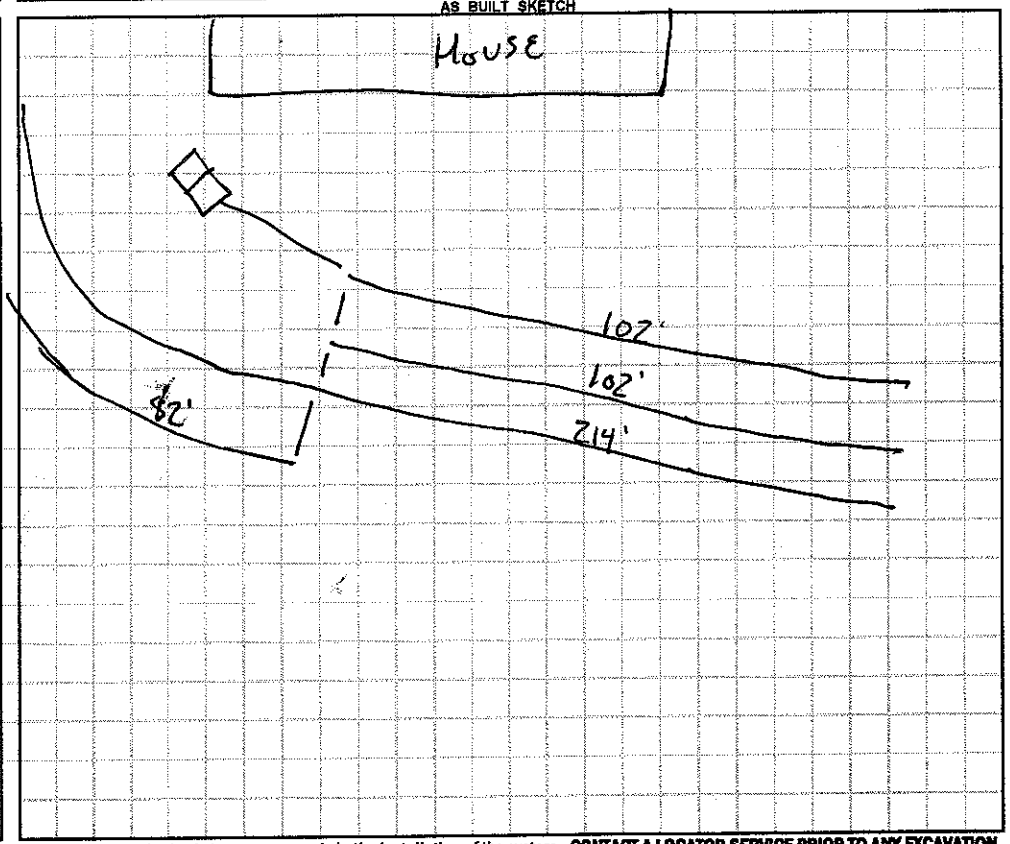

Permit can be suspended or revoked if any false information is supplied toward securing the permit / any unauthorized changes are made to the site / any unauthorized changes are made in the installation of the system. **CONTACT A LOCATOR SERVICE PRIOR TO ANY EXCAVATION**

☐ **IMPROVEMENT PERMIT** *with plat valid without expiration.* ☐ **IMPROVEMENT PERMIT** *with site plan valid for 60 mos.* ☒ **AUTHORIZATION TO CONSTRUCT** *valid for period equal to IMPROVEMENT PERMIT--not to exceed 60 mo.*


Owner / Applicant Signature: Date: 4/6/15 Installed by: ROWAN SEPTIC

IMPROVEMENT PERMIT by: Date: APPROVED MAR 2 6 2015 OPERATION PERMIT by: Date: 4-24-15

AUTHORIZATION TO CONSTRUCT by: Date: APPROVED MAR 2 6 2015 Existing System Inspected by: Date:

Health Dept. Copy - WHITE Applicant (Final Approval) - YELLOW Applicant (Conditional Approval) - PINK

Existi
Beac

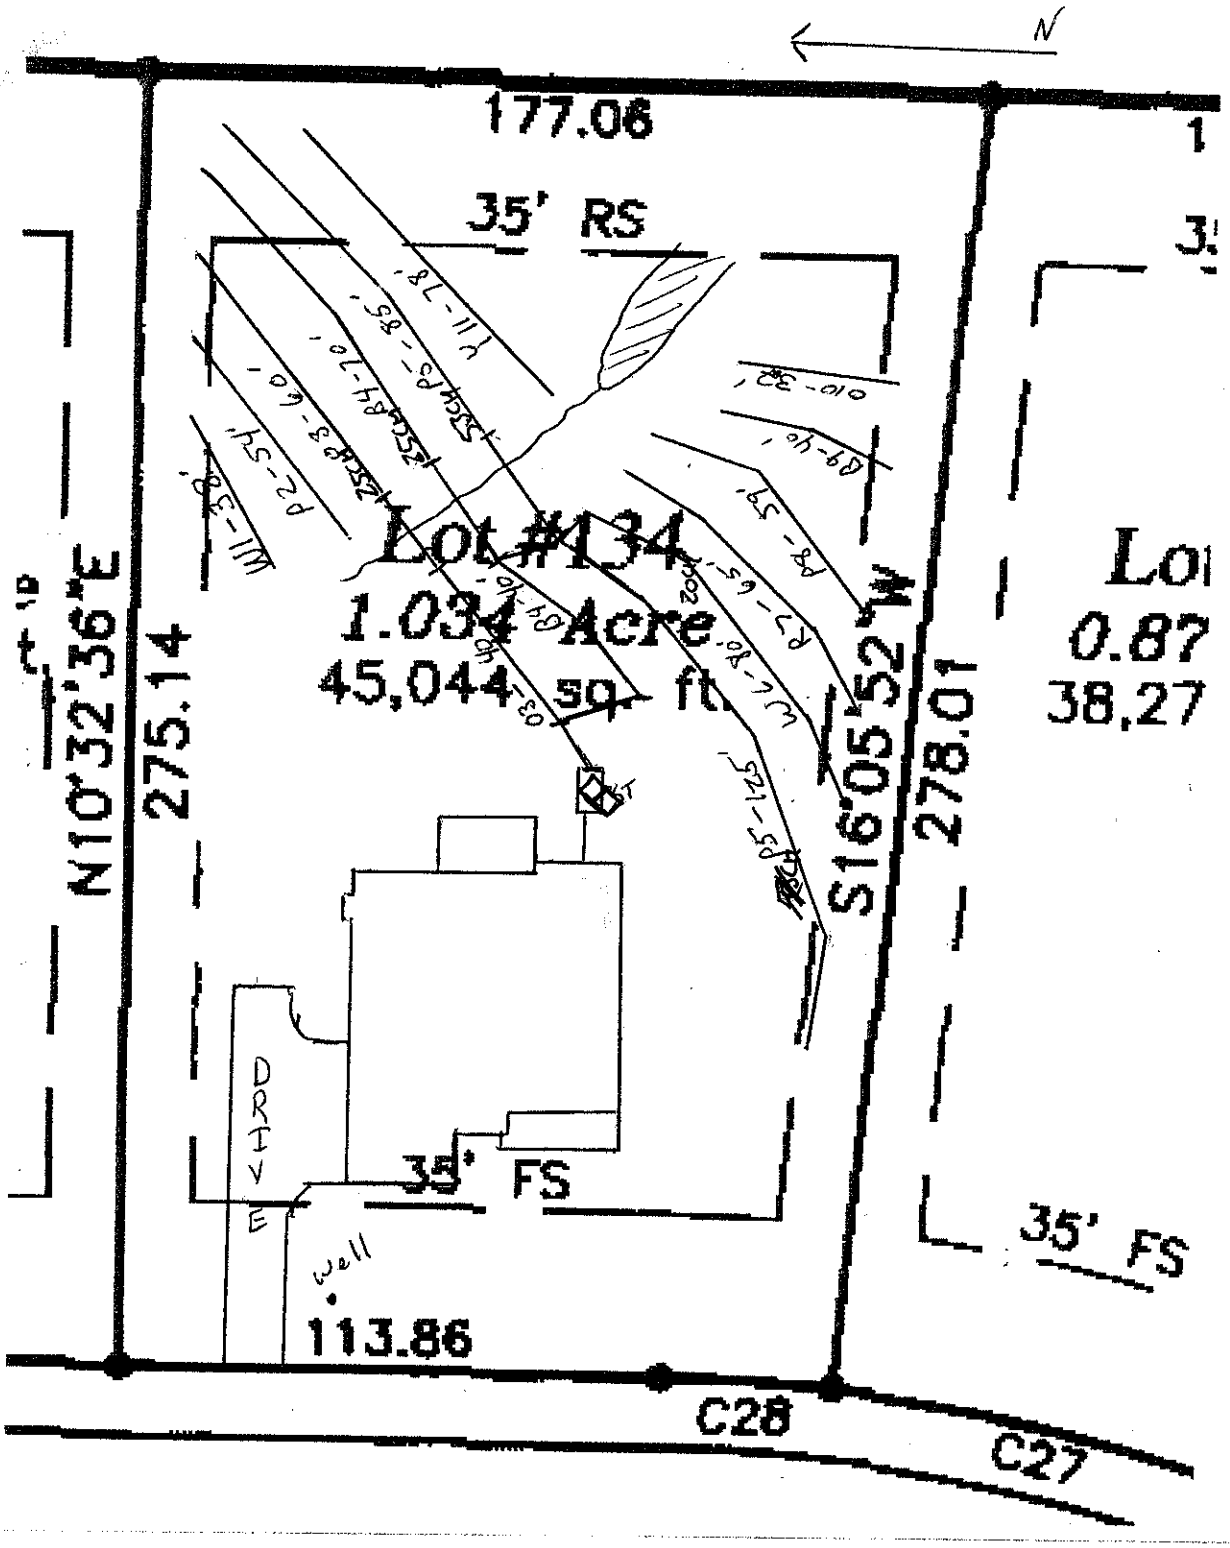

Scale
1"=40'