4

IREDELL COUNTY HEALTH DEPARTMENT

Statesville Office (704) 878-5305 Mooresville Office (704) 660-3625 PERMIT # 205179

IMPROVEMENT PERMIT / AUTHORIZATION TO CONSTRUCT / OPERATION PERMIT / EXISTING SYSTEM

PIN # 4664-98-9232.000

APPLICANT: Shea Homes APPLICANT ADDRESS: 8088 Corporate Center Dr. Ste 300 Charlotte NC

SITE ADDRESS: 265 Walking Horse Trl. Davidson NC PHONE: 704-310-1832 ALT. PHONE: —

SITE DIRECTIONS: Shearers Rd. S, TL Anniston Hwy TR Burgess, TL Walking Horse, Site on L

SUBDIVISION: Anniston SECTION: 4 LOT # 135 LOT AREA: .87 Acre DESIGN FLOW: 600 GPD L.T.A.R.: .275

Septic Tank 1500 (gal) STB Poly Date 7/1/16
Pump Tank (gal) PT Date
Pump Make Model Serial #
Nitrification Fields 1 # Lines 4 Linear Ft: 545
Trench Width 36" Max. Trench Bottom Depth 24"-36" Gravel Depth N/A

☒ New System ☐ Repair ☐ Expansion System Type: I II III IV V VI
System Description: 25% Reduction - Gravity
Repair System Description:
Maintenance Agreement Required: ☐ YES ☒ NO
☒ GRAVITY ☐ PRESSURE

☒ Residence No. Bedrooms 5
☐ Business No. Persons 10
☐ Other No. Employees
☐ Slab ☐ Crawl Space
☒ Basement w/plumbing ☐ Basement w/o plumbing

Water Supply: ☒ Private ☐ Public ☐ Community

Comments / Conditions: Any Well Must Be 100' From Septic System. Divert Drainage Around Drainfield As Shown on Attached Design.

116' PVC To Drainfield
Top Line Center Fed - See Drawing

INITIAL SITE SKETCH

See Attached Approved Design By Michael Thomas Associates

Dated APPROVED FEB 2 2 2016

AS BUILT SKETCH

Permit can be suspended or revoked if any false information is supplied toward securing the permit / any unauthorized changes are made to the site / any unauthorized changes are made in the installation of the system. **CONTACT A LOCATOR SERVICE PRIOR TO ANY EXCAVATION**

☐ **IMPROVEMENT PERMIT** *with plat valid without expiration.* ☒ **IMPROVEMENT PERMIT** *with site plan valid for 60 mos.* ☐ **AUTHORIZATION TO CONSTRUCT** *valid for period equal to IMPROVEMENT PERMIT--not to exceed 60 mo.*

Owner / Applicant Signature: Date: 3-16-16

IMPROVEMENT PERMIT by: APPROVED Date: FEB 2 2 2016

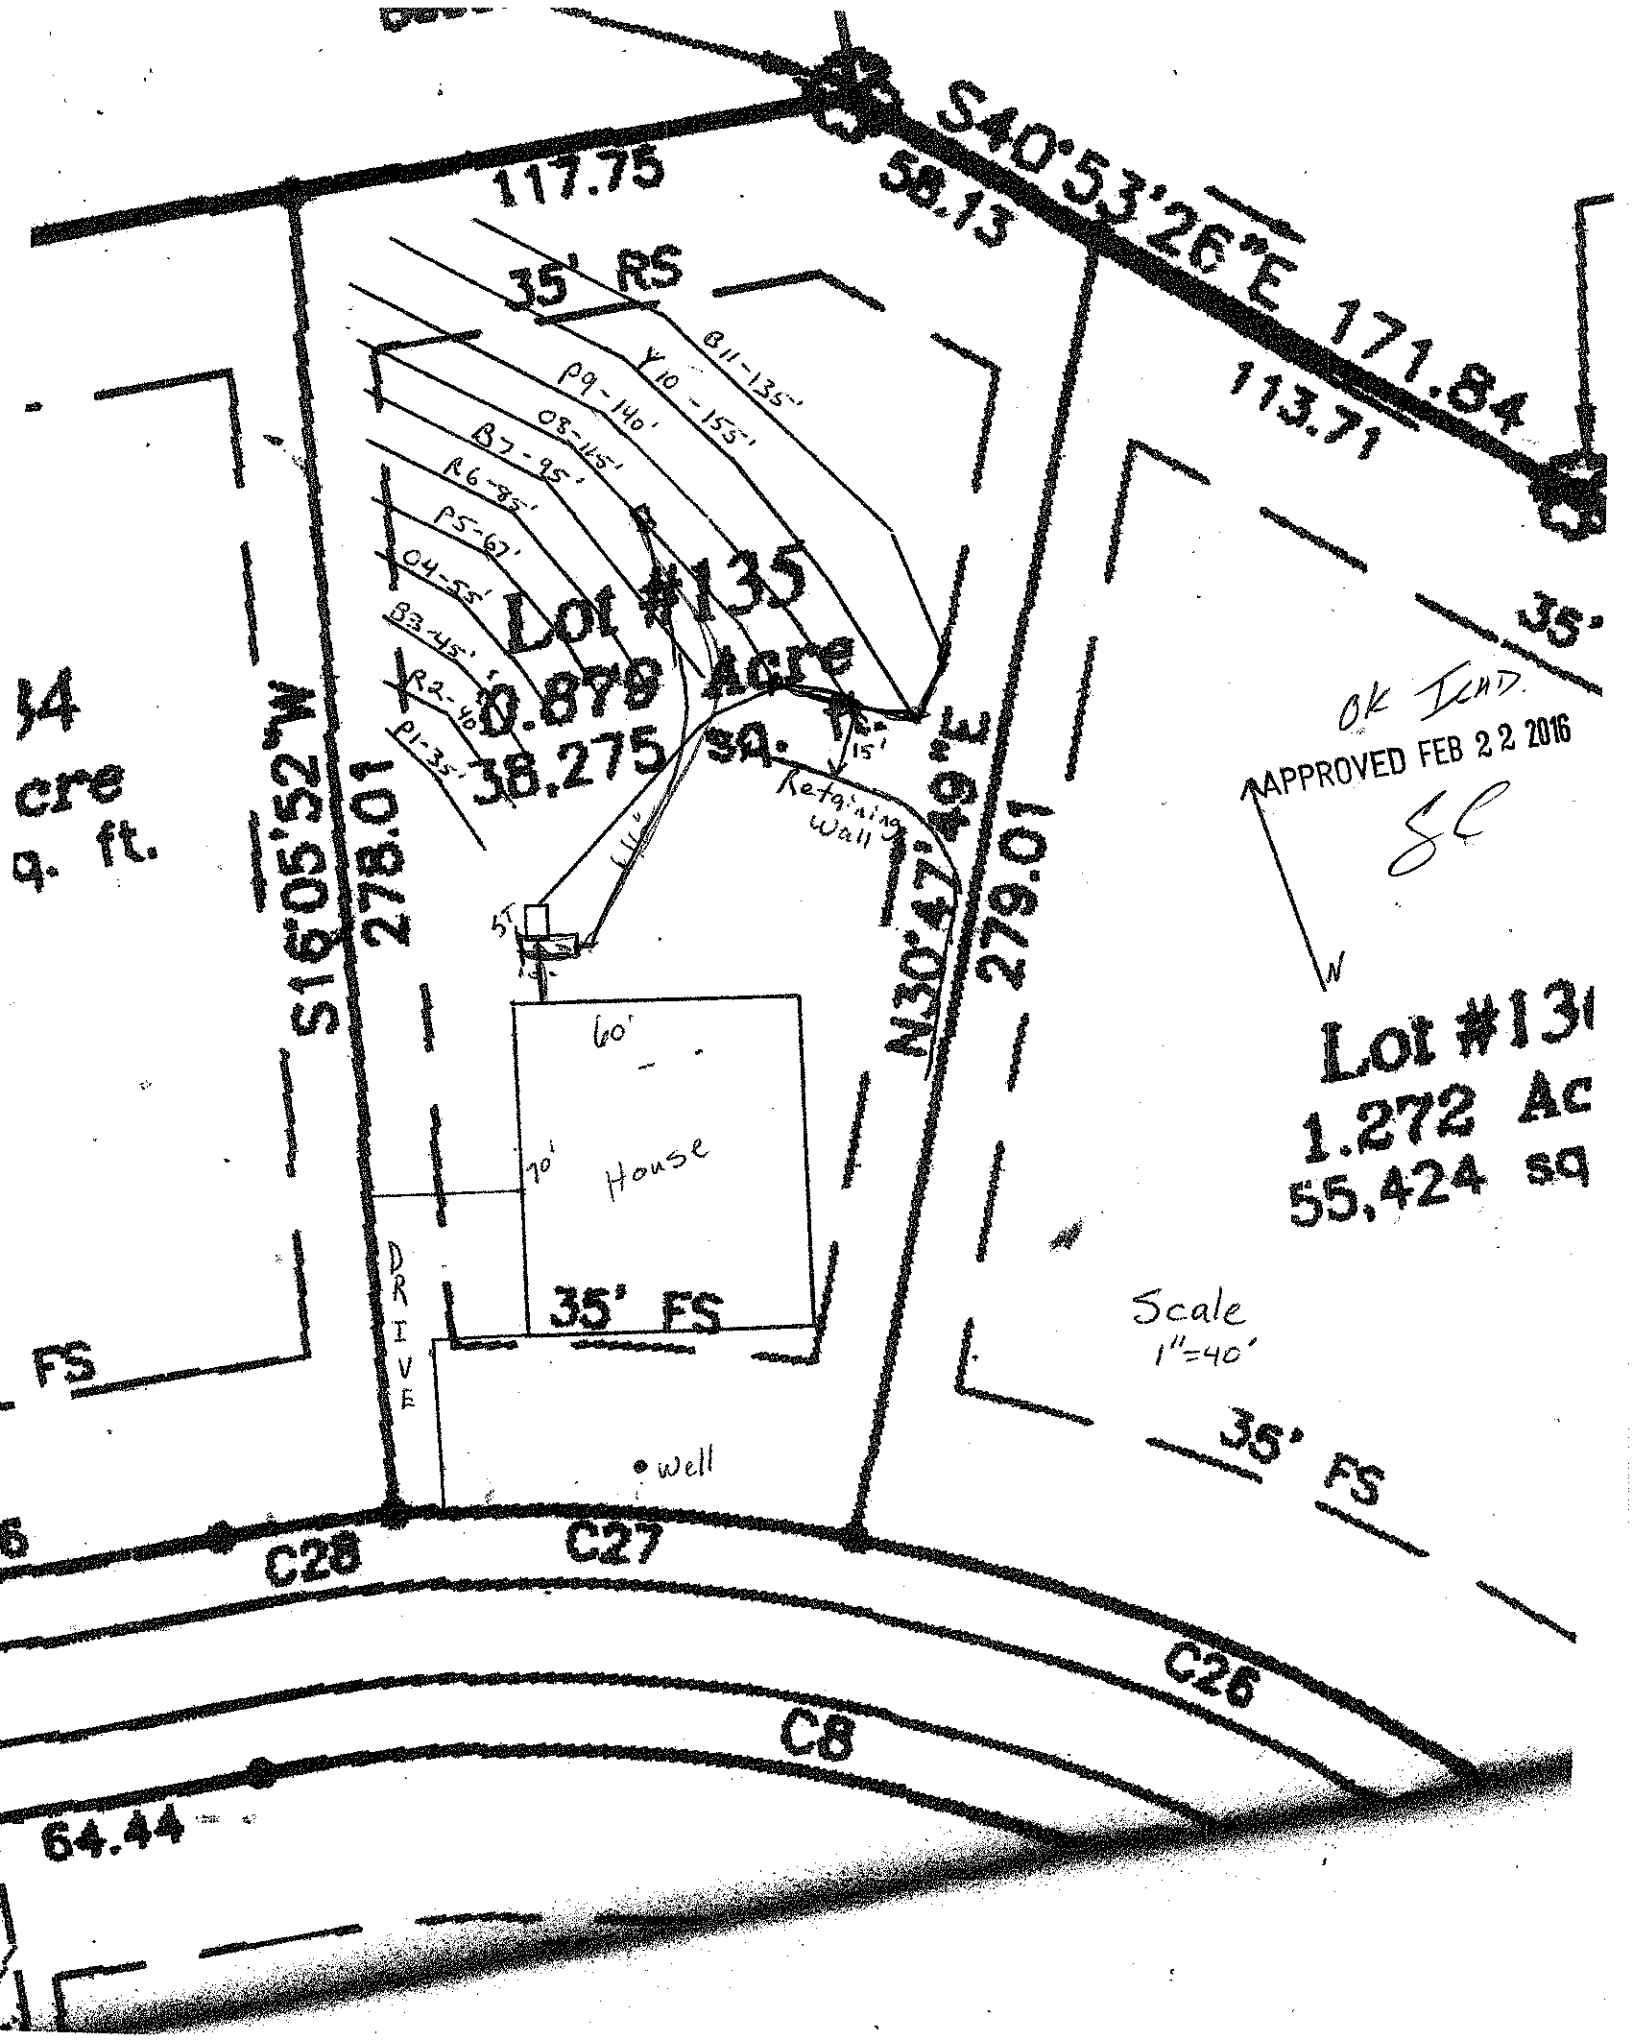
AUTHORIZATION TO CONSTRUCT by: APPROVED Date: MAR 2 2 2016

Installed by: Rowan Septic

OPERATION PERMIT by: W Sparks Date: 8/24/16

Existing System Inspected by: Date:

Health Dept. Copy - WHITE Applicant (Final Approval) - YELLOW Applicant (Conditional Approval) - PINK


S40°53'26"E 171.84
117.75
58.13
35' RS
113.71
B11-135'
Y10-155'
P9-140'
O8-115'
B7-95'
R6-85'
P5-67'
O4-55'
B3-45'
R2-40'
P1-35'
Lot #135
0.879 Acre
38,275 sq. ft.
Retaining Wall
15'
5T
S16°05'52"W
278.01
N30°47'09"E
279.01
60'
70'
House
35' FS
DRIVE
well
C28
C27
C26
C8
64.44
FS
35'
OK IMD.
APPROVED FEB 22 2016
SC
N
Lot #13
1.272 Ac
55,424 sq
Scale
1"=40'
36' FS