IREDELL COUNTY HEALTH DEPARTMENT

STATESVILLE 704-878-5305 ∅ MOORESVILLE 704-664-5281

IMPROVEMENT PERMIT / AUTHORIZATION TO CONSTRUCT / OPERATION PERMIT / EXISTING SYSTEM INSPECTION

PERMIT# 125015 PIN# 4664-98-7703 4664999854 DATE 11/30/04

OWNER OR CONTRACTOR Patty Bentley PHONE: Business _____ Home 704-525-1375

ADDRESS 1248 Perth Rd Troutman NC 28166

LOCATION Hwy 35, TR Johnson Dairy Rd, on Lt Just past 2nd Bridge. #328

SUBDIVISION _____ BLOCK / SECTION _____ LOT _____ LOT AREA 1.27 Ac SITE CLASS. PS DESIGN FLOW 360 L.T.A.R. 0.3

Septic Tank: 1000 Gallons; STB 312 Date _____
Pump Tank: _____ Gallons; PT _____ Date _____
Pump Make: _____ Model _____ Serial No. _____
Nitrification Field: No Fields 1 Square Feet 1200 Linear Feet 400'
No Lines 3@133' Trench Width 36" Max Trench Bottom Depth 36" Gravel Depth 12"

☒ New System ☐ Repair System Type: I, (II), III, IV, V, VI
System Description: Conventional
Repair System Description: Same
Maintenance Agreement Required: ☐ Yes ☒ No


☒ House/Mod. Home No. Bedrooms 3
☐ Mobile Home No. Bathrooms ____
☐ Business No. Employees ____
☐ Other _____
☐ Slab ☐ Crawl Space ☐ Basement w/plumbing ☐ Basement wo/plumbing

Water Supply:
☒ Individual
☐ Public
☐ Community

Comments:/Conditions:

Not to scale

INITIAL SITE SKETCH

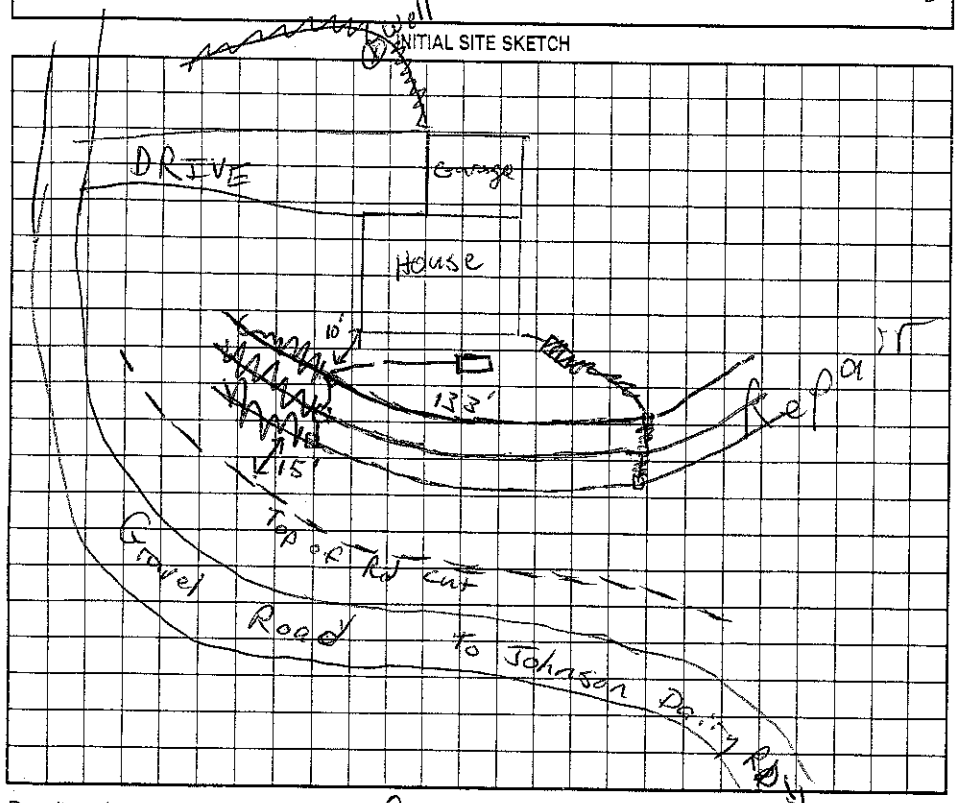

Comments:/Conditions:

AS BUILT SKETCH

Installed As Drawn

Permit can be suspended or revoked if any false information is supplied toward securing the permit/any unauthorized changes are made to the site/any unauthorized changes are made in the installation of the system. Improvement Permit with plat valid without expiration. Improvement Permit with site plan valid for sixty months. Authorization to Construct is valid for a period equal to that of Improvement Permit – not to exceed sixty months.

Signed: Patty Bentley date 12-7-04

Improvement Permit by: RS date 11/30/04

Authorization to Construct by: RS date 11/30/04

Installed by: FS Ervin

Operation Permit by: RS date 4/15/05

Existing System Inspection by: _____ date _____

HEALTH DEPT. COPY: WHITE OWNER COPY (FINAL): YELLOW OWNER COPY (INITIAL): PINK