IREDELL COUNTY HEALTH DEPARTMENT

STATESVILLE 704-878-5305 MOORESVILLE 704-664-5281

IMPROVEMENT PERMIT / AUTHORIZATION TO CONSTRUCT / OPERATION PERMIT / EXISTING SYSTEM INSPECTION

PERMIT# 100522 PIN# 4664 98 7575 DATE 6/1/01

OWNER OR CONTRACTOR Patty & Bentley PHONE: Business Home 704-528-1375

ADDRESS 1248 Perth Rd. Troutman NC. 28166

LOCATION Shearers Rd. South TL Johnson Dairy Rd., TR at Bentley sign follow drive to the road on (L)

SUBDIVISION BLOCK / SECTION LOT LOT AREA 139.33 AC SITE CLASS. PS DESIGN FLOW 360 L.T.A.R. .3

Septic Tank: 1000 Gallons; STB 1007 Date 10-6-00
Pump Tank: Gallons; PT Date
Pump Make: Model Serial No.
Nitrification Field: No Fields 1 Square Feet 1200 Linear Feet 400
No Lines 4@100' Trench Width 3' Max Trench Bottom Depth 3' Gravel Depth 12"

[X] New System [ ] Repair System Type: I (II) III. IV. V. VI
System Description: New Conventional
Repair System Description: Same
Maintenance Agreement Required: [ ] Yes [X] No


[X] House/Mod. Home No. Bedrooms 3
[ ] Mobile Home No. Bathrooms 2
[ ] Business No. Employees
[ ] Other
[ ] Slab [X] Crawl Space [ ] Basement w/plumbing [ ] Basement wo/plumbing

Water Supply: [X] Individual [ ] Public [ ] Community

Comments:/Conditions:


Comments:/Conditions: Filter installed
Speed levelers installed
New Hse will be Out of Power line
Ready daylight basement.

INITIAL SITE SKETCH

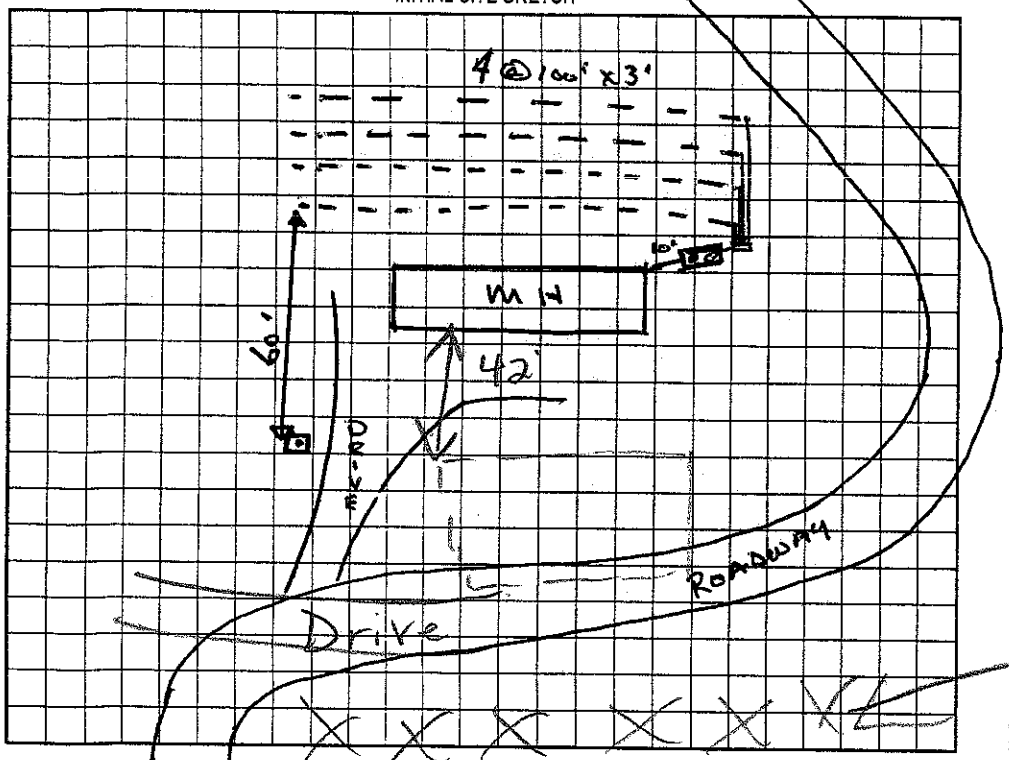

AS BUILT SKETCH

Installed as Drawn
4-Conv lines

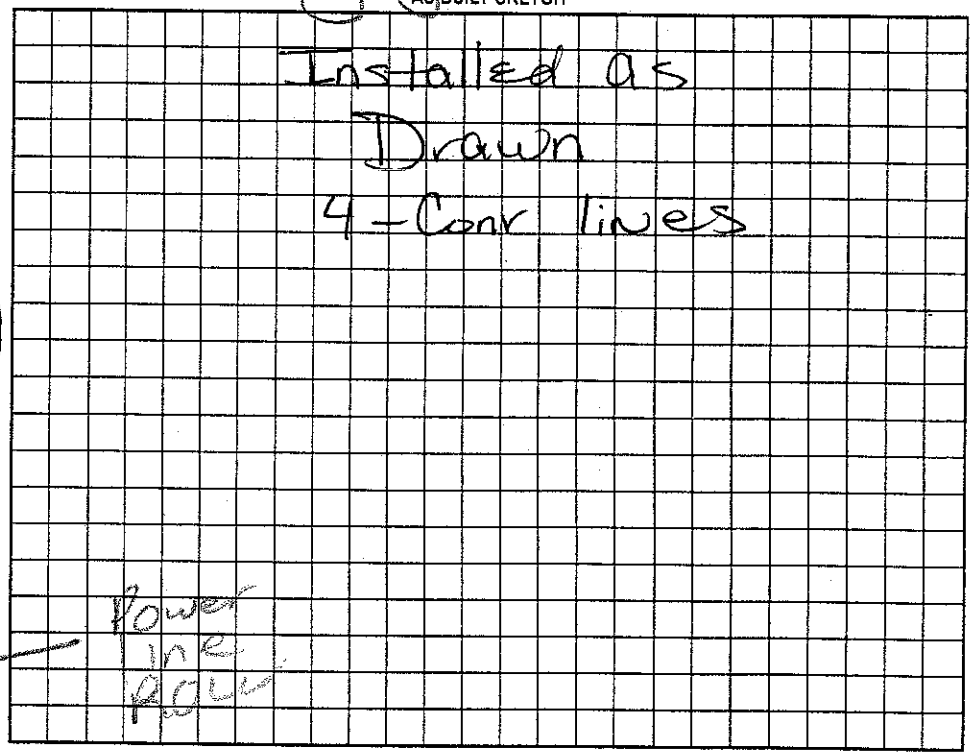

Permit can be suspended or revoked if any false information is supplied toward securing the permit/any unauthorized changes are made to the site/any unauthorized changes are made in the installation of the system. Improvement Permit with plat valid without expiration. Improvement Permit with site plan valid for sixty months. Authorization to Construct is valid for a period equal to that of Improvement Permit – not to exceed sixty months.

Signed: * Patty Bentley date 6-4-01
Improvement Permit by: Wesley Sparks R.S. date 6/1/01
Authorization to Construct by: Wesley Sparks R.S. date 6/1/01

Installed by: Wayne Gantz
Operation Permit by: Marsha H. Dotson R.S. date 8/14/2001
Existing System Inspection by: date

HEALTH DEPT COPY: WHITE OWNER COPY (FINAL): YELLOW OWNER COPY (INITIAL): PINK