4664994116

IREDELL COUNTY HEALTH DEPARTMENT

STATESVILLE 704-878-5305 MOORESVILLE 704-664-5281

IMPROVEMENT PERMIT / CERTIFICATE OF COMPLETION / OPERATION PERMIT / EXISTING SYSTEM INSPECTION

PROPERTY DESCRIPTION NO. 22421 DATE Dec 5, '95 TAX MAP NO. 1BAIII Watershed: ☐ Yes ☐ No

OWNER OR CONTRACTOR Patty Bentley PHONE: Business _____ Home 528-9387

ADDRESS 1248 Peeth Rd, Troutman NC

LOCATION 136 S. TR Johnson Dairy Rd. on left across from Wastewater Treatment Plant

SUBDIVISION _____ BLOCK / SECTION _____ LOT _____ LOT AREA 1.39 Ac SITE CLASS. PS DESIGN FLOW 360 gpd. L.T.A.R. .29 gpd/ft/day

Septic Tank: 1000 Gallons; STB 794 Date 10/4/95

Pump Tank: _____ Gallons; PT _____ Date _____

Pump Make: _____ Model _____ Serial No. _____

Nitrification Field: No Fields 1 Square Feet 1800 Linear Feet 600

No Lines 5@120' Trench Width 36" Max Trench Bottom Depth (24") Gravel Depth 12"

☑ New System ☐ Repair System Type: I, (II) III, IV, V, VI

System Description: Shallow grav. conventional

Repair System Description: SAME

Maintenance Agreement Required: ☐ Yes ☑ No

☐ House/Mod. Home No. Bedrooms 3

☑ Mobile Home No. Bathrooms 2

☐ Business No. Employees _____

☐ Other _____


☐ Slab ☑ Crawl Space ☐ Basement w/plumbing ☐ Basement wo/plumbing

Water Supply: ☑ Individual ☐ Community ☐ Public

Comments: Septic System Installer NOTE: Drainfield must be installed shallow - 18" to 24" trench bottom depth and on CONTOUR. PRE INSTALLATION CONFERENCE Required

Comments:

INITIAL SITE SKETCH

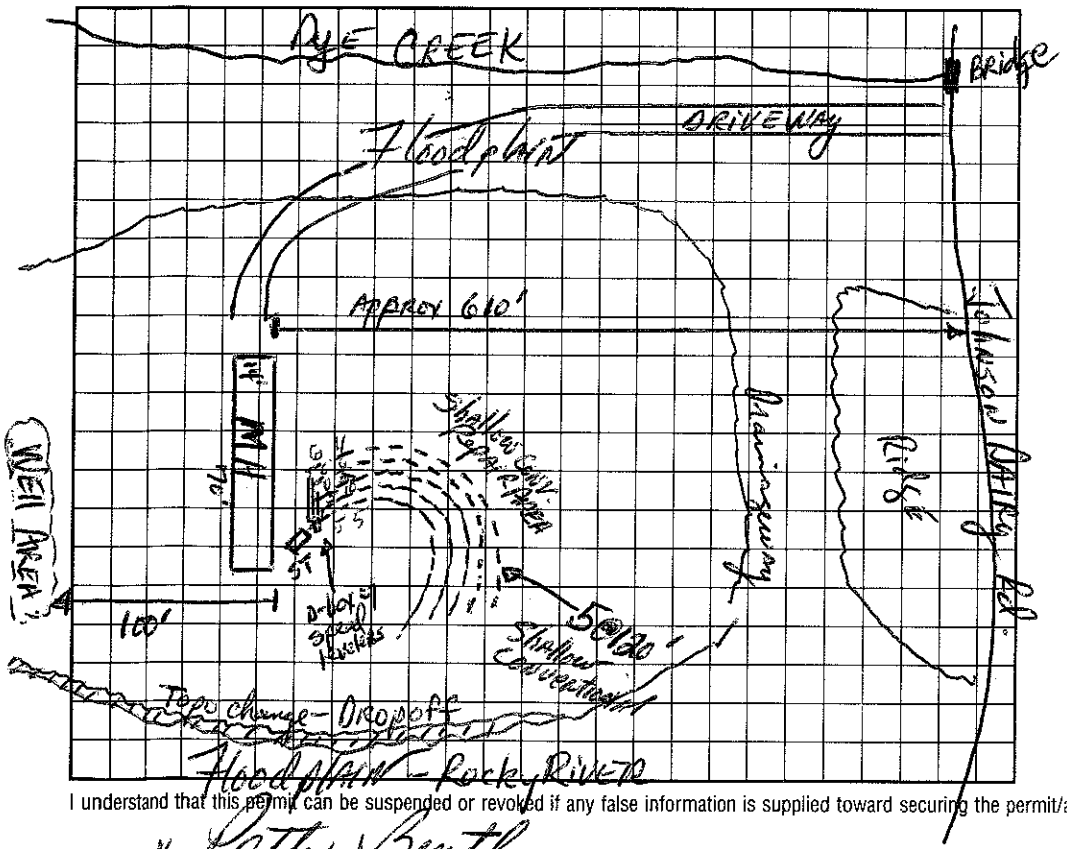

AS BUILT SKETCH

I understand that this permit can be suspended or revoked if any false information is supplied toward securing the permit/any unauthorized changes are made to the site/any unauthorized changes are made in the installation of the system.

Signed: Patty Bentley

Improvement Permit by: _____, RS date 12-5-95

Existing System Inspection by: _____, RS date 12-5-95

Auth to Construct

Installed by: F I Erwin

Certificate of Completion by: Wesley Sparks R.S. date 12/21/95

Operation Permit by: Wesley Sparks R.S. date 12/21/95

HEALTH DEPT. COPY: WHITE INSPECTION COPY (FINAL): GREEN OWNER COPY (FINAL): YELLOW INSPECTION COPY (INITIAL): PINK OWNER COPY (INITIAL): GOLD