4665036388

Ammons - 663-7631

IREDELL COUNTY HEALTH DEPARTMENT

STATESVILLE 704-878-5305 MOORESVILLE 704-664-5281

IMPROVEMENT PERMIT / CERTIFICATE OF COMPLETION / OPERATION PERMIT / EXISTING SYSTEM INSPECTION

PROPERTY DESCRIPTION NO. Repair DATE 6/28/95 TAX MAP NO. Repair Watershed: ☐ Yes ☒ No

OWNER OR CONTRACTOR Kaitlin Young PHONE: Business 384-4274 Home 5

ADDRESS 622 Faith Rd. Mooresville, NC. 28115

LOCATION 1155 TL Faith Rd. ~ 1/2 mile on R past creek "Maple Grove Nursery"

SUBDIVISION N/A BLOCK / SECTION ____ LOT ____ LOT AREA ____ SITE CLASS. ____ DESIGN FLOW ____ L.T.A.R. ____

Septic Tank: 1000 Gallons; STB ____ Date ____

Pump Tank: ____ Gallons; PT ____ Date ____

Pump Make: ____ Model ____ Serial No. ____

Nitrification Field: No Fields 1 Square Feet 720 Linear Feet 240

No Lines 2 Trench Width 36" Max Trench Bottom Depth 32" Gravel Depth 12"

☐ New System ☒ Repair System Type: I (II) III, IV, V, VI

System Description: Bull Run Valve - D/B - Conv

Repair System Description: ____

Maintenance Agreement Required: ☐ Yes ☒ No

☒ House/Mod. Home ☐ Mobile Home ☐ Business ☐ Other

No. Bedrooms 3 No. Bathrooms 2 No. Employees ____


☐ Slab ☒ Crawl Space ☐ Basement w/plumbing ☐ Basement wo/plumbing

Water Supply: ☒ Individual ☐ Community ☐ Public

Comments: Set Bull Run Valve
Reset Original Dist Box
SCH 40 PVC from Bull Run to 2nd Dist Box

Comments: #1 - NEW #2 - OLD.
11/7/96 - Lowest drainline has been plowed and cover brought up and reseeded in problem area. AHS.

INITIAL SITE SKETCH

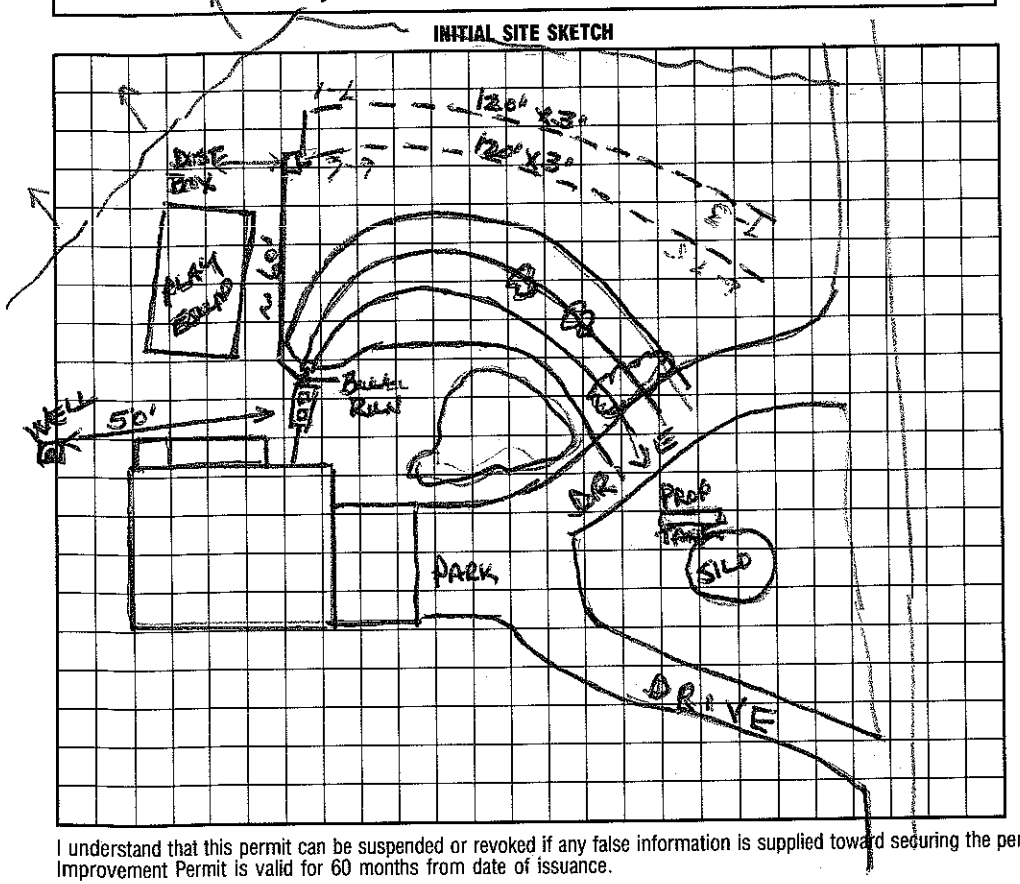

AS BUILT SKETCH

I understand that this permit can be suspended or revoked if any false information is supplied toward securing the permit/any unauthorized changes are made to the site/any unauthorized changes are made in the installation of the system. Improvement Permit is valid for 60 months from date of issuance.

Signed: ____

Improvement Permit by: Wesley Sparks RS. date 6/28/95

Existing System Inspection by: ____ date ____

Installed by: Tim Ammons

Certificate of Completion by: ____ date ____

Operation Permit by: Wesley Sparks RS. date 5/10/96

HEALTH DEPT. COPY: WHITE INSPECTION COPY (FINAL): GREEN OWNER COPY (FINAL): YELLOW INSPECTION COPY (INITIAL): PINK OWNER COPY (INITIAL): GOLD