IREDELL COUNTY HEALTH DEPARTMENT

STATESVILLE 704-878-5305 , MOORESVILLE 704-664-5281

IMPROVEMENT PERMIT / AUTHORIZATION TO CONSTRUCT / OPERATION PERMIT / EXISTING SYSTEM INSPECTION

PERMIT# 124822 PIN# ~~4665-06-4154.000~~ 4665-06-4043 DATE 10/22/04

OWNER OR CONTRACTOR Jim Goodwin PHONE: Business 704-400-8315 Home

ADDRESS 4277 Apex Dr Maiden NC 28650

LOCATION Sherrer Rd TR Faith on Rt

SUBDIVISION Goodwin Est. BLOCK / SECTION LOT 1 LOT AREA 0.74ac SITE CLASS. RS DESIGN FLOW ~~360~~ 360 L.T.A.R. 0.5

Septic Tank: 1000 Gallons; STB 825 Date 10/25/05

Pump Tank: Gallons; PT Date

Pump Make: Model Serial No.

Nitrification Field: No Fields 1 Square Feet ~~900~~ 900 Linear Feet ~~300~~ 300

No Lines 3 ~~90'~~ Trench Width 36" Max Trench Bottom Depth 36" Gravel Depth —

☒ New System ☐ Repair System Type: I, II, III, IV, V, VI

System Description: Gravity 25% Reduct.

Repair System Description: Same

Maintenance Agreement Required: ☐ Yes ☒ No

☒ House/Mod. Home No. Bedrooms ~~3~~ 3

☐ Mobile Home No. Bathrooms

☐ Business No. Employees

☐ Other

☐ Slab ☒ Crawl Space ☐ Basement w/plumbing ☐ Basement wo/plumbing


Water Supply: ☒ Individual ☐ Public ☐ Community

Comments:/Conditions:


Comments:/Conditions:

System change to 3 bedroom 25%

INITIAL SITE SKETCH

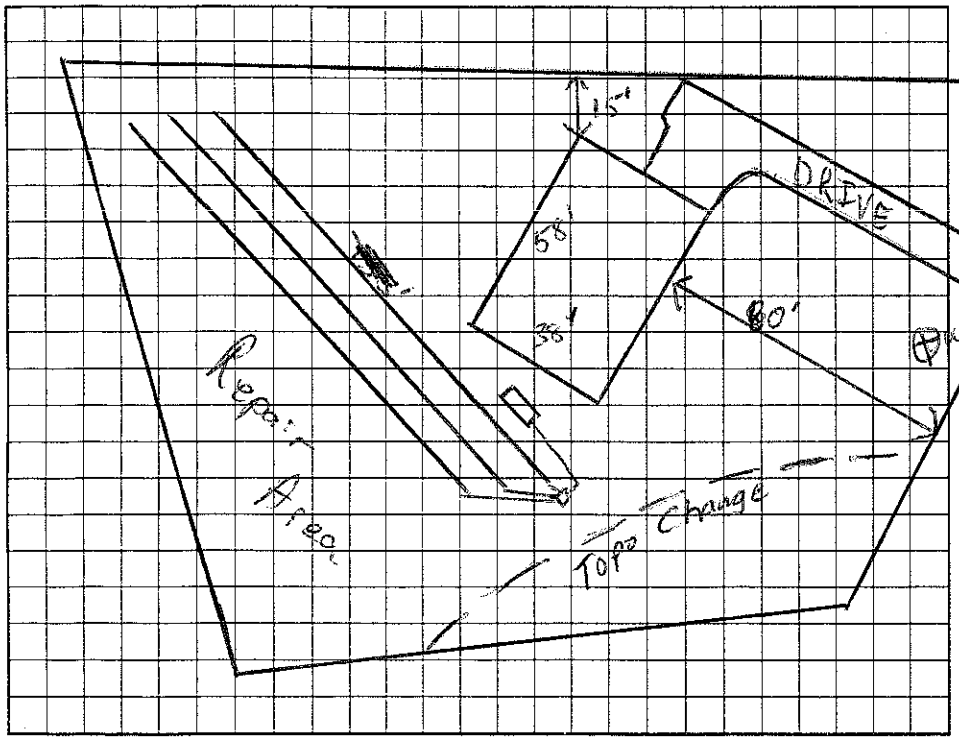

AS BUILT SKETCH

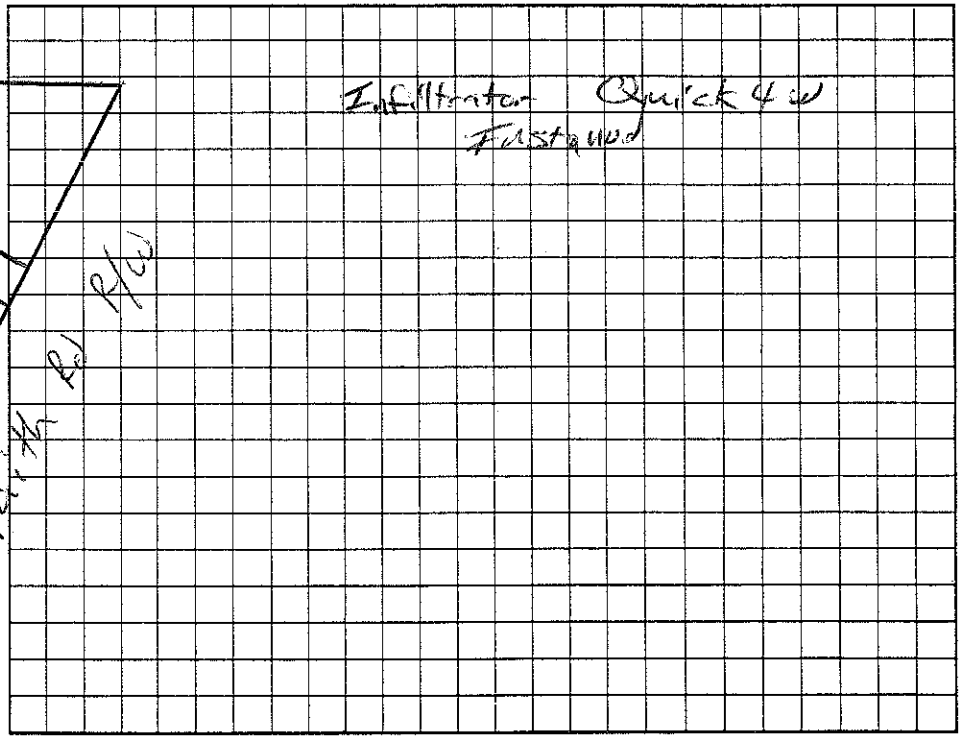

Permit can be suspended or revoked if any false information is supplied toward securing the permit/any unauthorized changes are made to the site/any unauthorized changes are made in the installation of the system. Improvement Permit with plat valid without expiration. Improvement Permit with site plan valid for sixty months. Authorization to Construct is valid for a period equal to that of Improvement Permit – not to exceed sixty months.

Signed: date 10/25/04 Installed by: KOWan Septic

Improvement Permit by: RS date 10/22/04 Operation Permit by: RS date 11/23/05

Authorization to Construct by: RS date 10/22/04 Existing System Inspection by: date

HEALTH DEPT. COPY: WHITE OWNER COPY (FINAL): YELLOW OWNER COPY (INITIAL): PINK