IREDELL COUNTY HEALTH DEPARTMENT

STATESVILLE 704-878-5305 120.00 Paid 3:30 to 4:00 MOORESVILLE 704-664-5281

IMPROVEMENT PERMIT / AUTHORIZATION TO CONSTRUCT / OPERATION PERMIT / EXISTING SYSTEM INSPECTION

PERMIT# 12709 PIN# 4665 20 6197 DATE 5/12/05

OWNER OR CONTRACTOR Huntington Ridge, LLC / Ross SATKO PHONE: Business 704 664-9080 Home

ADDRESS 255 Rolling Hills Rd Mooresville NC 28117

LOCATION Shearers Rd, TR Huntington Ridge Rd, on Lt

SUBDIVISION Huntington Ridge BLOCK / SECTION LOT 27 LOT AREA 8.898Ac SITE CLASS PS DESIGN FLOW 480 L.T.A.R. 0.25

Septic Tank: 1000 Gallons; STB 1007 Date 5/11/05
Pump Tank: 1000 Gallons; PT 1179 Date 5/6/06
Pump Make: Little Giant Model 9EH Serial No.
Nitrification Field: No Fields 1 Square Feet 1440 Linear Feet 480
No Lines 4 Trench Width 36" Max Trench Bottom Depth 24" Gravel Depth —

☒ New System ☐ Repair System Type: I, II, (III), IV, V, VI
System Description: PM 25% Reduct.
Repair System Description: Same
Maintenance Agreement Required? ☐ Yes ☒ No

☒ House/Mod. Home ☐ Mobile Home ☐ Business ☐ Other
No. Bedrooms 4 No. Bathrooms No. Employees


Water Supply: ☒ Individual ☐ Public ☐ Community

☐ Slab ☐ Crawl Space ☒ Basement w/plumbing ☐ Basement wo/plumbing


Comments/Conditions:

Comments/Conditions:

INITIAL SITE SKETCH

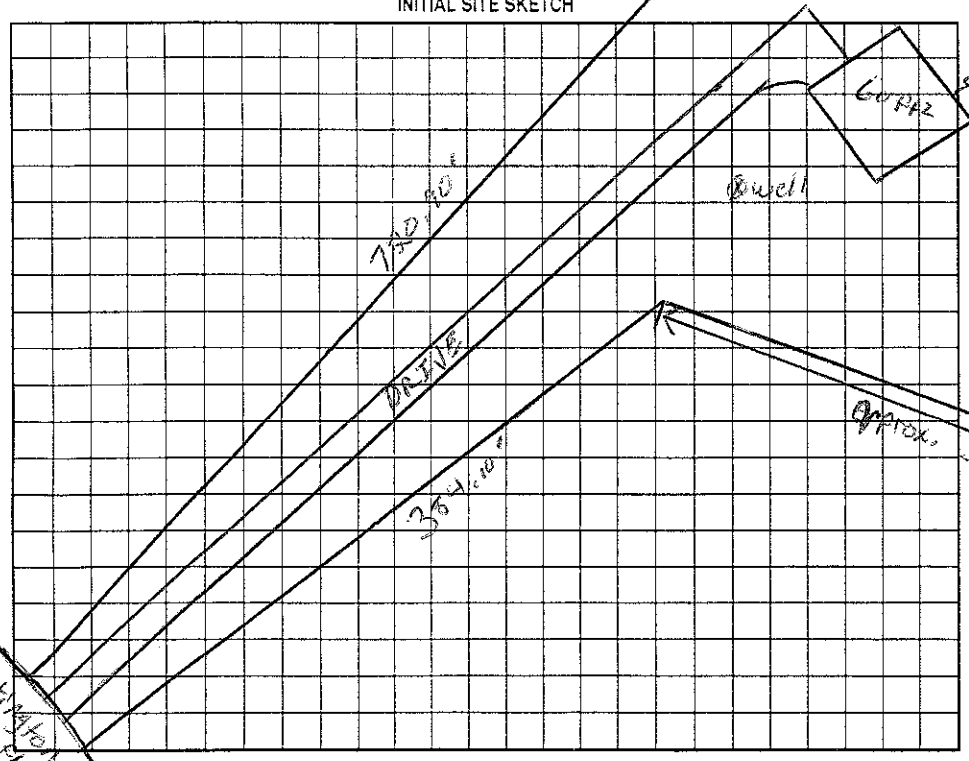

AS BUILT SKETCH

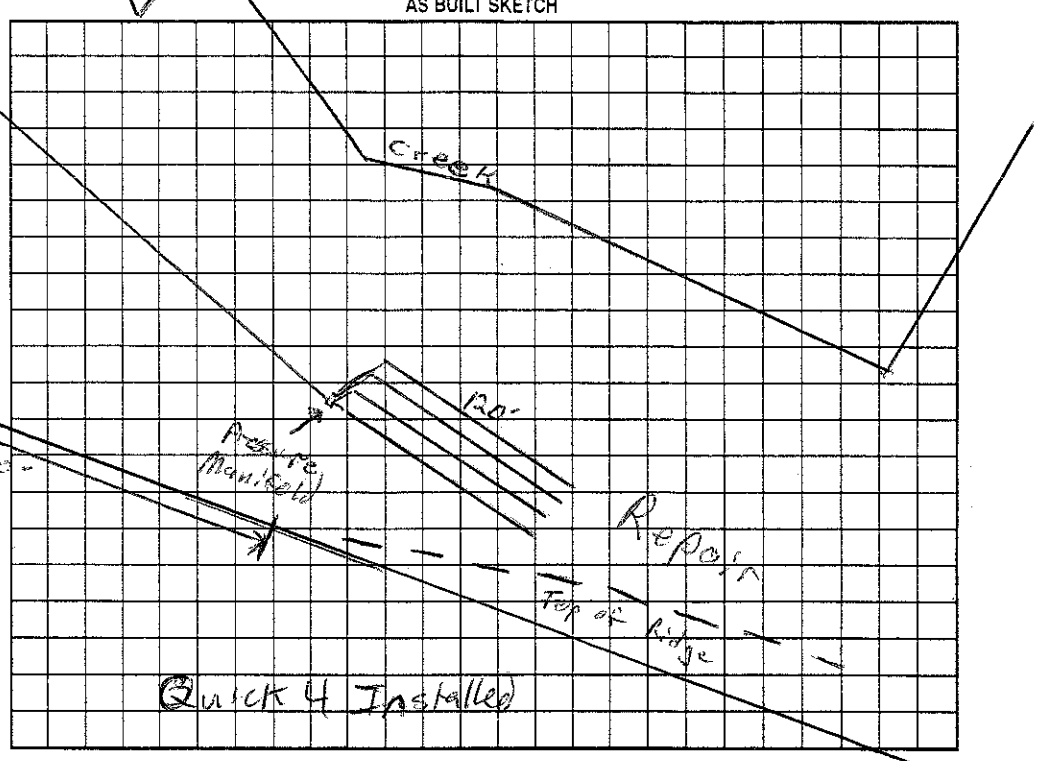

Permit can be suspended or revoked if any false information is supplied toward securing the permit/any unauthorized changes are made to the site/any unauthorized changes are made in the installation of the system. Improvement Permit with plat valid without expiration. Improvement Permit with site plan valid for sixty months. Authorization to Construct is valid for a period equal to that of Improvement Permit – not to exceed sixty months.

Signed: date 5/19/05 Installed by: Abernathy

Improvement Permit by: RS date 5/12/05 Operation Permit by: LS date 9/22/06

Authorization to Construct by: Wesley Sparkman date 6/24/05 Existing System Inspection by: date

HEALTH DEPT. COPY: WHITE OWNER COPY (FINAL): YELLOW OWNER COPY (INITIAL): PINK