IREDELL COUNTY HEALTH DEPARTMENT

STATESVILLE 704-878-5305 MOORESVILLE 704-664-5281

IMPROVEMENT PERMIT / AUTHORIZATION TO CONSTRUCT / OPERATION PERMIT / EXISTING SYSTEM INSPECTION

PERMIT # 154969 PIN # 4665 21 3161 DATE 2/26/09

OWNER or APPLICANT ERIC THOMPSON PHONE: Business 704-799-1103 Home: 704-231-3842

OWNER or APPLICANT ADDRESS 249 STREAMSIDE LN MOORESVILLE, NC, 28115

LOCATION / DIRECTIONS SHEARERS RD. TR STREAMSIDE TO # 249 ON L

SUBDIVISION CREEKS EAGE BLOCK / SECTION LOT # 16 LOT AREA .63 DESIGN FLOW 360 L.T.A.R. .3

Septic Tank 1000 Gallons STS EXISTING Date

Pump Tank 1000 Gallons: PT Date

Pump Make Model Serial #

Nitrification Field No Fields 1 No Lines 3 Linear Feet 200

Trench Width 2' Max. Trench Bottom Depth 3 Gravel Depth NA ☐ GRAVITY ☒ PRESSURE

☐ New System ☐ Repair ☐ Expansion System Type I II III (IV) V VI

System Description: LP - PP13PS

Repair System Description: EXISTING

Maintenance Agreement Required ☒ YES ☐ NO


☒ Residence No. Bedrooms 3 ☐ Business No. Persons ☐ Other No. Employees ☐ Slab ☐ Crawl Space ☒ Basement w/plumbing ☐ Basement w/o plumbing

Water Supply: ☒ Private ☐ Public ☐ Community

Comments / Conditions


AS BUILT SKETCH

INITIAL SITE SKETCH

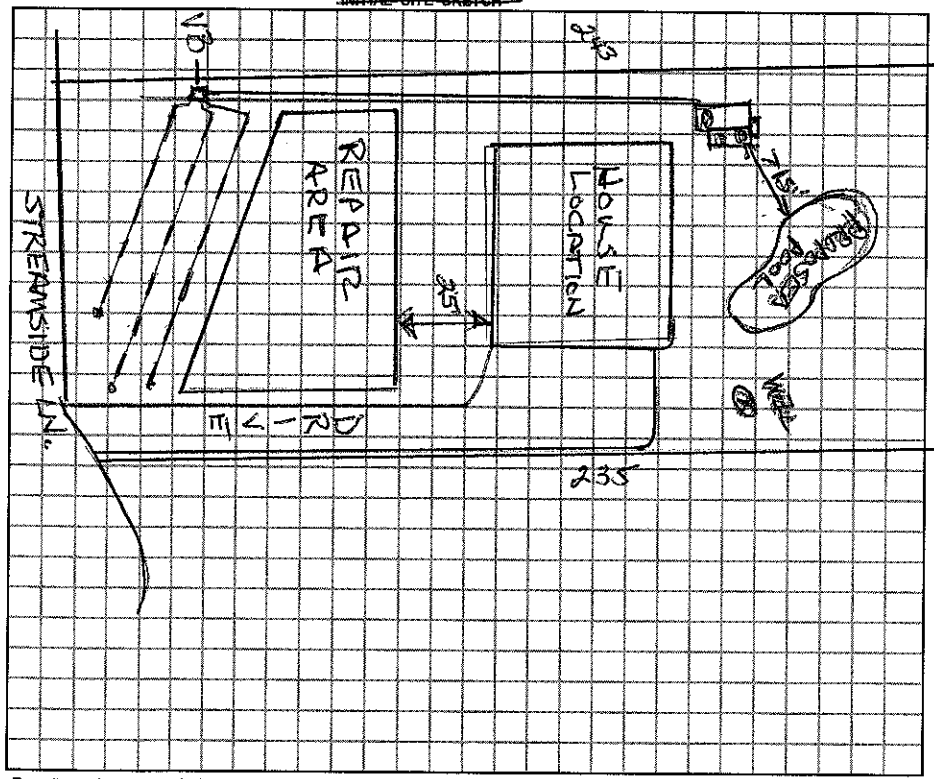

Comments / Conditions

AS BUILT SKETCH

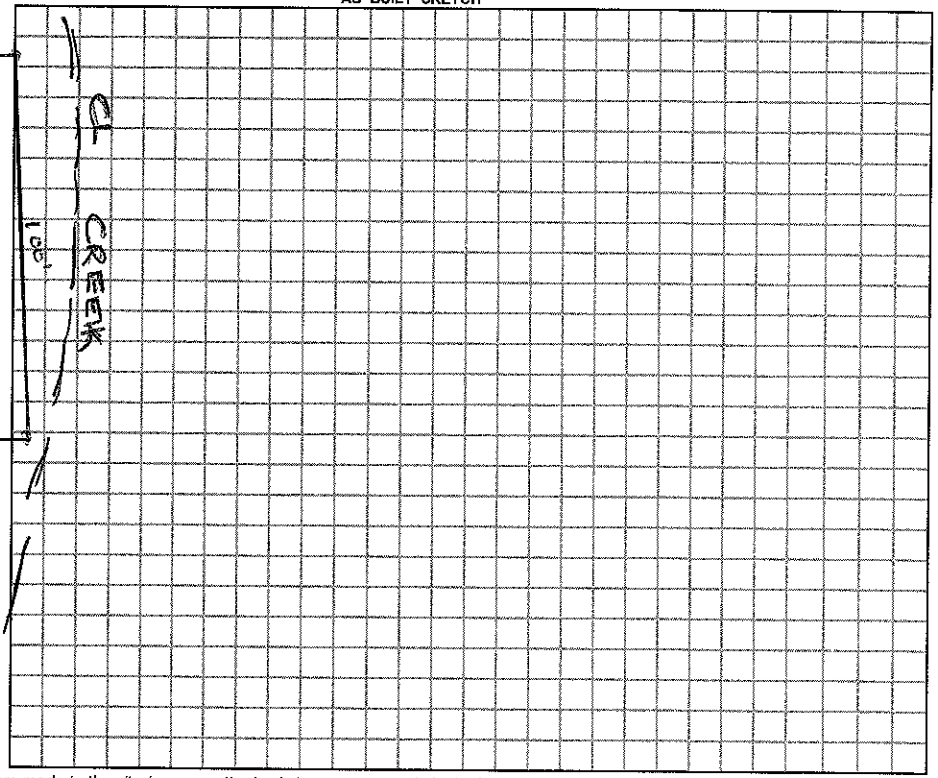

Permit can be suspended or revoked if any false information is supplied toward securing the permit / any unauthorized changes are made to the site / any unauthorized changes are made in the installation of the system.

☐ *IMPROVEMENT PERMIT w / plat valid without expiration.* ☐ *IMPROVEMENT PERMIT w / site plan valid for 60 mos.* ☐ *AUTHORIZATION TO CONSTRUCT valid for period equal to IMPROVEMENT PERMIT-not to exceed 60 mo.*

Owner / Applicant Signature: Eric Porter Date 2/ /09

Improvement Permit by: Date

Authorzation to Construct by: Date

YOU SHOULD CONTACT A LOCATOR SERVICE PRIOR TO ANY EXCAVATION.

Installed by:

Operation Permit by: Date:

Existing System Inspected by: Wesley Sparks RS. Date: 2/26/09

WHITE COPY Environmental Health YELLOW COPY (Final) Owner / Applicant PINK COPY (Initial) Owner / Applicant