CHECK IN 2WKS Laura Huffey - 704-660-1778

IREDELL COUNTY HEALTH DEPARTMENT

STATESVILLE 704-878-5305 MOORESVILLE 704-664-5281

IMPROVEMENT PERMIT / AUTHORIZATION TO CONSTRUCT / OPERATION PERMIT / EXISTING SYSTEM INSPECTION

PERMIT# 131392 PIN# 4665 315665 / 4665 21 4464 DATE 1-13-06

OWNER OR APPLICANT Topaz Development/Windsor Homes PHONE: Business 704-564-4680 Home

ADDRESS 19117 Callaway Hills Ln Davidson 28036

LOCATION Sheavers Rd TR Streamside Ln on right 1238 Streamside Ln.

SUBDIVISION Creeks Edge BLOCK / SECTION LOT 27 LOT AREA .79 SITE CLASS. PS DESIGN FLOW 480gpd. L.T.A.R. .25 gpd/ft²

Septic Tank: 1000 Gallons; STB 799 Date 9-10-06

Pump Tank: 1000 Gallons; PT 27 Date 9-11-06

Pump Make: Meyers Model ME50S-11 Serial No.

Nitrification Field: No Fields 1 Square Feet 640 Linear Feet 320

No Lines 5@64' Trench Width 24" Max Trench Bottom Depth 33" Gravel Depth NA ☐ Gravity ☒ Pressure

☒ New System ☐ Repair ☐ Expansion System Type: I II III IV V VI

System Description: LP Panel

Repair System Description: LP Panel

Maintenance Agreement Required: ☒ Yes ☐ No

☒ House/Mod. Home No. Bedrooms 4

☐ Mobile Home No. Persons

☐ Business No. Employees

☐ Other

Water Supply: ☒ Individual ☐ Public ☐ Community

☐ Slab ☐ Crawl Space ☒ Basement w/plumbing ☐ Basement wo/plumbing


1/2 NP

Comments:/Conditions: 15 panels

Comments:/Conditions:

1" = 50'

INITIAL SITE SKETCH

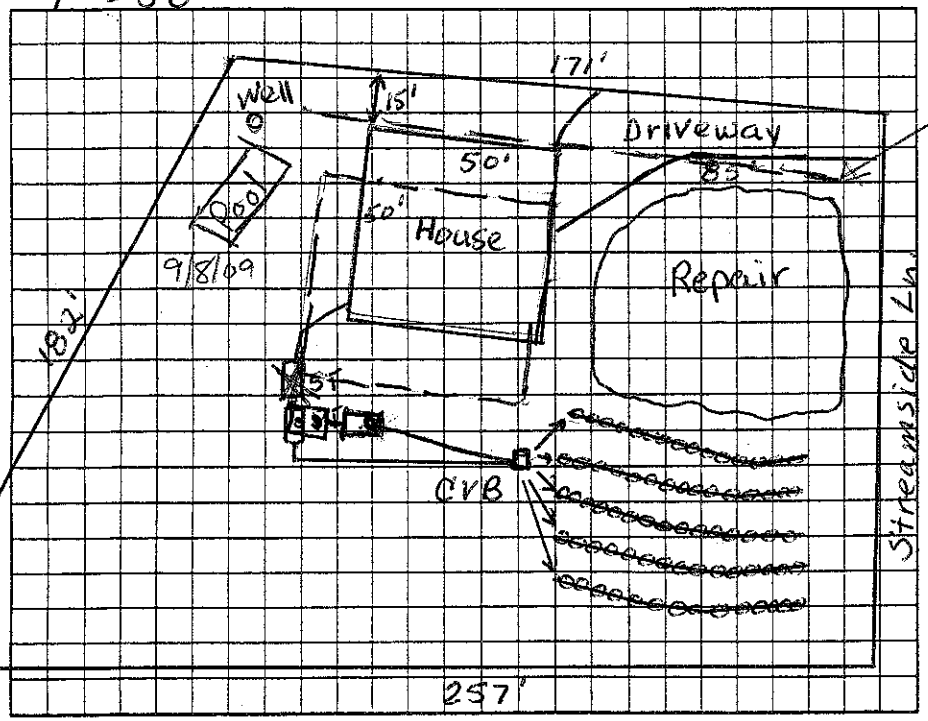

AS BUILT SKETCH

SUBSURFACE INTERCEPT TO BE INSTALLED BEFORE OP WILL BE ISSUED 12/1/06 W Hopkins.

Permit can be suspended or revoked if any false information is supplied toward securing the permit/any unauthorized changes are made to the site/any unauthorized changes are made in the installation of the system. Improvement Permit with plat valid without expiration ☐ Improvement Permit with site plan valid for sixty months ☒ Authorization to Construct is valid for a period equal to that of Improvement Permit – not to exceed sixty months.

Signed: date 2/23/06

Improvement Permit by: Judy Melville date 1-13-06

Authorization to Construct by: date 8/16/06

Installed by: Stanley Septic

Operation Permit by: Wesley Sparks RS date 12/22/06

Existing System Inspection by: date

HEALTH DEPT. COPY: WHITE OWNER COPY (FINAL): YELLOW OWNER COPY (INITIAL): PINK