IREDELL COUNTY HEALTH DEPARTMENT

STATESVILLE 704-878-5305 MOORESVILLE 704-664-5281

IMPROVEMENT PERMIT / AUTHORIZATION TO CONSTRUCT / OPERATION PERMIT / EXISTING SYSTEM INSPECTION

PERMIT# 131393 PIN# 4665315665 / 4665 21 5448 DATE 2-15-06

OWNER OR APPLICANT Topaz Development Inc / Wynsor Homes PHONE: Business 704-564-4680 Home

ADDRESS 19117 Callaway Hills Ln Davidson 28036

LOCATION Shewers Rd TR Streamside on right 232 Streamside Pl

SUBDIVISION Creeks Edge BLOCK / SECTION LOT 28 LOT AREA .57 Ac SITE CLASS. PS DESIGN FLOW 480gpd L.T.A.R. .25 gpd/ft²

Septic Tank: 1000 Gallons; STB 312 Date 32.3 rebound

Pump Tank: 1000 Gallons; PT 283 Date 12-6-06

Pump Make: Model Serial No.

Nitrification Field: No Fields Square Feet Linear Feet

No Lines 4@30' Trench Width 24" min. Max Trench Bottom Depth 36" Gravel Depth NA ☐ Gravity ☒ Pressure

☒ New System ☐ Repair ☐ Expansion System Type: I II III (IV) V VI

System Description: LP Panel

Repair System Description: LP Panel

Maintenance Agreement Required: ☒ Yes ☐ No

☒ House/Mod. Home No. Bedrooms 4

☐ Mobile Home No. Persons

☐ Business No. Employees

☐ Other

Water Supply: ☒ Individual ☐ Public ☐ Community


☐ Slab ☒ Crawl Space ☐ Basement w/plumbing ☐ Basement wo/plumbing

Comments:/Conditions: 74 panels
Well must be 100' from system due to saprolite


Comments:/Conditions:
9-7-06 Can't find date on ST
Checked lines

1" = 50'

INITIAL SITE SKETCH

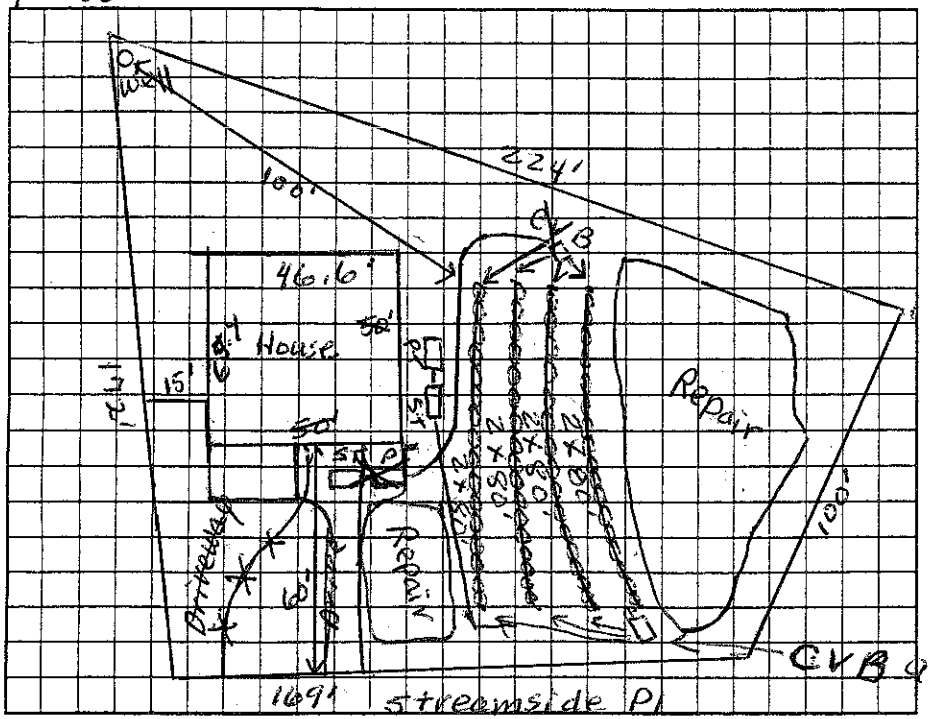

AS BUILT SKETCH

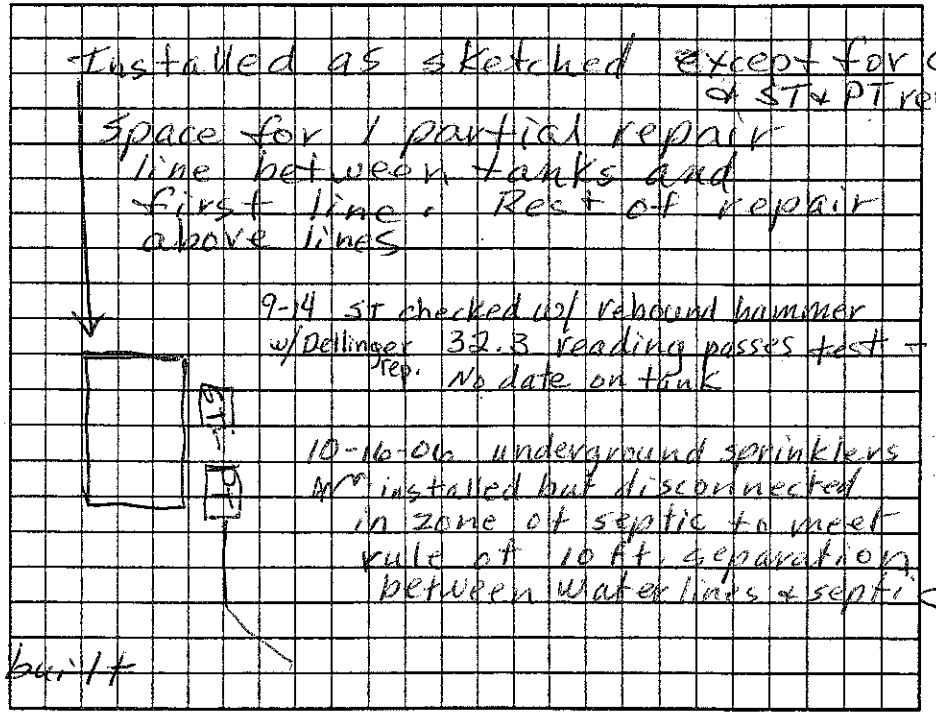

Permit can be suspended or revoked if any false information is supplied toward securing the permit/any unauthorized changes are made to the site/any unauthorized changes are made in the installation of the system. Improvement Permit with plat valid without expiration ☐ Improvement Permit with site plan valid for sixty months ☒ Authorization to Construct is valid for a period equal to that of Improvement Permit – not to exceed sixty months.

Signed: date 2/23/06 Installed by: Stanley Septic

Improvement Permit by: Judy Melville date 2-15-06 Operation Permit by: Judy Melville date 10-18-06

Authorization to Construct by: Judy Melville date 5-16-06 Existing System Inspection by: date

HEALTH DEPT. COPY: WHITE OWNER COPY (FINAL): YELLOW OWNER COPY (INITIAL): PINK