IREDELL COUNTY HEALTH DEPARTMENT

STATESVILLE 704-878-5305 MOORESVILLE 704-664-5281

IMPROVEMENT PERMIT / AUTHORIZATION TO CONSTRUCT / OPERATION PERMIT / EXISTING SYSTEM INSPECTION

PERMIT# 131366 PIN# 4665315665.013 / 4665216255 DATE 2/23/06

OWNER OR CONTRACTOR Topaz Dev. Inc. / WAYNSOR HOMES PHONE: Business _____ Home _____

ADDRESS 19117 Calgwey Hills Ln Davidson NC 28036 / 231 Streamside Pkwy

LOCATION Shearers Rd, TR Streamside, on Lt

SUBDIVISION Creeks Edge BLOCK / SECTION _____ LOT 13 LOT AREA 0.66AC SITE CLASS. PS DESIGN FLOW 480 L.T.A.R. 0.3

Septic Tank: 1000 Gallons; STB 794 Date 7-19-06 ☒ New System ☐ Repair System Type: I, II, III, (IV), V, VI

Pump Tank: 1000 Gallons; PT 283 Date 9-11-06 System Description: LP Panel Block

Pump Make: Meyers Model ME 508-11 Serial No. _____ Repair System Description: Same

Nitrification Field: No Fields 1 Square Feet 540 Linear Feet 270 Maintenance Agreement Required: ☒ Yes ☐ No

No Lines 3@90' Trench Width 24" Max Trench Bottom Depth 36" Gravel Depth —

☒ House/Mod. Home No. Bedrooms 4 ☐ Mobile Home No. Bathrooms ____ ☐ Business No. Employees ____ ☐ Other ____

☐ Slab ☐ Crawl Space ☒ Basement w/plumbing ☐ Basement wo/plumbing

Water Supply: ☒ Individual ☐ Public ☐ Community


Comments:/Conditions:

House is 118' from Front property Line
Utilities Need to be within 10' of property Lines
Side-load garage only


Comments:/Conditions:

septic tank, pump tank w/ risers

INITIAL SITE SKETCH

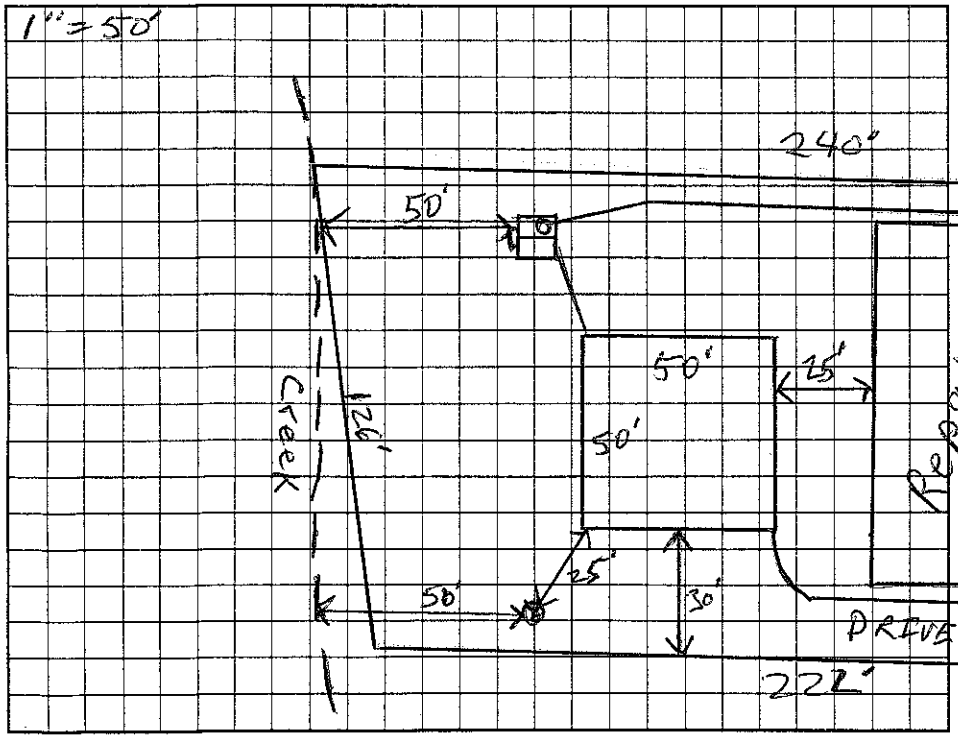

AS BUILT SKETCH

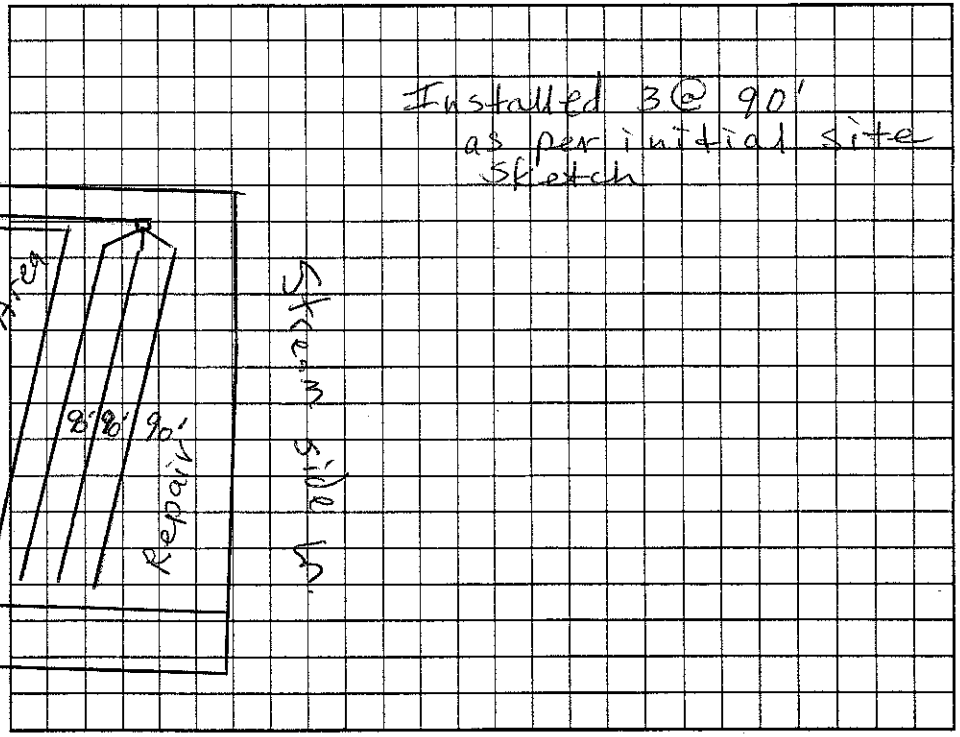

Permit can be suspended or revoked if any false information is supplied toward securing the permit/any unauthorized changes are made to the site/any unauthorized changes are made in the installation of the system. Improvement Permit with plat valid without expiration. Improvement Permit with site plan valid for sixty months. Authorization to Construct is valid for a period equal to that of Improvement Permit – not to exceed sixty months.

Signed: _____ date 3/23/06 Installed by: Stanley Septic

Improvement Permit by: _____ RS date 2/23/06 Operation Permit by: Cindy Melville date 12-22-06

Authorization to Construct by: Wesley Sparks RS date 7/27/06 Existing System Inspection by: _____ date _____

HEALTH DEPT. COPY: WHITE OWNER COPY (FINAL): YELLOW OWNER COPY (INITIAL): PINK