IREDELL COUNTY HEALTH DEPARTMENT

STATESVILLE 704-878-5305 MOORESVILLE 704-664-5281

IMPROVEMENT PERMIT / AUTHORIZATION TO CONSTRUCT / OPERATION PERMIT / EXISTING SYSTEM INSPECTION

PERMIT# 0784666 PIN# 4665229802

OWNER OR CONTRACTOR James McKnight PHONE: Business 664-9080 Home DATE 9-25-00

ADDRESS 255 Rolling Hills Dr. Mooresville NC

LOCATION Shearers Rd TR Ashley Woods Rear Rt at end on left

SUBDIVISION Ashley Woods BLOCK / SECTION LOT Tract B LOT AREA 1.85 Area SITE CLASS. PS DESIGN FLOW 360 gpd T.A.R. .25

Septic Tank: 1000 Gallons; STB 1012 Date 6-17-00

Pump Tank: Gallons; PT Date

Pump Make: Model Serial No.

Nitrification Field: No Fields Square Feet Linear Feet

No Lines Trench Width Max Trench Bottom Depth Gravel Depth

☒ New System ☐ Repair System Type: I II III IV V VI

System Description: Gravity - 25% Reduction

Repair System Description: Pump + Panel Blk

Maintenance Agreement Required: ☐ Yes ☒ No

☐ House/Mod. Home ☒ Mobile Home ☐ Business ☐ Other

No. Bedrooms 4 No. Bathrooms 3 No. Employees

☐ Slab ☐ Crawl Space ☐ Basement w/plumbing ☐ Basement wo/plumbing


Water Supply: ☐ Individual ☒ Public ☒ Community

Comments:/Conditions:

Drive

Scale 1:50

INITIAL SITE SKETCH

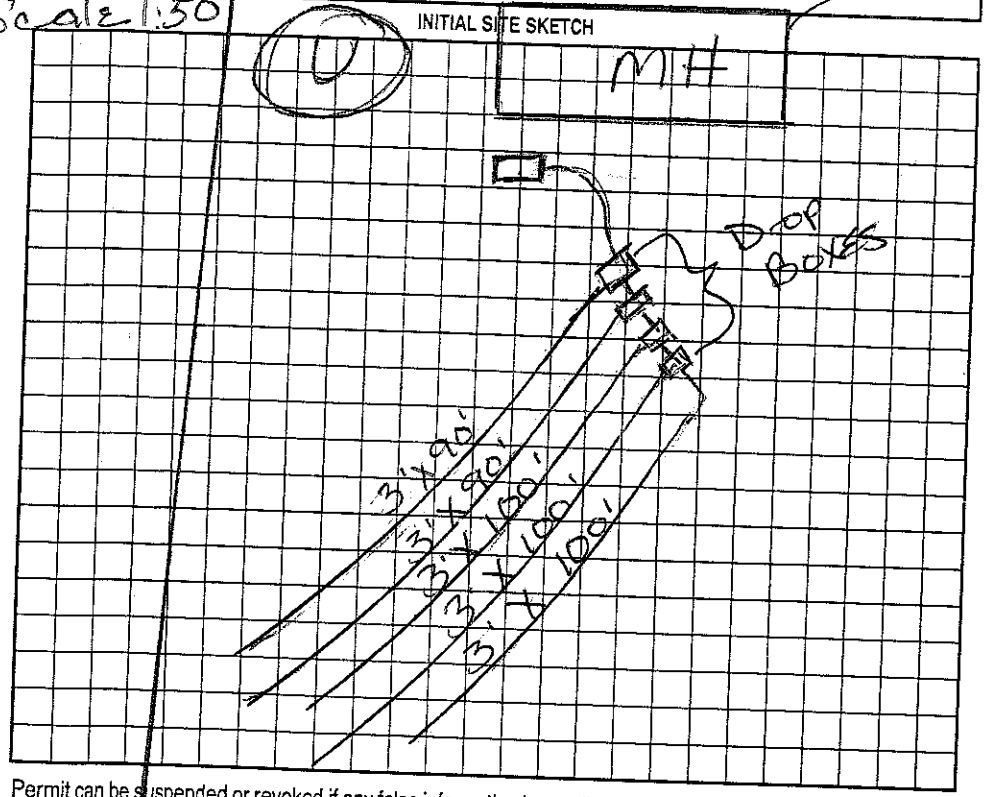

Comments:/Conditions:

Way

Septic Easement Area For Lot 14

AS BUILT SKETCH

Permit can be suspended or revoked if any false information is supplied toward securing the permit/any unauthorized changes are made to the site/any unauthorized changes are made in the installation of the system. Improvement Permit with plat valid without expiration. Improvement Permit with site plan valid for sixty months. Authorization to Construct is valid for a period equal to that of Improvement Permit – not to exceed sixty months.

Signed: date

Improvement Permit by: date

Authorization to Construct by: date

Installed by: Craig Thompson Grading

Operation Permit by: Maria H. Dotson R.S. date 9/25/00

Existing System Inspection by: date

HEALTH DEPT. COPY: WHITE OWNER COPY (FINAL): YELLOW OWNER COPY (INITIAL): PINK