4665 26 52 99

IREDELL COUNTY HEALTH DEPARTMENT

STATESVILLE 704-878-5305 MOORESVILLE 704-664-5281

IMPROVEMENT PERMIT / CERTIFICATE OF COMPLETION / OPERATION PERMIT / EXISTING SYSTEM INSPECTION

PROPERTY DESCRIPTION NO. 04373 DATE 2/15/94 TAX MAP NO. ID-C-73 Watershed: ☑ Yes ☐ No

OWNER OR CONTRACTOR RUSSELL MEDLEY PHONE: Business _____ Home 663-7261

ADDRESS Rt 1 Box 638-A MOORESVILLE, NC.

LOCATION SMYRNA LN. (R) OFF SHEARERS RD.

SUBDIVISION _____ BLOCK / SECTION _____ LOT _____ LOT AREA _____ SITE CLASS. A DESIGN FLOW 360 L.T.A.R. .25-.3

Septic Tank: EXISTING 1000 Gallons; STB _____ Date _____

Pump Tank: _____ Gallons; PT _____ Date _____

Pump Make: _____ Model _____ Serial No. _____

Nitrification Field: No Fields 1 Square Feet 900 Linear Feet 300

No Lines 3 Trench Width ~~24~~ 15' Max Trench Bottom Depth 36 ~~40~~" Gravel Depth 12"

☐ New System ☑ Repair System Type: I, II, III, IV, V, VI

System Description: 15' ~~x 60'~~ BED

Repair System Description: _____

Maintenance Agreement Required: ☐ Yes ☐ No

☑ House/Mod. Home No. Bedrooms 3

☐ Mobile Home No. Bathrooms 2

☐ Business No. Employees _____

☐ Other _____

☐ Slab ☑ Crawl Space ☐ Basement w/plumbing ☐ Basement wo/plumbing


Water Supply: ☑ Individual ☐ Community ☐ Public

Comments: Trenching no deeper than 36" to trench bottom
Bull Run Valve installed as shown.

Comments:
Installed as shown
15' x 60' BED - Bull Run Valve installed as shown

WELL [O]

INITIAL SITE SKETCH

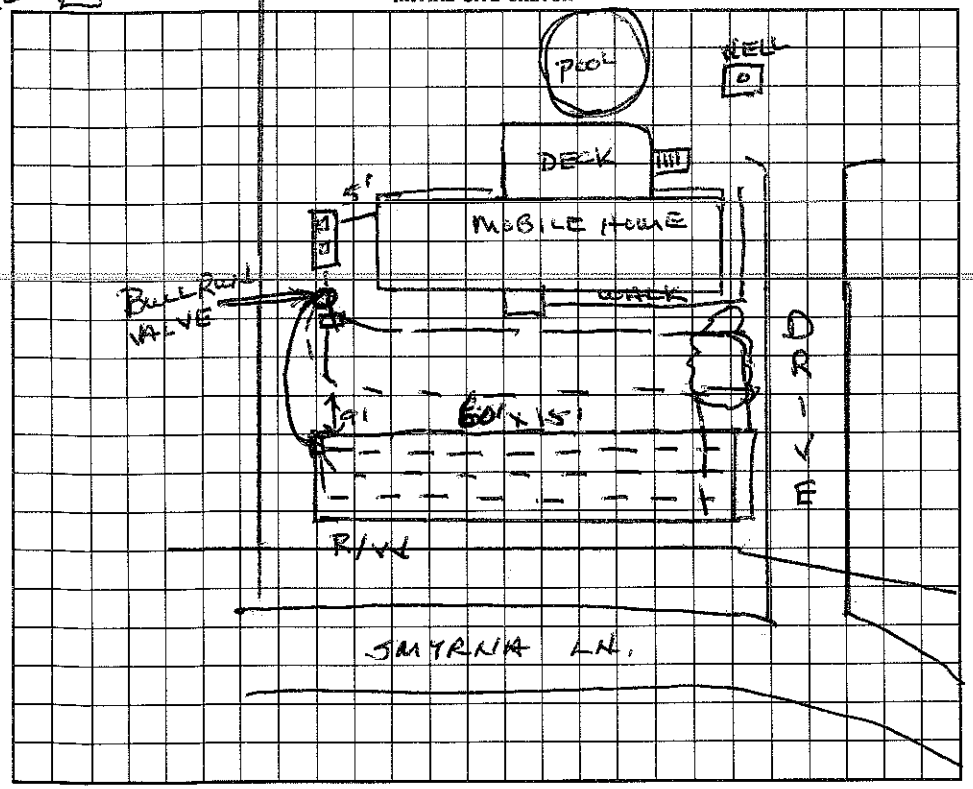

AS BUILT SKETCH

I understand that this permit can be suspended or revoked if any false information is supplied toward securing the permit/any unauthorized changes are made to the site/any unauthorized changes are made in the installation of the system. Improvement Permit is valid for 60 months from date of issuance.

Signed: _____

Improvement Permit by: Wesley Sparks RS. date 2/15/94

Existing System Inspection by: _____ date _____

Installed by: J Bowles

Certificate of Completion by: Wesley Sparks RS. date 3/4/94

Operation Permit by: _____ date _____

HEALTH DEPT. COPY: WHITE INSPECTION COPY (FINAL): GREEN OWNER COPY (FINAL): YELLOW INSPECTION COPY (INITIAL): PINK OWNER COPY (INITIAL): GOLD