4665266084

IREDELL COUNTY HEALTH DEPARTMENT

STATESVILLE 704-878-5305 MOORESVILLE 704-664-5281

IMPROVEMENT PERMIT / CERTIFICATE OF COMPLETION / OPERATION PERMIT / EXISTING SYSTEM INSPECTION

PROPERTY DESCRIPTION NO. N/A DATE 8/29/94 TAX MAP NO. N/A Watershed: ☐ Yes ☒ No

OWNER OR CONTRACTOR Richy Cuder PHONE: Business _____ Home 663-5822

ADDRESS Rt 1 Box 635-C Mooresville NC. 28115

LOCATION Smyrna Ln, (R) off Brawley Rd to 3rd MH on (R)

SUBDIVISION EXISTING BLOCK / SECTION _____ LOT _____ LOT AREA 2 acres SITE CLASS. _____ DESIGN FLOW 360 L.T.A.R. .2-.25

Septic Tank: 1600 Gallons; STB _____ Date _____

Pump Tank: _____ Gallons; PT _____ Date _____

Pump Make: _____ Model _____ Serial No. _____

Nitrification Field: No Fields 1 Square Feet 300 Linear Feet 100

No Lines 1 Trench Width 3-3.5 Max Trench Bottom Depth 36" Gravel Depth _____

☐ New System ☒ Repair System Type: I (II) III, IV, V, VI

System Description: DIST BOX - CONV.

Repair System Description: _____

Maintenance Agreement Required: ☐ Yes ☒ No

☑ House/Mod. Home No. Bedrooms 3

☐ Mobile Home No. Bathrooms 2

☐ Business No. Employees _____

☐ Other _____


☐ Slab ☐ Crawl Space ☐ Basement w/plumbing ☐ Basement wo/plumbing

Water Supply: ☑ Individual ☐ Community ☐ Public


Comments: Spoil heaviness in Dist. Box

Comments: D-box under concrete sidewalk, Pipe to new line set as close as possible w/out tearing up sidewalk.

INITIAL SITE SKETCH

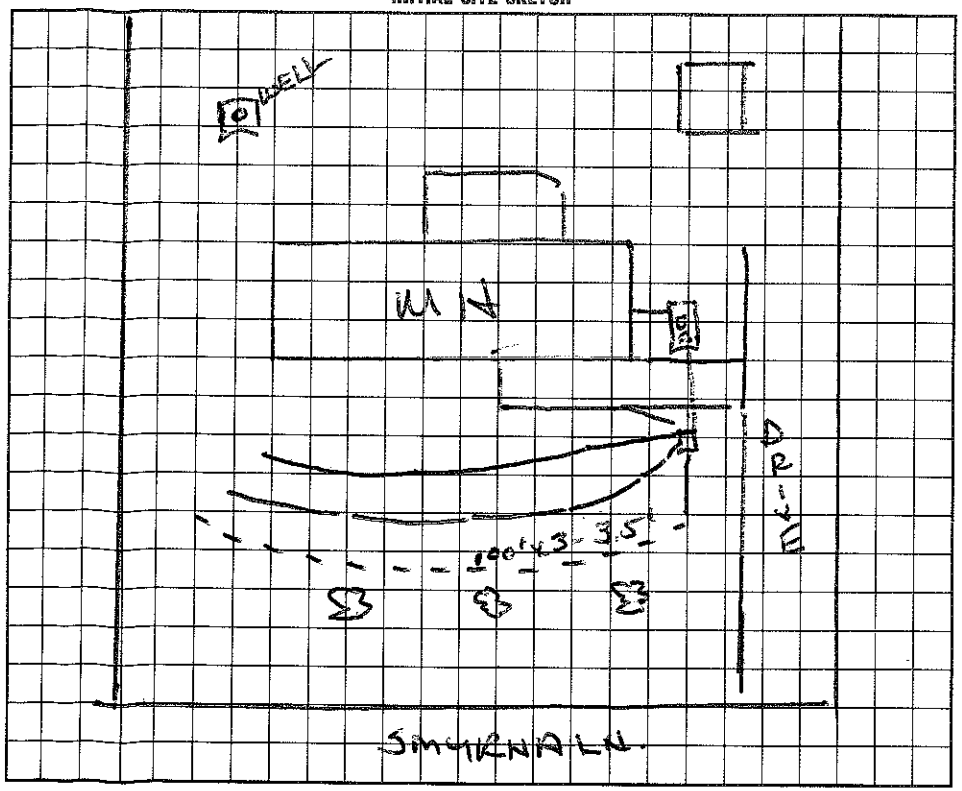

AS BUILT SKETCH

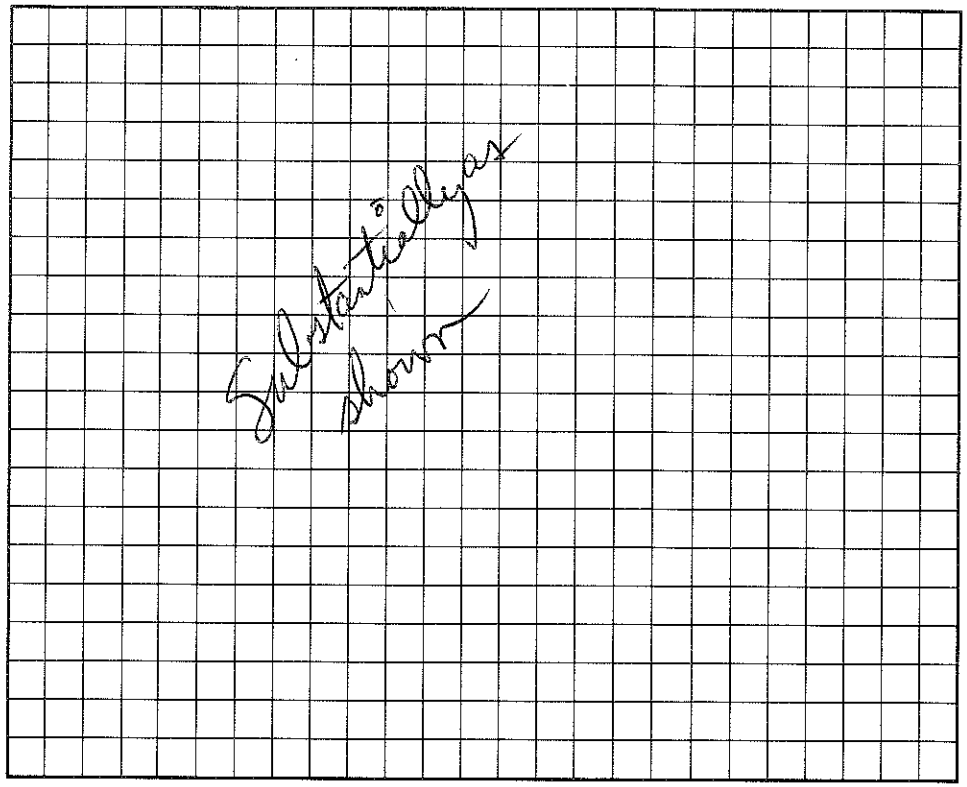

I understand that this permit can be suspended or revoked if any false information is supplied toward securing the permit/any unauthorized changes are made to the site/any unauthorized changes are made in the installation of the system. Improvement Permit is valid for 60 months from date of issuance.

Signed: _____

Improvement Permit by: Wesley Sparks date 8/29/94

Existing System Inspection by: _____ date _____

Installed by: J R Bowles

Certificate of Completion by: D K Hanson, RS date 9-22-94

Operation Permit by: _____ date _____

HEALTH DEPT. COPY: WHITE INSPECTION COPY (FINAL): GREEN OWNER COPY (FINAL): YELLOW INSPECTION COPY (INITIAL): PINK OWNER COPY (INITIAL): GOLD