IREDELL COUNTY HEALTH DEPARTMENT STATESVILLE 704-878-5305 MOORESVILLE 704-664-5281 COPY

IMPROVEMENT PERMIT / AUTHORIZATION TO CONSTRUCT / OPERATION PERMIT / EXISTING SYSTEM INSPECTION

PERMIT # 164770 PIN # ~~4665 26 9117~~ 4665269112 DATE 1-7-10

OWNER or APPLICANT KENNETH BAXTER PHONE: Business Home:

OWNER or APPLICANT ADDRESS 128 JUNIPER RD MOORESVILLE, NC 28115

LOCATION / DIRECTIONS SHEARERS RD, TO SMYRNA

SUBDIVISION IRENE HUFFMAN BLOCK / SECTION LOT # 3 LOT AREA .533 AC DESIGN FLOW 360 L.T.A.R. .3

Septic Tank Ex 1000 Gallons: STB Date

Pump Tank Gallons: P T Date

Pump Make Model Serial #

Nitrification Field No Fields 1 No Lines 3 Linear Feet ~~200~~ 186

Trench Width 36" Max. Trench Bottom Depth 36" Gravel Depth — ☒ GRAVITY ☐ PRESSURE

☐ New System ☐ Repair ☒ Expansion System Type I II (III) IV V VI

System Description: 25% REDUCTION

Repair System Description: PANEL BLACK

Maintenance Agreement Required ☐ YES ☒ NO


☒ Residence No. Bedrooms 3 ☐ Business No. Persons ☐ Other No. Employees ☐ Slab ☒ Crawl Space ☐ Basement w/plumbing ☐ Basement w/o plumbing

Water Supply: ☒ Private ☐ Public ☐ Community


Comments / Conditions ① STAY 10' OFF PROP LINE & 5' OFF FOUNDATION ② USE HYDROLIC CEMENT OR EQUIVALENT TO SEAL OFF ANY PREVIOUSLY USED OUTLETS IN D BOX / OR SET NEW

Comments / Conditions

INITIAL SITE SKETCH

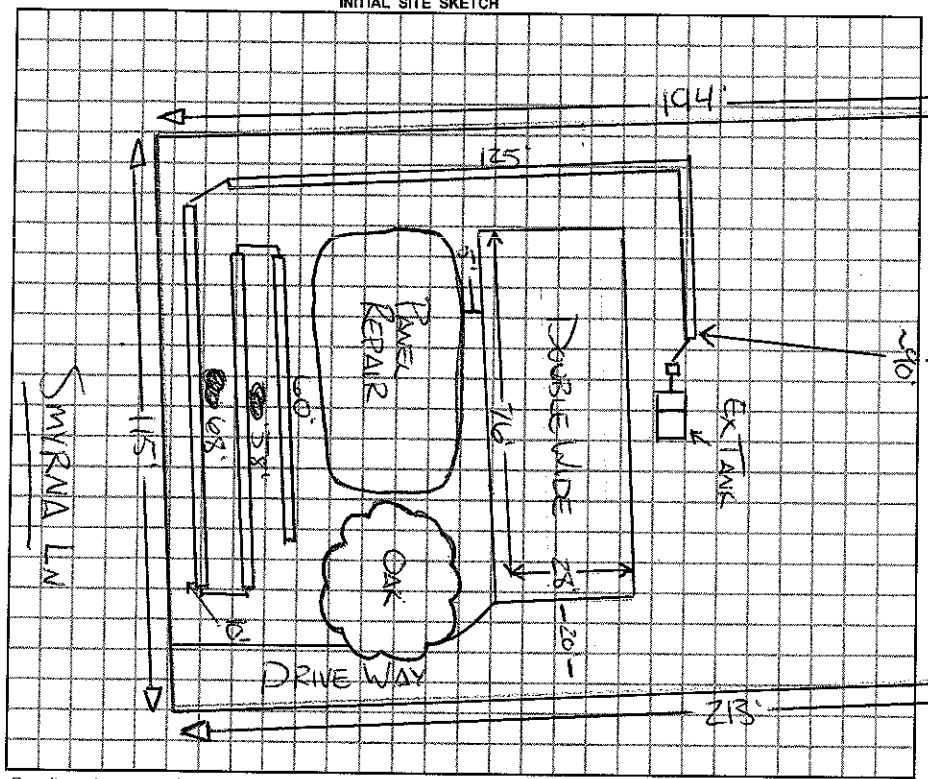

AS BUILT SKETCH

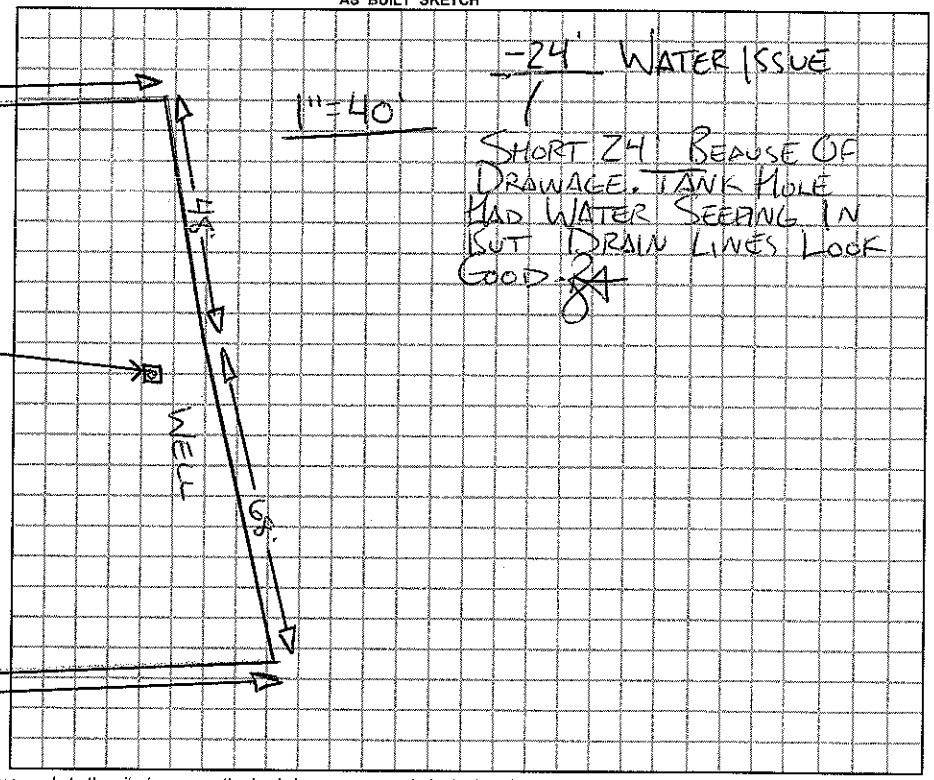

-24' WATER ISSUE

SHORT 24' BEAUSE OF DRAWAGE. TANK HOLE HAD WATER SEEING IN BUT DRAIN LINES LOOK GOOD.

Permit can be suspended or revoked if any false information is supplied toward securing the permit / any unauthorized changes are made to the site / any unauthorized changes are made in the installation of the system.

☐ *IMPROVEMENT PERMIT w / plat valid without expiration.* ☐ *IMPROVEMENT PERMIT w / site plan valid for 60 mos.* ☐ *AUTHORIZATION TO CONSTRUCT valid for period equal to IMPROVEMENT PERMIT-not to exceed 60 mo.*

Owner / Applicant Signature: Kenneth Baxter Date 1-12-11

Improvement Permit by: REHS Date 1-7-11

Authorzation to Construct by: REHS Date 1-7-11

Installed by: A-1 BACKHOE

Operation Permit by: REHS Date: 2-4-11

Existing System Inspected by: Date:

YOU SHOULD CONTACT A LOCATOR SERVICE PRIOR TO ANY EXCAVATION.

WHITE COPY Environmental Health YELLOW COPY (Final) Owner / Applicant PINK COPY (Initial) Owner / Applicant