COPY

IREDELL COUNTY HEALTH DEPARTMENT

STATESVILLE 704-878-5305 MOORESVILLE 704-664-5281

IMPROVEMENT PERMIT / AUTHORIZATION TO CONSTRUCT / OPERATION PERMIT / EXISTING SYSTEM INSPECTION

PERMIT # 16H770 PIN # 4665-26-9112 DATE 1-7-10

OWNER or APPLICANT KENNETH BAXTER PHONE: Business Home:

OWNER or APPLICANT ADDRESS 128 JUNIPER RD MOORESVILLE, NC 28115

LOCATION / DIRECTIONS SHEARERS RD, To SMYRNA

SUBDIVISION IRENE HUFFMAN BLOCK / SECTION LOT # 3 LOT AREA .533 AC DESIGN FLOW 360 L.T.A.R. .3

Septic Tank Ex 1000 Gallons: STB Date

Pump Tank Gallons: P T Date

Pump Make Model Serial #

Nitrification Field No Fields 1 No Lines 3 Linear Feet 186

Trench Width 36" Max. Trench Bottom Depth 36" Gravel Depth —

☐ New System ☐ Repair ☒ Expansion System Type I II (III) IV V VI

System Description: 25% REDUCTION

Repair System Description: PANEL BLOCK

Maintenance Agreement Required ☐ YES ☒ NO

☒ GRAVITY ☐ PRESSURE


☒ Residence No. Bedrooms 3 ☐ Business No. Persons ☐ Other No. Employees ☐ Slab ☒ Crawl Space ☐ Basement w/plumbing ☐ Basement w/o plumbing

Water Supply: ☒ Private ☐ Public ☐ Community


Comments / Conditions ① STAY 10' OFF PROP LINE & 5' OFF FOUNDATION ② USE HYDROLIC CEMENT OR EQUIVALANT TO SEAL OFF ANY PREVIOUSLY USED OUTLETS IN D BOX / OR SET NEW

Comments / Conditions

INITIAL SITE SKETCH

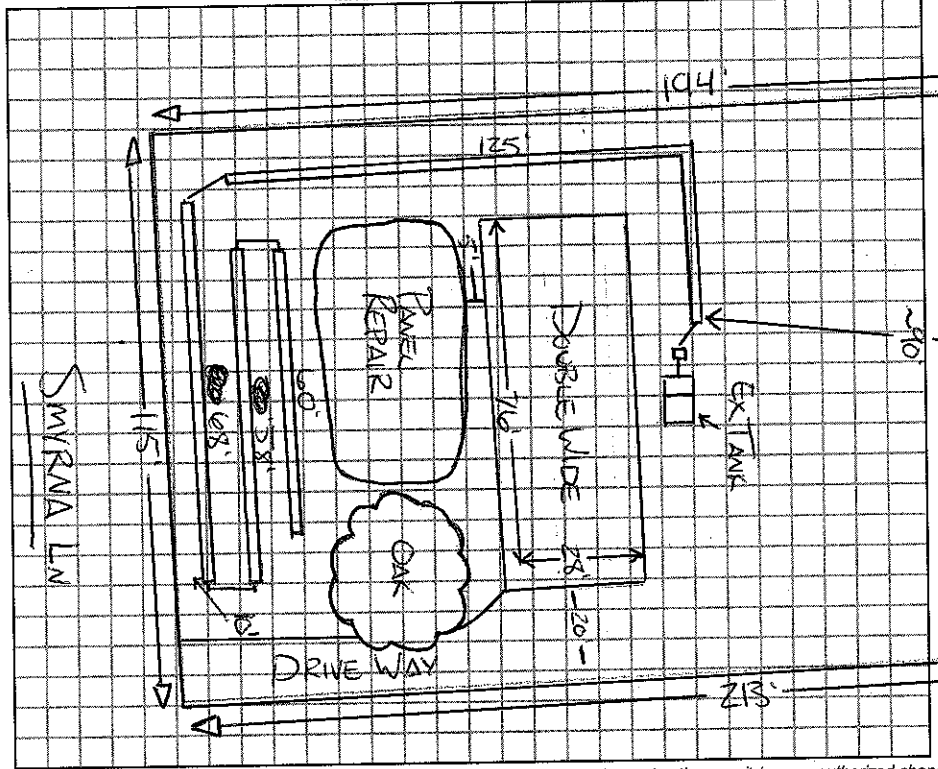

AS BUILT SKETCH

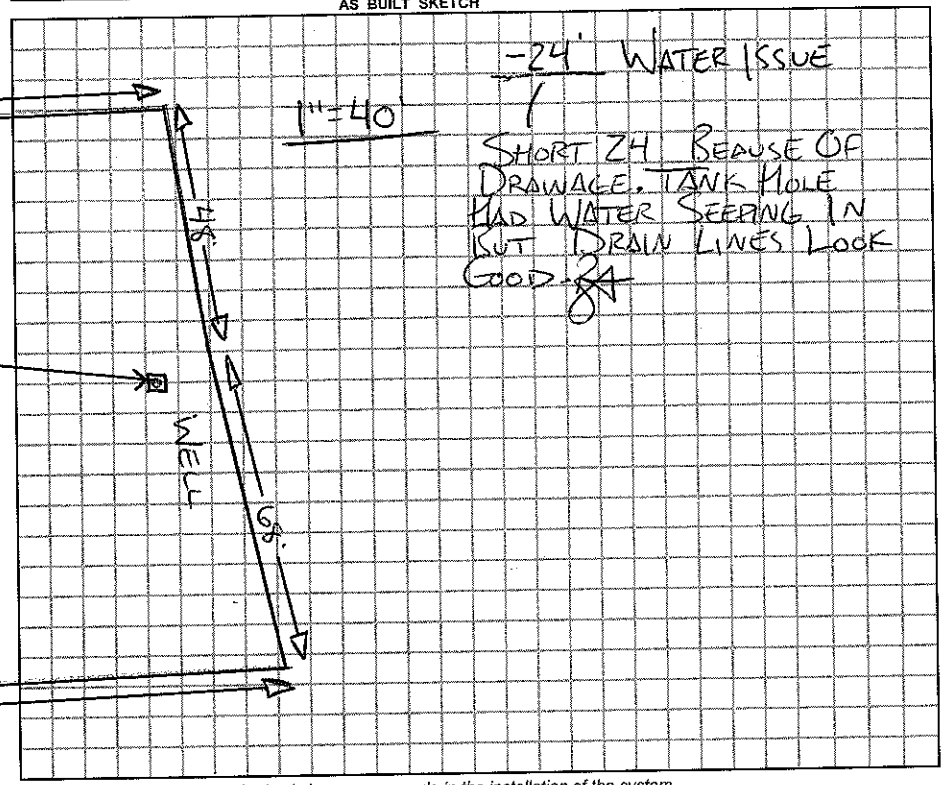

-24' WATER ISSUE

SHORT 24 BEAUSE OF DRAWAGE. TANK HOLE HAD WATER SEEPING IN BUT DRAIN LINES LOOK GOOD-BA

Permit can be suspended or revoked if any false information is supplied toward securing the permit / any unauthorized changes are made to the site / any unauthorized changes are made in the installation of the system.

☐ *IMPROVEMENT PERMIT w / plat valid without expiration.* ☐ *IMPROVEMENT PERMIT w / site plan valid for 60 mos.* ☐ *AUTHORIZATION TO CONSTRUCT valid for period equal to IMPROVEMENT PERMIT-not to exceed 60 mo.*

Owner / Applicant Signature: Date 1-12-11

Improvement Permit by: REHS Date 1-7-11

Authorization to Construct by: REHS Date 1-7-11

Installed by: A-1 BACKHOE

Operation Permit by: REHS Date: 2-4-11

Existing System Inspected by: Date:

YOU SHOULD CONTACT A LOCATOR SERVICE PRIOR TO ANY EXCAVATION.

WHITE COPY Environmental Health YELLOW COPY (Final) Owner / Applicant PINK COPY (Initial) Owner / Applicant