IREDELL COUNTY HEALTH DEPARTMENT

Statesville Office (704) 878-5305 Mooresville Office (704) 660-3625 PERMIT # 203020

IMPROVEMENT PERMIT / AUTHORIZATION TO CONSTRUCT / OPERATION PERMIT / EXISTING SYSTEM

PIN # 4665-26-9457

APPLICANT: Glenda Upright APPLICANT ADDRESS: 702 Linwood Rd Mooresville NC 28115

SITE ADDRESS: 1230 Shearers Rd Mooresville PHONE: 704-724-3803 ALT. PHONE:

SITE DIRECTIONS: Shears Rd S, Lot on R past Fair Rd and Sayrna Ln

SUBDIVISION: SECTION: LOT # LOT AREA: 0.92 ac DESIGN FLOW: 240 gpd L.T.A.R.:

Septic Tank 1000 (gal) STB Date
Pump Tank (gal) PT Date
Pump Make Model Serial #
Nitrification Fields # Lines EXISTING Linear Ft:
Trench Width Max. Trench Bottom Depth Gravel Depth

☐ New System ☑ Repair ☐ Expansion System Type: I (II) III IV V VI
System Description: Existing Cinder Bed
Repair System Description:
Maintenance Agreement Required: ☐ YES ☑ NO
☑ GRAVITY ☐ PRESSURE


☑ Residence No. Bedrooms 2
☐ Business No. Persons 4
☐ Other No. Employees
☐ Slab ☑ Crawl Space
☐ Basement w/plumbing ☐ Basement w/o plumbing

Water Supply: ☑ Private ☐ Public ☐ Community

Comments / Conditions: * Replace Tank, pump, Crush, and backfill existing tank

*Permit issued for 2 bedrooms based on Client Application

INITIAL SITE SKETCH

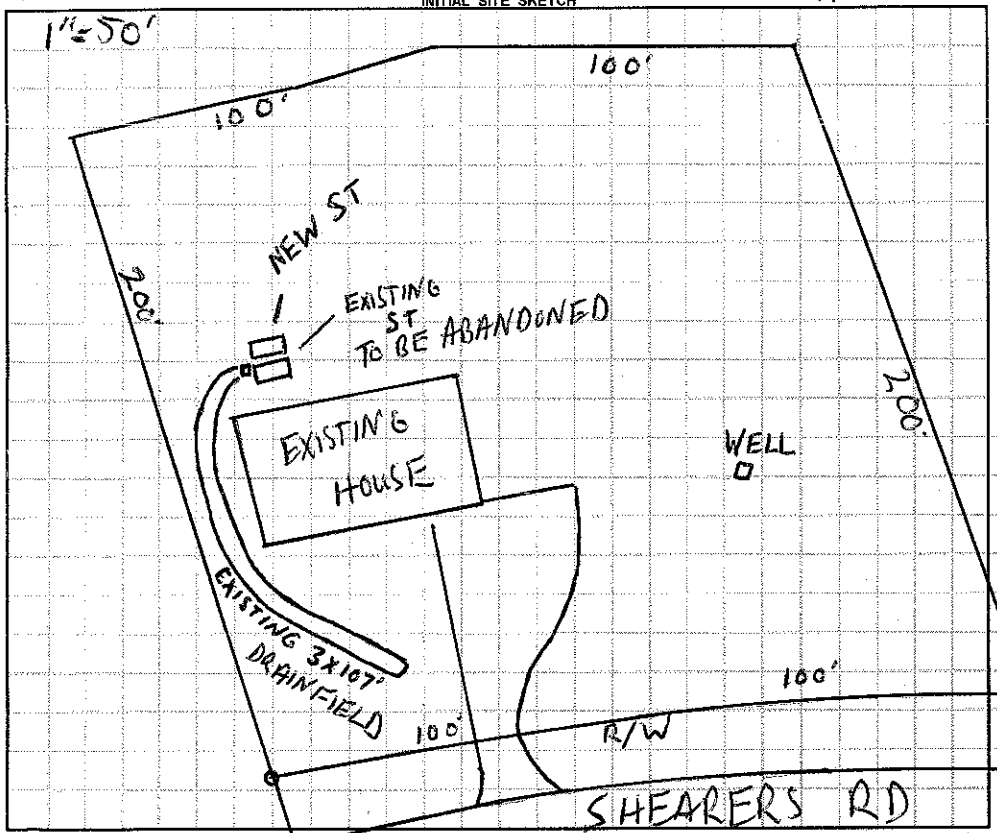

AS BUILT SKETCH

INSTALLED AS SHOWN

Permit can be suspended or revoked if any false information is supplied toward securing the permit / any unauthorized changes are made to the site / any unauthorized changes are made in the installation of the system. **CONTACT A LOCATOR SERVICE PRIOR TO ANY EXCAVATION**

☐ **IMPROVEMENT PERMIT** *with plat valid without expiration.* ☐ **IMPROVEMENT PERMIT** *with site plan valid for 60 mos.* ☐ **AUTHORIZATION TO CONSTRUCT** *valid for period equal to IMPROVEMENT PERMIT--not to exceed 60 mo.*

Owner / Applicant Signature: Date: 5-12-14 Installed by: LENTZ

IMPROVEMENT PERMIT by: Date: 5-9-14 OPERATION PERMIT by: Date: 4-27-14

AUTHORIZATION TO CONSTRUCT by: Date: 5-9-14 Existing System Inspected by: Date:

Health Dept. Copy - WHITE Applicant (Final Approval) - YELLOW Applicant (Conditional Approval) - PINK