IREDELL COUNTY HEALTH DEPARTMENT

STATESVILLE 704-878-5305 MOORESVILLE 704-664-5281

IMPROVEMENT PERMIT / AUTHORIZATION TO CONSTRUCT / OPERATION PERMIT / EXISTING SYSTEM INSPECTION

PERMIT# No PIN# 4606-57-6963-7

DATE 7/18/03

OWNER OR CONTRACTOR Darrell Pennell PHONE: Business Home 704-663-8214

ADDRESS 1222 Shearers Rd. Mooresville, NC. 28115

LOCATION Shearers Rd on (R) past Smyrna Ln.

SUBDIVISION No BLOCK / SECTION LOT LOT AREA SITE CLASS. PS DESIGN FLOW 360 L.T.A.R. .3

Septic Tank: EXISTING Gallons: STB Date

Pump Tank: Gallons; PT Date

Pump Make: Model Serial No.

Nitrification Field: No Fields 1 Square Feet 400 ± Linear Feet 200 ±

No Lines 4 @ 50' Trench Width 2-3' Max Trench Bottom Depth 3' Gravel Depth N/A

☐ New System ☒ Repair System Type: I, II, (III), IV, V, VI

System Description:

Repair System Description: Dawty - 16" PPBPS

Maintenance Agreement Required: ☐ Yes ☒ No

☒ House/Mod. Home No. Bedrooms 3

☐ Mobile Home No. Bathrooms 1

☐ Business No. Employees

☐ Other


☐ Slab ☒ Crawl Space ☐ Basement w/plumbing ☐ Basement wo/plumbing

Water Supply: ☒ Individual ☐ Public ☐ Community

Comments:/Conditions:

Comments:/Conditions:

INITIAL SITE SKETCH

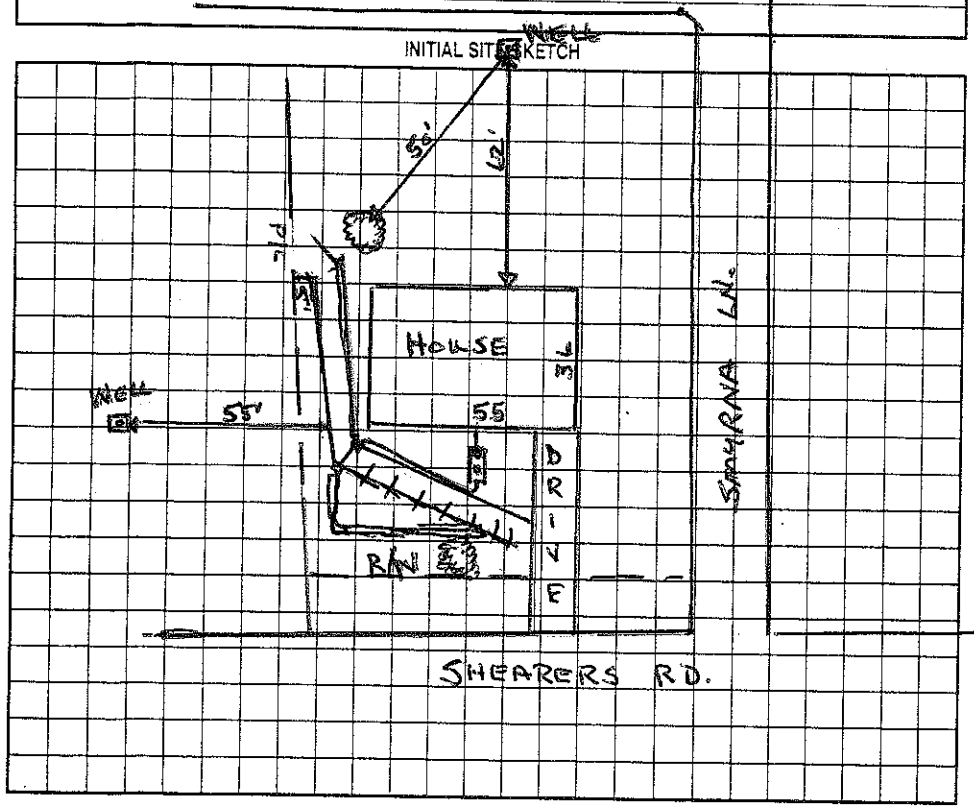

AS BUILT SKETCH

Permit can be suspended or revoked if any false information is supplied toward securing the permit/any unauthorized changes are made to the site/any unauthorized changes are made in the installation of the system. Improvement Permit with plat valid without expiration. Improvement Permit with site plan valid for sixty months. Authorization to Construct is valid for a period equal to that of Improvement Permit – not to exceed sixty months.

Signed: ± Darrell Pennell date 7-24-03

Improvement Permit by: Wesley Sparks RS. date 7/18/03

Authorization to Construct by: Wesley Sparks RS. date 7/18/03

Installed by: Leon Benton

Operation Permit by: Wesley Sparks RS. date 8/15/03

Existing System Inspection by: date

HEALTH DEPT. COPY: WHITE OWNER COPY (FINAL): YELLOW OWNER COPY (INITIAL): PINK