IREDELL COUNTY HEALTH DEPARTMENT

STATESVILLE 704-878-5305 MOORESVILLE 704-664-5281

IMPROVEMENT PERMIT / AUTHORIZATION TO CONSTRUCT / OPERATION PERMIT / EXISTING SYSTEM INSPECTION

gpm

PERMIT # 1604239 PIN # ~~4665295313~~ 4665295313 DATE 12-16-2010

OWNER or APPLICANT James Phillips (Mitch) PHONE: Business 704 763 7833 Home: 704 663-1116

OWNER or APPLICANT ADDRESS 1093 Shearers Rd. Mooresville, NC 28115

LOCATION / DIRECTIONS Hwy 115 S TL Faith Rd TL Shearers Rd house on left (Grey House)

SUBDIVISION — BLOCK / SECTION — LOT # — LOT AREA — DESIGN FLOW 240gpd L.T.A.R. .3

Septic Tank 1000 Gallons: STB 312 Date 9-13-10

Pump Tank — Gallons: P T — Date —

Pump Make — Model — Serial # —

Nitrification Field No Fields 1 No Lines 2 Linear Feet 200'

Trench Width 36" Max. Trench Bottom Depth 36" Gravel Depth N/A

☒ New System ☐ Repair ☐ Expansion System Type I II III IV V VI

System Description: Gravity – 25% Reduction

Repair System Description: Gravity – Conventional

Maintenance Agreement Required ☐ YES ☒ NO

☒ GRAVITY ☐ PRESSURE

☒ Residence No. Bedrooms 2

☐ Business No. Persons —

☐ Other No. Employees —

☐ Slab ☐ Crawl Space


☐ Basement w/plumbing ☐ Basement w/o plumbing

Water Supply: ☒ Private Exist. ☐ Public ☐ Community


Comments / Conditions: Note: Drainfield flagged ~ 40ft behind Metal Bldg. Existing ST must be "properly" abandoned. Must install new Septic System prior to ~~installing~~ destroying Septic System.

Comments / Conditions: Installed Septic System at least 10ft from PL, 50ft from well & 5ft from any Building. Must keep Septic Supply line at least 50ft from well.

INITIAL SITE SKETCH

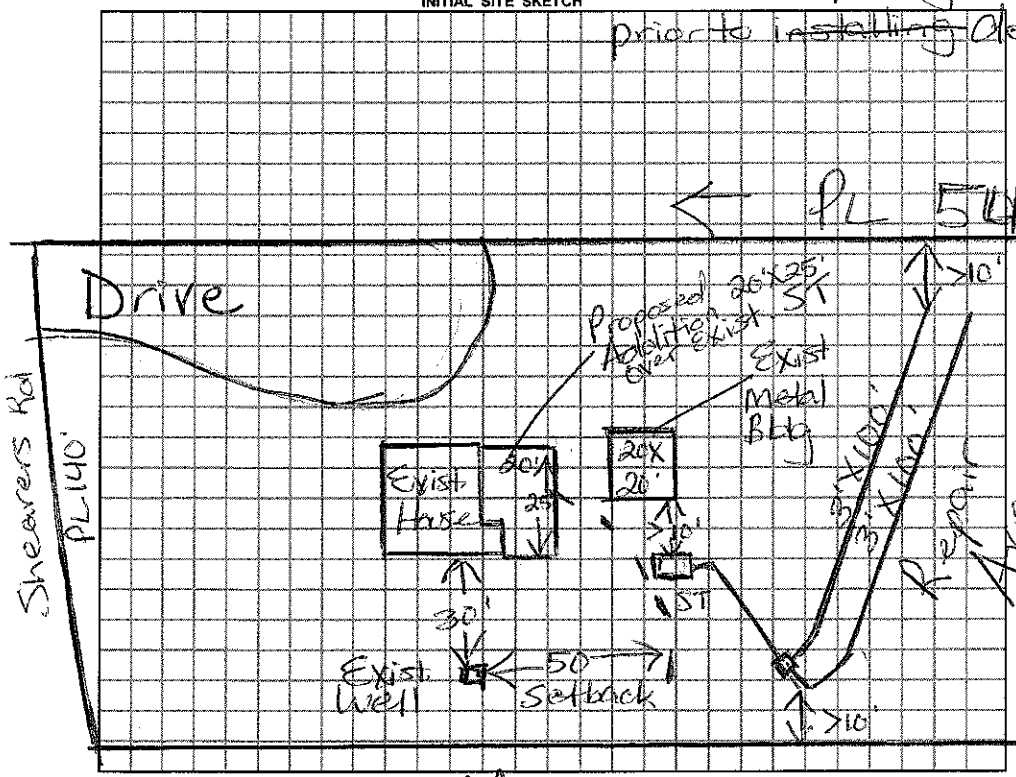

AS BUILT SKETCH

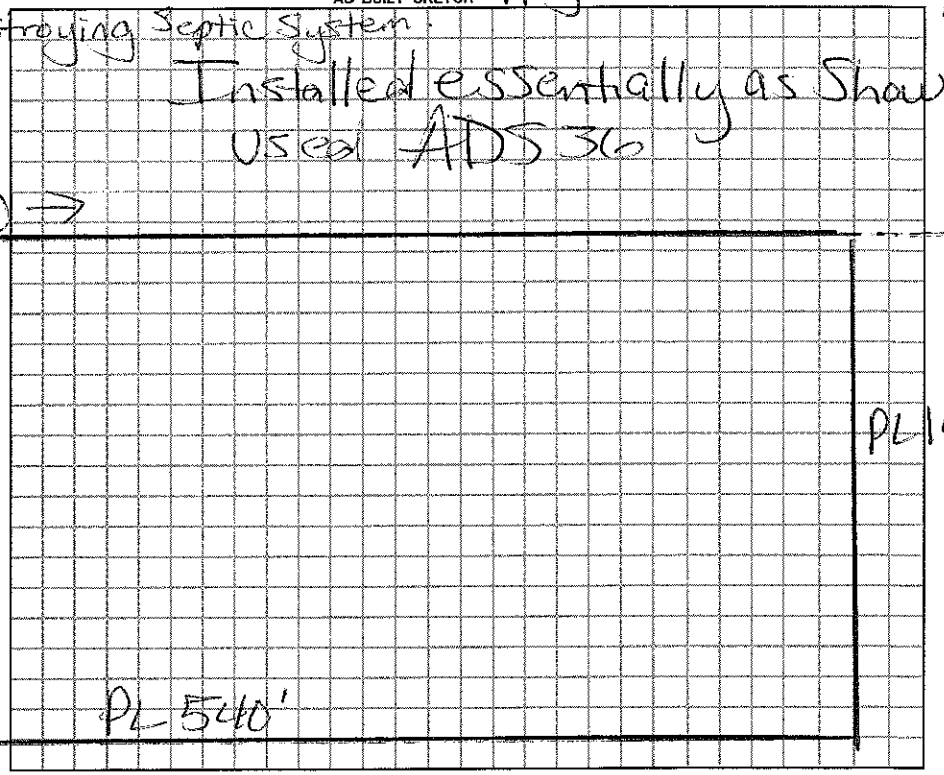

Permit can be suspended or revoked if any false information is supplied toward securing the permit / any unauthorized changes are made to the site / any unauthorized changes are made in the installation of the system.

☐ *IMPROVEMENT PERMIT w / plat valid without expiration.* ☐ *IMPROVEMENT PERMIT w / site plan valid for 60 mos.* ☐ *AUTHORIZATION TO CONSTRUCT valid for period equal to IMPROVEMENT PERMIT not to exceed 60 mo.*

Owner / Applicant Signature: [signature] 12/17/10 Date

Improvement Permit by: [signature] REHS Date 12/16/2010

Authorization to Construct by: [signature] REHS Date 12/16/2010

Installed by: Richard Abernathy

Operation Permit by: [signature] RS Date: 12/30/2011

Existing System Inspected by: — Date: —

YOU SHOULD CONTACT A LOCATOR SERVICE PRIOR TO ANY EXCAVATION.

WHITE COPY Environmental Health YELLOW COPY (Final) Owner / Applicant PINK COPY (Initial) Owner / Applicant