IREDELL COUNTY HEALTH DEPARTMENT

STATESVILLE 704-878-5305 130.00 Paid MOORESVILLE 704-664-5281

IMPROVEMENT PERMIT / AUTHORIZATION TO CONSTRUCT / OPERATION PERMIT / EXISTING SYSTEM INSPECTION

PERMIT# 12702 PIN# 4665 30 3148 DATE 5/25/05

OWNER OR CONTRACTOR Huntington Ridge LLC/ABJ CONST. PHONE: Business 704 664 9080 Home

ADDRESS 255 Rolling Hills Rd Mooresville NC 28117

LOCATION Spearess Rd TR Huntington Ridge, on Lt

SUBDIVISION Huntington Ridge BLOCK / SECTION LOT 26 LOT AREA 3.95AC/0.58 SF SITE CLASS. PS DESIGN FLOW 480 L.T.A.R. 0.3

Septic Tank: 1000 Gallons; STB 312 Date 11/27/05

Pump Tank: 1000 Gallons; PT 27 Date 3/20/06

Pump Make: Goulds Model WE0-S11HN Serial No.

Nitrification Field: No Fields 1 Square Feet 1200 Linear Feet 400'

No Lines 4@100' Trench Width 36" Max Trench Bottom Depth 36" Gravel Depth —

☒ New System ☐ Repair System Type: I, II, (III), IV, V, VI

System Description: Pump 25% Reduction

Repair System Description: Same

Maintenance Agreement Required: ☐ Yes ☒ No

☒ House/Mod. Home No. Bedrooms 4

☐ Mobile Home No. Bathrooms

☐ Business No. Employees

☐ Other

☐ Slab ☐ Crawl Space ☒ Basement w/plumbing ☐ Basement wo/plumbing


Water Supply: ☒ Individual ☐ Public ☐ Community

Comments:/Conditions:


Comments:/Conditions: Installed Drainfield as drawn 4@100' Quick4

797'

INITIAL SITE SKETCH

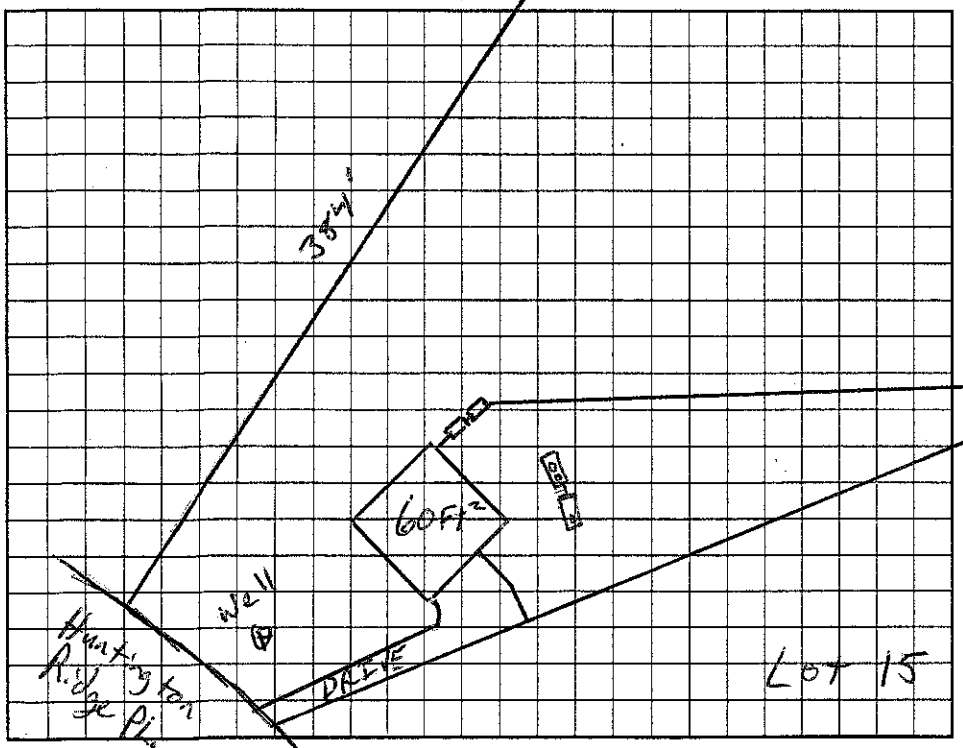

AS BUILT SKETCH

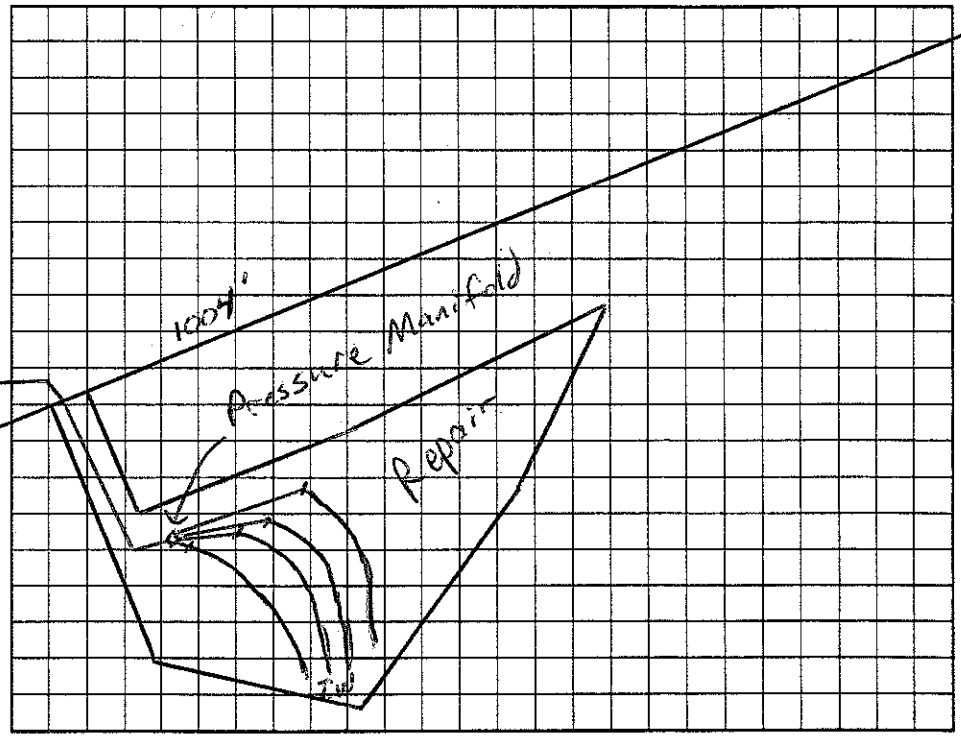

Permit can be suspended or revoked if any false information is supplied toward securing the permit/any unauthorized changes are made to the site/any unauthorized changes are made in the installation of the system. Improvement Permit with plat valid without expiration. Improvement Permit with site plan valid for sixty months. Authorization to Construct is valid for a period equal to that of Improvement Permit – not to exceed sixty months.

Signed: date 5/26/05 Installed by: F.J. Ervin

Improvement Permit by: RS date 5/25/05 Operation Permit by: Judy McNeill date 12-20-06

Authorization to Construct by: RS. date 3/29/06 Existing System Inspection by: date

HEALTH DEPT. COPY: WHITE OWNER COPY (FINAL): YELLOW OWNER COPY (INITIAL): PINK