IREDELL COUNTY HEALTH DEPARTMENT

STATESVILLE 704-878-5305 MOORESVILLE 704-664-5281

IMPROVEMENT PERMIT / AUTHORIZATION TO CONSTRUCT / OPERATION PERMIT / EXISTING SYSTEM INSPECTION

PERMIT# 131349 PIN# 4665 31 5665.007 / 4665 319842 DATE 2/22/06

OWNER OR APPLICANT Topaz Development Inc. PHONE: Business 704-895-5257 Home

ADDRESS 19117 Calloway Hills Ln. Davidson, NC. 28036 / 181 Streamside Pl.

LOCATION Shearer Rd. TR. Streamside to 18th property on (L)

SUBDIVISION Creeksedge BLOCK / SECTION LOT 7 LOT AREA 1.92 AC SITE CLASS. PS DESIGN FLOW 360 L.T.A.R. .25

Septic Tank: 1000 Gallons; STB 317 Date 12/30/06

Pump Tank: 1000 Gallons; PT 27 Date 01/19/07

Pump Make: Myers Model ME-50 Serial No. 1107

Nitrification Field: No Fields 1 Square Feet 720 Linear Feet 240

No Lines 4@60' Trench Width 3' Max Trench Bottom Depth 30-32' Gravel Depth No ☐ Gravity ☒ Pressure

☒ New System ☐ Repair ☐ Expansion System Type: I II III (IV) V VI

System Description: LP - 16" PPBPS

Repair System Description: SHALLOW CONVENTIONAL

Maintenance Agreement Required: ☒ Yes ☐ No

☒ House/Mod. Home ☐ Mobile Home ☐ Business ☐ Other

No. Bedrooms 3 No. Persons 3 No. Employees

Water Supply: ☒ Individual ☐ Public ☐ Community WELL


☐ Slab ☒ Crawl Space ☐ Basement w/plumbing ☐ Basement wo/plumbing

Comments:/Conditions: 3' asked for by Consulting Firm.


Comments:/Conditions:

1"=50'

INITIAL SITE SKETCH

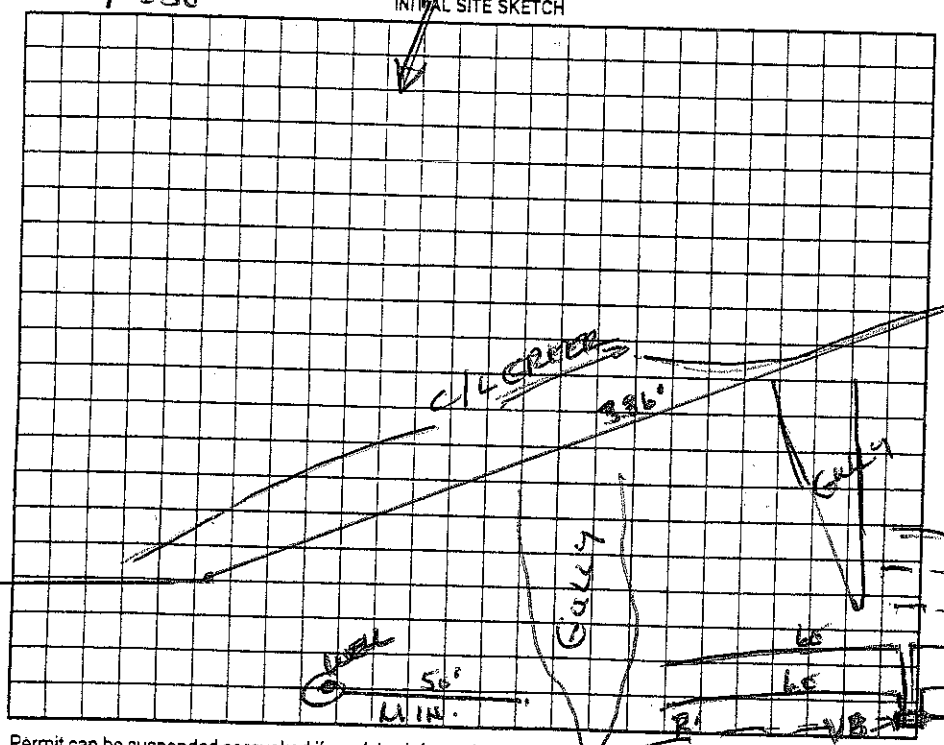

AS BUILT SKETCH

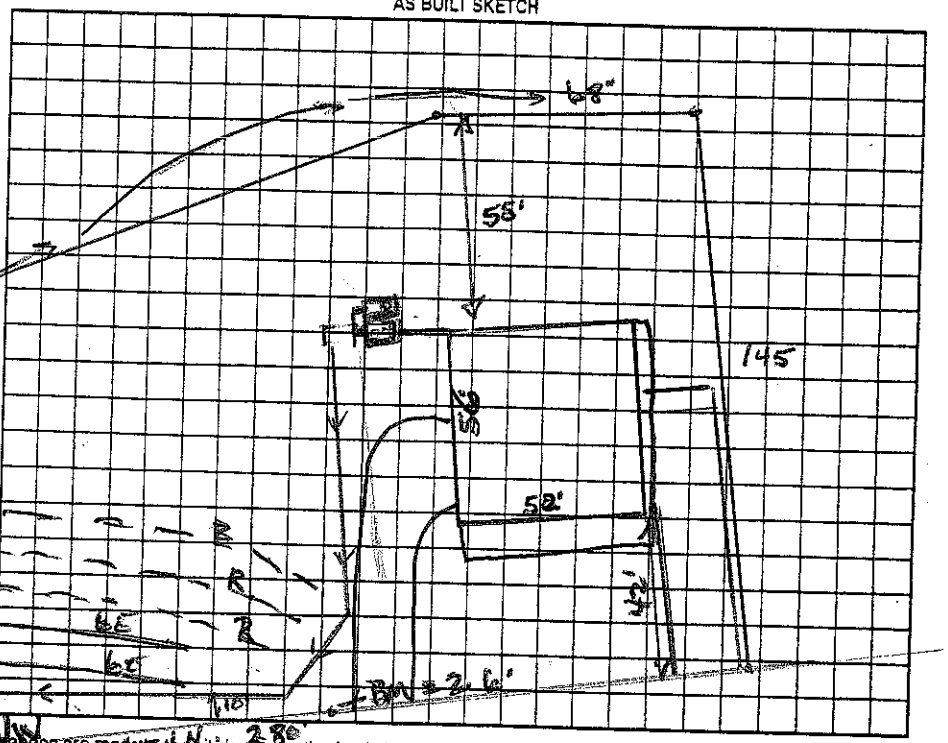

Permit can be suspended or revoked if any false information is supplied toward securing the permit/any unauthorized changes are completed. Authorization to Construct is valid for a period equal to that of Improvement Permit – not to exceed sixty months.

Permit with plat valid without expiration ☐ Improvement Permit with site plan valid for sixty months ☒

Signed: [signature] date 2/23/06 Installed by: Mandy Hopkins Trucking

Improvement Permit by: Wesley Sparks RS. date 2/22/06 Operation Permit by: Wesley Sparks LS date 6/7/07

Authorization to Construct by: Mandy Mitchell date 12-4-06 Existing System Inspection by: date

HEALTH DEPT. COPY: WHITE OWNER COPY (FINAL): YELLOW OWNER COPY (INITIAL): PINK