IREDELL COUNTY HEALTH DEPARTMENT

STATESVILLE 704-878-5305 MOORESVILLE 704-664-5281

IMPROVEMENT PERMIT / AUTHORIZATION TO CONSTRUCT / OPERATION PERMIT / EXISTING SYSTEM INSPECTION

PERMIT# 067426 PIN# 4665328745 / 4665-32-1784 DATE March 15, 2000

OWNER OR CONTRACTOR James McKnight / Rentco II Piedmont Housing PHONE: Business 664-9080 Home

ADDRESS 255 Rolling Hills Rd. Mooresville

LOCATION Shepard Road South TR into Ashley Woods bear Right at end

SUBDIVISION Ashley Woods BLOCK / SECTION LOT 14 LOT AREA .53+ SFE on TRACT B SITE CLASS SFE DESIGN FLOW 360 gpd L.T.A.R. .25-.03

Septic Tank: 1000 Gallons; STB 1012 Date 1-18-2000
Pump Tank: 1000 Gallons; PT 17 Date 11-6-99
Pump Make: Hydromatic Model SK50 Serial No.
Nitrification Field: No Fields 1 Square Feet 1050 Linear Feet 350
No Lines 5@70' Trench Width 36" Max Trench Bottom Depth 36" Gravel Depth NA

☑ New System ☐ Repair System Type: I, II, (III), IV, V, VI
System Description: PM - INNOVATIVE - 25% Reduction
Repair System Description: LP Pave / Block
Maintenance Agreement Required: ☐ Yes ☑ No


☐ House/Mod. Home No. Bedrooms 3
☑ Mobile Home No. Bathrooms 2
☐ Business No. Employees
☐ Other

☐ Slab ☑ Crawl Space ☐ Basement w/plumbing ☐ Basement wo/plumbing

Water Supply: ☐ Individual ☑ Public ☐ Community


Comments/Conditions: *ONE INSPECTION PORT PER LATERAL
INITIAL DRAINFIELD to be located on septic field ESEMENT
3-21-00 Talked w/ Nathan J Piedmont Housing - he agrees/understands specifications of permit. MK

INITIAL SITE SKETCH

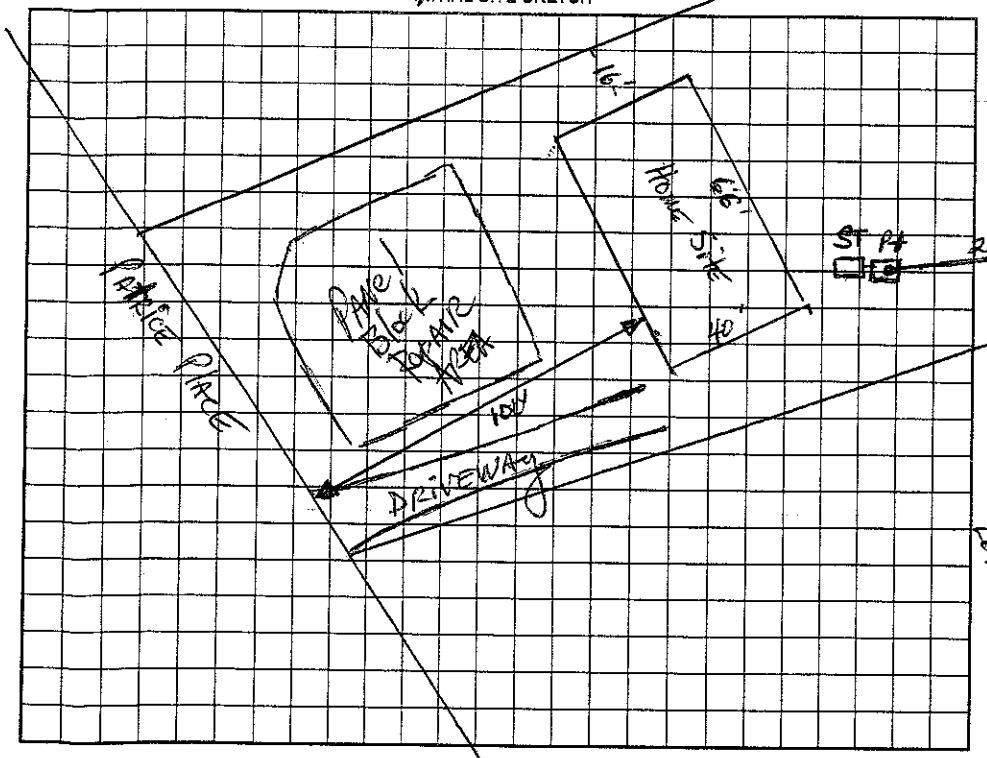

Comments/Conditions: MH Not on site at time of inspection. Pump ~~needs to be set on block~~ Tanks & lines Checked 4/24/2000 MK
Needs to Check PRESSURE

AS BUILT SKETCH

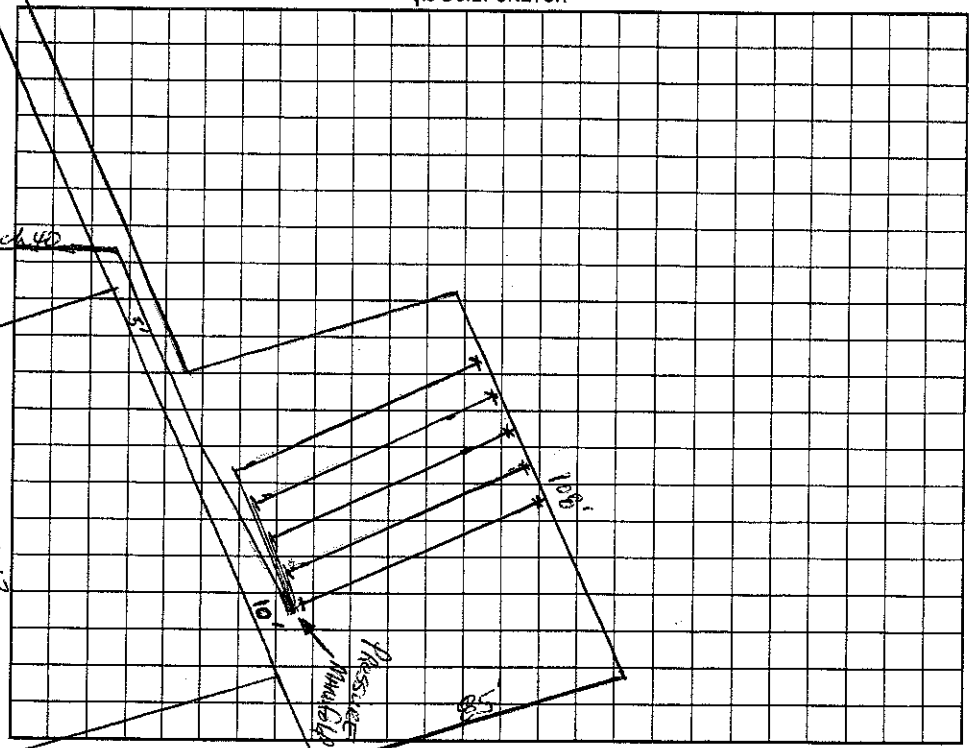

Permit can be suspended or revoked if any false information is supplied toward securing the permit/any unauthorized changes are made to the site/any unauthorized changes are made in the installation of the system. Improvement Permit with plat valid without expiration. Improvement Permit with site plan valid for sixty months. Authorization to Construct is valid for a period equal to that of Improvement Permit – not to exceed sixty months.

Signed: date

Improvement Permit by: Mark Johnson, RS date 3-15-2000

Authorization to Construct by: Mark Johnson, RS date 3-21-00

Installed by: A-1 Backhoe

Operation Permit by: Mark Johnson RS date 6/26/00

Existing System Inspection by: date

HEALTH DEPT. COPY: WHITE OWNER COPY (FINAL): YE