EDELL COUNTY HEALTH DEPARTMENT

Paid 275.00 DT

STATESVILLE 704-878-5305 MOORESVILLE 704-66- 1

MPROVEMENT PERMIT / AUTHORIZATION TO CONSTRUCT / OPERATION PERMIT / EXISTING SYSTEM INSPECTION

PERMIT# 74854 PIN# 4665 32 2452 DATE 8/31/00

OWNER OR CONTRACTOR McKNIGHT ENTERPRISES PHONE: Business 664-9080 Home

ADDRESS 256 ROLLING HILLS RD - MOORESVILLE NC 28115

LOCATION SHEARERS RD - TR ASHLEY WOODS - TL KNIGHT N GALE - ON LT.

SUBDIVISION ASHLEY WOODS BLOCK / SECTION LOT 17 LOT AREA .49AC SITE CLASS. PS DESIGN FLOW 360 GPD L.T.A.R. .256 AC/FT

Septic Tank: 1000 Gallons; STB 1012 Date 9/2/00

Pump Tank: 1000 Gallons; PT 19 Date 9/20/00

Pump Make: Gould Model WE0-311M Serial No. KA042817

Nitrification Field: No Fields 1 Square Feet 1080 Linear Feet 360

No Lines 4 Trench Width 36" Max Trench Bottom Depth 34" Gravel Depth 4"

☒ New System ☐ Repair System Type: I, II, III, IV, V, VI

System Description: PUMP INNOVAIR JR

Repair System Description: PUMP PANEL

Maintenance Agreement Required: ☐ Yes ☒ No

☒ House/Mod. Home No. Bedrooms 3

☐ Mobile Home No. Bathrooms 3

☐ Business No. Employees


☐ Other

☐ Slab ☒ Crawl Space ☐ Basement w/plumbing ☐ Basement wo/plumbing

Water Supply: ☐ Individual ☐ Public ☐ Community

Comments:/Conditions:


INITIAL SITE SKETCH

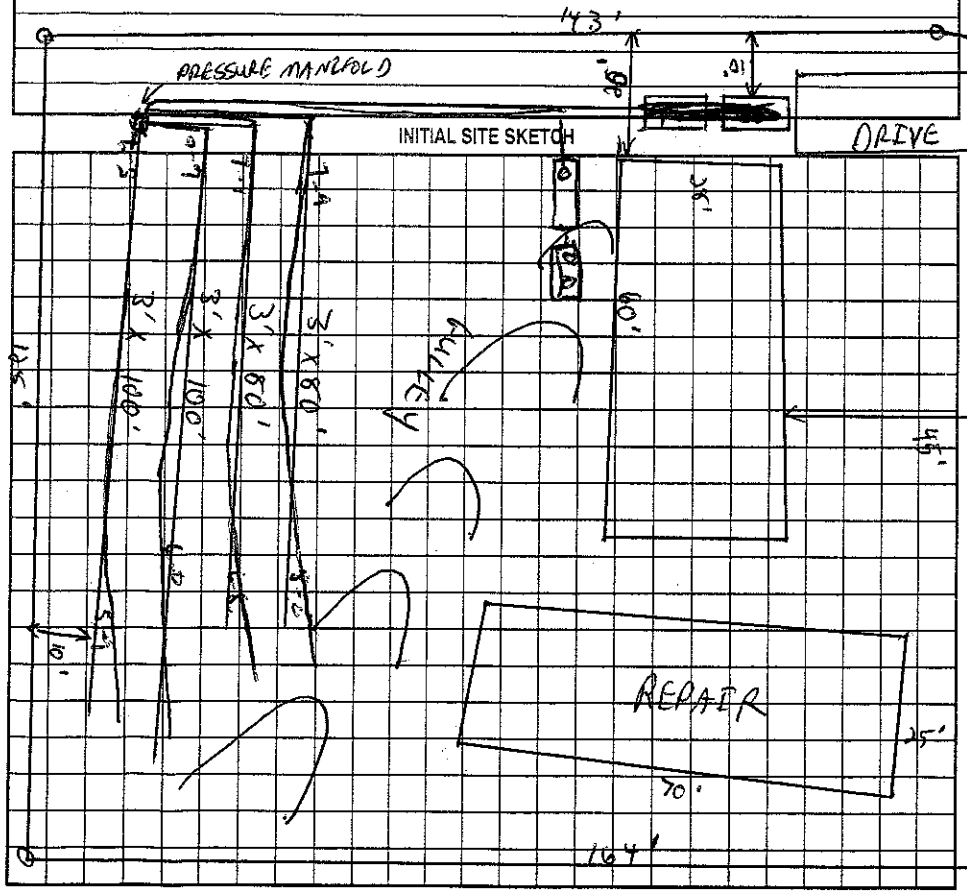

Comments:/Conditions:

1" = 30'

AS BUILT SKETCH

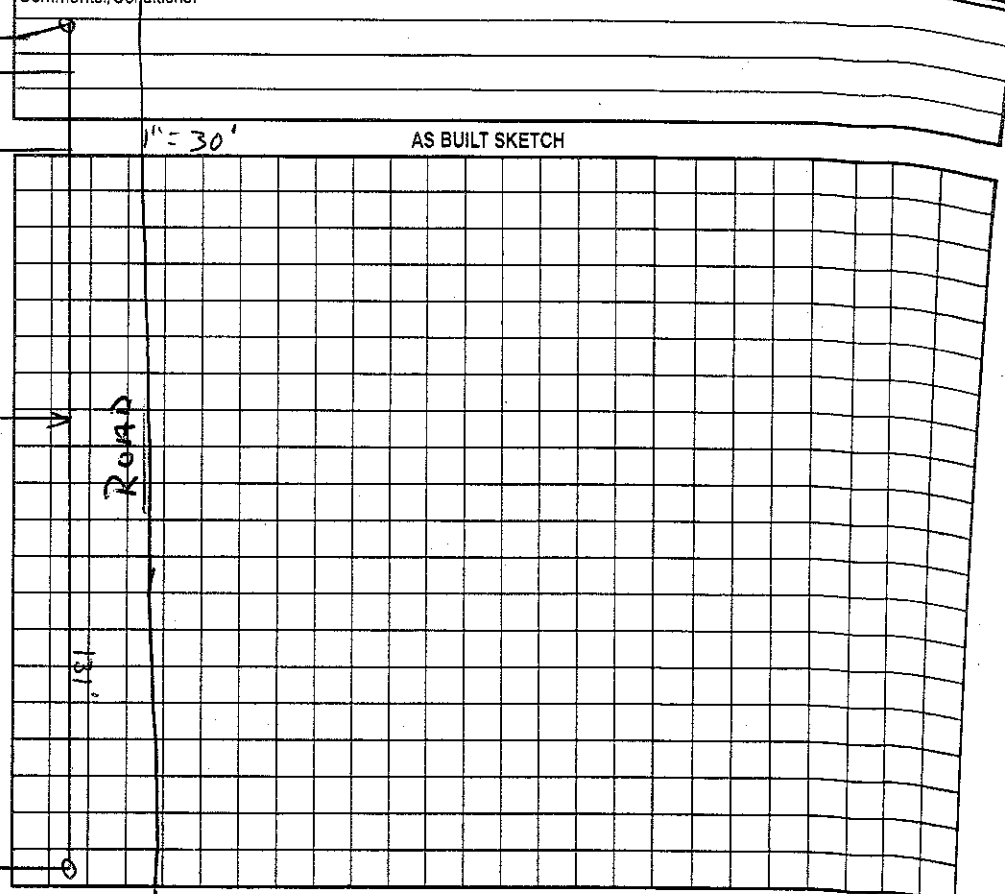

Permit can be suspended or revoked if any false information is supplied toward securing the permit/any unauthorized changes are made to the site/any unauthorized changes are made in the installation of the system. Improvement Permit with plat valid without expiration. Improvement Permit with site plan valid for sixty months. Authorization to Construct is valid for a period equal to that of Improvement Permit – not to exceed sixty months.

Signed: _____ date 9/11/00

Improvement Permit by: _____ date 8/31/00

Authorization to Construct by: _____ date 8/31/00

Installed by: Craig Thompson R.S.

Operation Permit by: _____ date 11/4/2001

Existing System Inspection by: _____ date _____

HEALTH DEPT. COPY: WHITE OWNER COPY (FINAL): YELLOW OWNER COPY (INITIAL): PINK