4:00

IREDELL COUNTY HEALTH DEPARTMENT

STATESVILLE 704-878-5305 MOORESVILLE 704-664-5281

IMPROVEMENT PERMIT / AUTHORIZATION TO CONSTRUCT / OPERATION PERMIT / EXISTING SYSTEM INSPECTION

PERMIT# 7486 | PIN# 4665323485 | DATE 3/3/99

OWNER OR CONTRACTOR McKNIGHT ENTERPRISES | PHONE: Business | Home 664-9050

ADDRESS 255 ROLLING HILLS RD - MOORESVILLE NC 28115

LOCATION SHEARERS - TR ASHLEY WOODS - TL KNIGHT NGALE - ON LT

SUBDIVISION ASHLEY WOODS | BLOCK / SECTION | LOT 18 | LOT AREA .47AC | SITE CLASS. PS | DESIGN FLOW 360 | L.T.A.R. .30 PD/FT2

Septic Tank: 1000 Gallons; STB 825 Date 9-1-99

Pump Tank: Gallons; PT Date

Pump Make: Model Serial No.

Nitrification Field: No Fields 1 Square Feet 900 Linear Feet 300

No Lines 6@50' Trench Width 36" Max Trench Bottom Depth 36" Gravel Depth N/A

☑ New System ☐ Repair System Type: I, II, III, IV, V, VI

System Description: GRAVITY CHAMBERS OR IPS

Repair System Description: PANEL

Maintenance Agreement Required: ☐ Yes ☑ No

☐ House/Mod. Home ☑ Mobile Home ☐ Business ☐ Other

No. Bedrooms 3 No. Bathrooms 2 No. Employees


☐ Slab ☑ Crawl Space ☐ Basement w/plumbing ☐ Basement wo/plumbing

Water Supply: ☐ Individual ☐ Public ☑ Community

Comments:/Conditions: Filter & riser installed on tank

Comments:/Conditions:

INITIAL SITE SKETCH 1"=50'

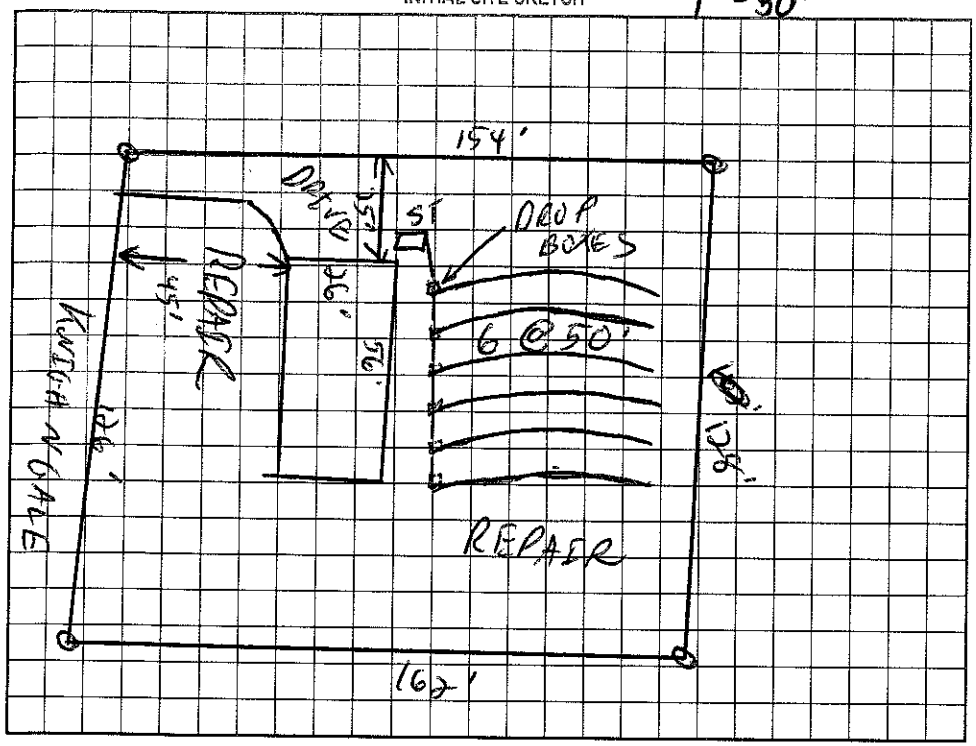

AS BUILT SKETCH

Installed as Drawn

Permit can be suspended or revoked if any false information is supplied toward securing the permit/any unauthorized changes are made to the site/any unauthorized changes are made in the installation of the system. Improvement Permit with plat valid without expiration. Improvement Permit with site plan valid for sixty months. Authorization to Construct is valid for a period equal to that of Improvement Permit – not to exceed sixty months.

Signed: date 7/6/99

Improvement Permit by: RS date 3/3/99

Authorization to Construct by: RS date 3/3/99

Installed by: Piedmont Septic

Operation Permit by: RS date 11/1/99

Existing System Inspection by: date

HEALTH DEPT. COPY: WHITE OWNER COPY (FINAL): YELLOW OWNER COPY (INITIAL): PINK