IREDELL COUNTY HEALTH DEPARTMENT

STATESVILLE 704-878-5305 MOORESVILLE 704-664-5281

IMPROVEMENT PERMIT / AUTHORIZATION TO CONSTRUCT / OPERATION PERMIT / EXISTING SYSTEM INSPECTION

PERMIT# 074872 PIN# 4665323871 DATE 9/21/98

OWNER OR CONTRACTOR McKNIGHT ENTERPRISES PHONE: Business _____ Home _____

ADDRESS 255 ROLLING HILLS RD MOORESVILLE NC 28115

LOCATION SHEARERS RD - TR ASHLEY DR. - CORNER OF LOOP

SUBDIVISION ASHLEY WOODS BLOCK / SECTION _____ LOT 32 LOT AREA .44AC SITE CLASS. PS DESIGN FLOW 360GPD L.T.A.R. .30 PD/FT2

Septic Tank: 1000 Gallons; STB _____ Date _____

Pump Tank: 1000 Gallons; PT _____ Date _____

Pump Make: _____ Model _____ Serial No. _____

Nitrification Field: No Fields 1 Square Feet 402 Linear Feet 201

No Lines 3 @67' Trench Width 24" Max Trench Bottom Depth 36" Gravel Depth N/A

☑ New System ☐ Repair System Type: I, II, (III) IV, V, VI

System Description: PUMP PANEL

Repair System Description: SAME

Maintenance Agreement Required: ☐ Yes ☑ No

☑ House/Mod. Home No. Bedrooms 3

☐ Mobile Home No. Bathrooms 2

☐ Business No. Employees _____

☐ Other _____


☐ Slab ☑ Crawl Space ☐ Basement w/plumbing ☐ Basement wo/plumbing

Water Supply:
☐ Individual
☐ Public
☑ ~~Community~~

Comments:/Conditions:

Comments:/Conditions:

INITIAL SITE SKETCH 1" = 50'

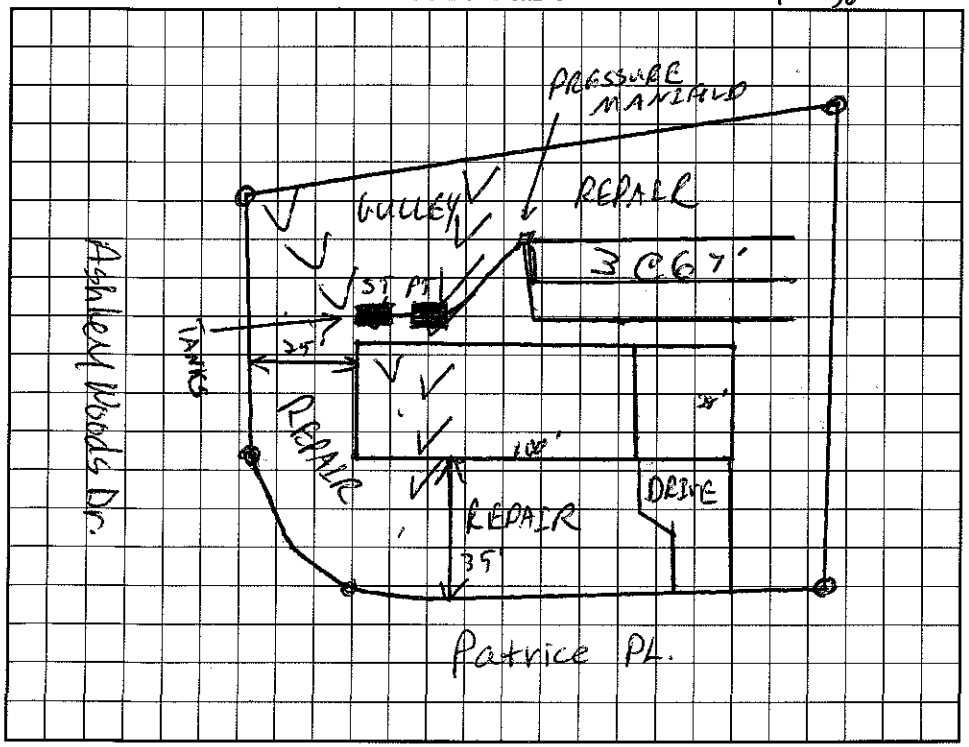

AS BUILT SKETCH

I understand that this permit can be suspended or revoked if any false information is supplied toward securing the permit/any unauthorized changes are made to the site/any unauthorized changes are made in the installation of the system. Improvement Permit with plat valid without expiration. Improvement Permit with site plan valid for sixty months. Authorization to Construct is valid for a period equal to that of Improvement Permit – not to exceed sixty months.

Signed: Jim Teeler date 9-23-98 Installed by: A-1 BACKHOE

Improvement Permit by: C. Ray Jones RS date 9/21/98 Operation Permit by: C. Ray Jones date 12/7/98

Authorization to Construct by: C. Ray Jones RS date 9/21/98 Existing System Inspection by: _____ date _____

HEALTH DEPT. COPY: WHITE INSPECTION COPY (FINAL): GREEN OWNER COPY (FINAL): YELLOW INSPECTION COPY (INITIAL): PINK OWNER COPY (INITIAL): GOLD