...ALTH DEPARTMENT

STATESVILLE 704-878-5305 MOORESVILLE 704-664-5281

...ENT PERMIT / CERTIFICATE OF COMPLETION / OPERATION PERMIT / EXISTING SYSTEM INSPECTION

PROPERTY DESCRIPTION NO. D70472 DATE 12-5-97 TAX MAP NO. 4665324633

OWNER OR CONTRACTOR James McKnight PHONE: Business Watershed: ☐ Yes ☐ No

ADDRESS 255 Rolling Hill Rd Mooresville NC 28115 Home

LOCATION Shegrers Rd TR Ashley Woods go left last on Rt, Corner of Ashley Woods Circle & Knight N Gale

SUBDIVISION Ashley Woods BLOCK / SECTION I LOT 33 LOT AREA .48 Acre SITE CLASS. PS DESIGN FLOW 360gpd L.T.A.R. .3

Septic Tank: 1000 Gallons; STB 1012 Date 9/25/97

Pump Tank: Gallons; PT Date

Pump Make: Model Serial No.

Nitrification Field: No Fields 1 Square Feet * 900 Linear Feet * 360

No Lines 3 at 100' Trench Width 36" Max Trench Bottom Depth 36" Gravel Depth N/A

☒ New System ☐ Repair System Type: I, II, (III) IV, V, VI

System Description: Gravel - Plastic Chamber or Similar

Repair System Description: Gravel/Pump Chamber

Maintenance Agreement Required: ☐ Yes ☒ No

☐ House/Mod. Home No. Bedrooms 3

☒ Mobile Home No. Bathrooms 2

☐ Business No. Employees

☐ Other

☐ Slab ☒ Crawl Space ☐ Basement w/plumbing ☐ Basement wo/plumbing


Water Supply: ☐ Individual ☒ Community ☐ Public

Comments: * 25% reduction of Septic Field for Modified System

Comments:

INITIAL SITE SKETCH

Scale 1:50

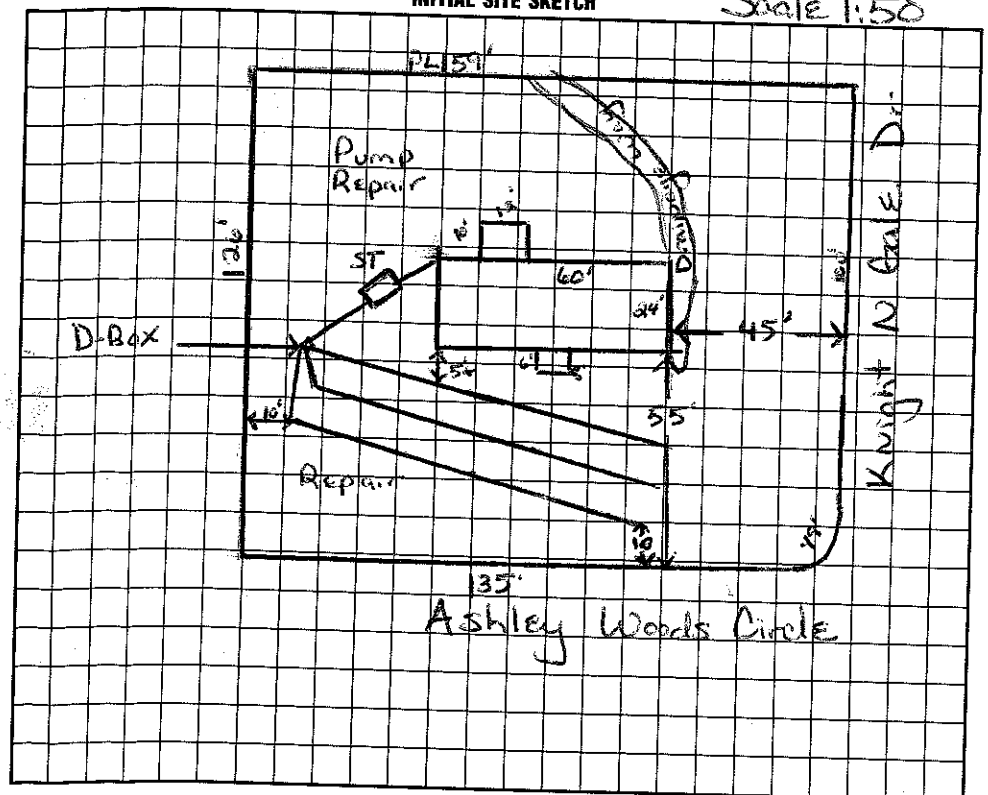

AS BUILT SKETCH

I understand that this permit can be suspended or revoked if any false information is supplied toward securing the permit/any unauthorized changes are made to the site/any unauthorized changes are made in the installation of the system. Improvement Permit is valid for 60 months from date of issuance.

Signed: Russell Dyer

Improvement Permit by: Maria H.H. Dotson date 12/5/97

Existing System Inspection by: Maria H.H. Dotson date 12/5/97

Installed by: A1 BACKHOE

Certificate of Completion by: date

Operation Permit by: C. [signature] date 12/17/97

Construct Auth.

HEALTH DEPT. COPY: WHITE INSPECTION COPY (FINAL): GREEN OWNER COPY (FINAL): YELLOW INSPECTION COPY (INITIAL): PINK OWNER COPY (INITIAL): GOLD