2.30

IREDELL COUNTY HEALTH DEPARTMENT

STATESVILLE 704-878-5305 MOORESVILLE 704-664-5281

IMPROVEMENT PERMIT / AUTHORIZATION TO CONSTRUCT / OPERATION PERMIT / EXISTING SYSTEM INSPECTION

PERMIT# 74862 PIN# 4616532540 6 DATE 10-4-99

OWNER OR CONTRACTOR McKnight Enterprises/Integrity PHONE: Business Home 664-9080

ADDRESS 255 Rolling Hills Rd. Mooresville, NC 28115

LOCATION Shearers Rd TR Ashley Woods TL Knight N Gale on Lt

SUBDIVISION Ashley Woods BLOCK / SECTION LOT 19 LOT AREA .44 Acre SITE CLASS. PS DESIGN FLOW 480gpd L.T.A.R. .3

Septic Tank: 1000 Gallons; STB 1012 Date

Pump Tank: Gallons; PT Date

Pump Make: Model Serial No.

Nitrification Field: No Fields 1 Square Feet 780' Linear Feet 260'

No Lines 5 at 52' Trench Width 36" Max Trench Bottom Depth 30' Gravel Depth N/A

☒ New System ☐ Repair System Type: I, II, III, IV, V, VI

System Description: Gravity – Panel Blk

Repair System Description: Panel Blk

Maintenance Agreement Required: ☐ Yes ☒ No

☐ House/Mod. Home No. Bedrooms 4

☒ Mobile Home No. Bathrooms 3

☐ Business No. Employees

☐ Other


☐ Slab ☒ Crawl Space ☐ Basement w/plumbing ☐ Basement wo/plumbing

Water Supply: ☐ Individual ☒ Public ☒ Community


Comments:/Conditions: 12 Panels per line
Keep Septic System 10' from PL & 5' from house.
Okay to use Distribution box w/Speed levelers.

Comments:/Conditions: Replaces permit dated 3/3/99
Riser & Filter installed
MH not on Site at time of inspection mp

INITIAL SITE SKETCH Scale 1" = 50'

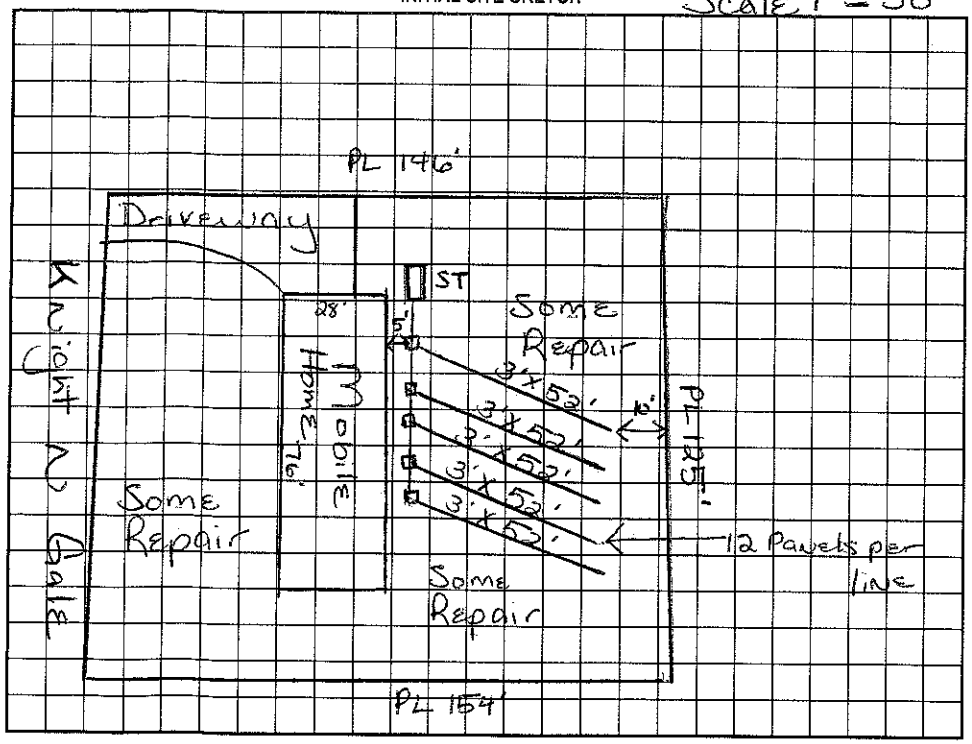

AS BUILT SKETCH

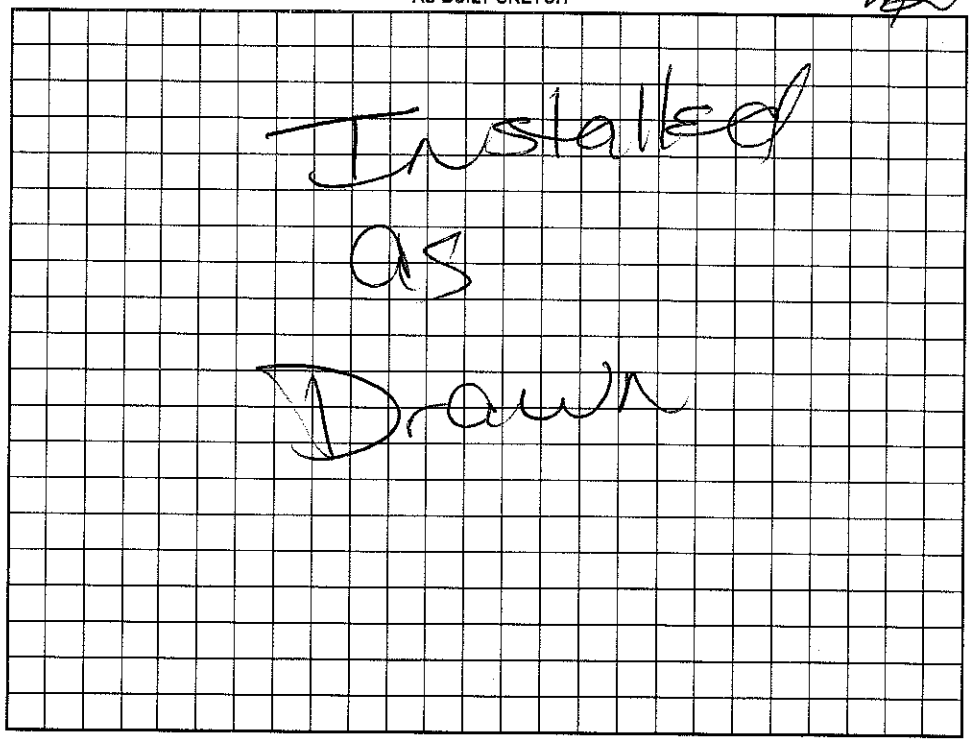

Permit can be suspended or revoked if any false information is supplied toward securing the permit/any unauthorized changes are made to the site/any unauthorized changes are made in the installation of the system. Improvement Permit with plat valid without expiration. Improvement Permit with site plan valid for sixty months. Authorization to Construct is valid for a period equal to that of Improvement Permit – not to exceed sixty months.

Signed: Tim Geeler date 10-8-99 Installed by: A-1 Backhoe

Improvement Permit by: Maria H. H. Dotson R.S. date 10/4/99 Operation Permit by: Maria H. H. Dotson R.S. date 10/19/99

Authorization to Construct by: Maria H. H. Dotson R.S. date 10/4/99 Existing System Inspection by: date

HEALTH DEPT. COPY: WHITE OWNER COPY (FINAL): YELLOW OWNER COPY (INITIAL): PINK