(9:30)

IREDELL COUNTY HEALTH DEPARTMENT

STATESVILLE 704-878-5305 MOORESVILLE 704-664-5281

IMPROVEMENT PERMIT / AUTHORIZATION TO CONSTRUCT / OPERATION PERMIT / EXISTING SYSTEM INSPECTION

PERMIT# 067428 PIN# 4665328745 6438 DATE 1/14/99

OWNER OR CONTRACTOR JAMES McKNIGHT PHONE: Business _____ Home _____

ADDRESS 255 ROLLING HILLS RD MOORESVILLE NC 28115

LOCATION SHEARERS RD - TR ASHLEY WOODS - GO CT ON CT NEAR END

SUBDIVISION ASHLEY WOODS BLOCK / SECTION _____ LOT 20 LOT AREA .44AC SITE CLASS PS DESIGN FLOW 360 GPD L.T.A.R. .3 gpd/ft²

Septic Tank: 1000 Gallons; STB 1012 Date 12/11/98

Pump Tank: _____ Gallons; PT _____ Date _____

Pump Make: _____ Model _____ Serial No. _____

Nitrification Field: No Fields 1 Square Feet 900 Linear Feet 300

No Lines 6@50' Trench Width 36" Max Trench Bottom Depth 36" Gravel Depth N/A

☑ New System ☐ Repair System Type: I, II, III, IV, V, VI

System Description: GRAVITY CHAMBERS/ROCK

Repair System Description: PANEL

Maintenance Agreement Required: ☐ Yes ☑ No

☐ House/Mod. Home No. Bedrooms 3

☑ Mobile Home No. Bathrooms 2

☐ Business No. Employees _____

☐ Other _____


☐ Slab ☐ Crawl Space ☐ Basement w/plumbing ☐ Basement wo/plumbing

Water Supply: ☐ Individual ☐ Public ☑ Community

Comments:/Conditions:

Comments:/Conditions:

INITIAL SITE SKETCH 1"=40'

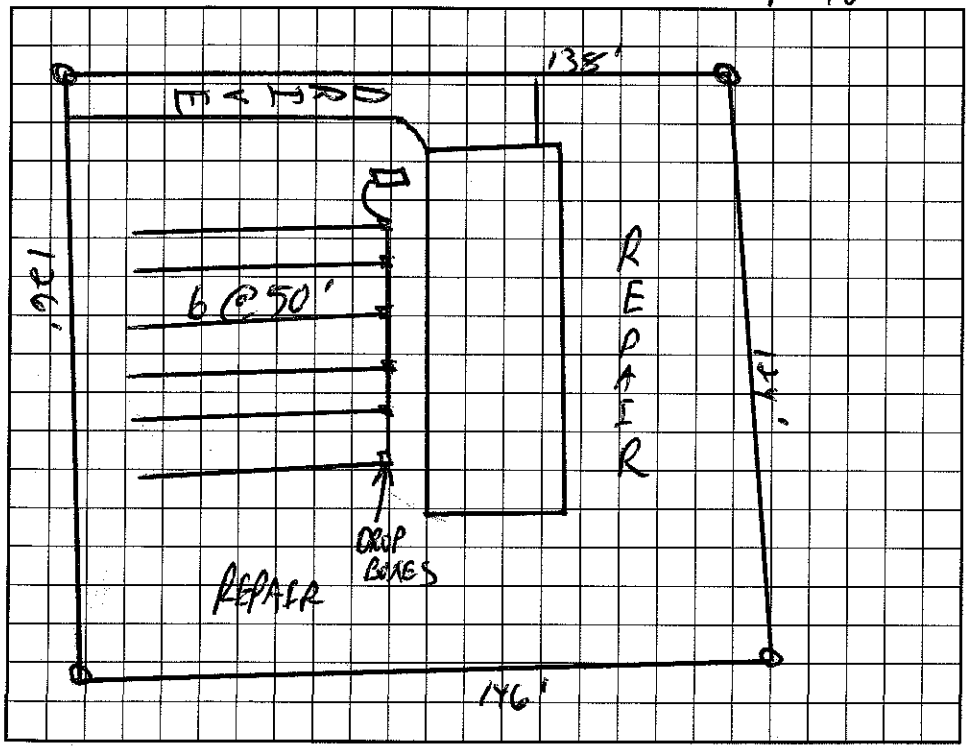

AS BUILT SKETCH

I understand that this permit can be suspended or revoked if any false information is supplied toward securing the permit/any unauthorized changes are made to the site/any unauthorized changes are made in the installation of the system. Improvement Permit with plat valid without expiration. Improvement Permit with site plan valid for sixty months. Authorization to Construct is valid for a period equal to that of Improvement Permit – not to exceed sixty months.

Signed: James Teal date 1/14/99 Installed by: A-1 Backhoe

Improvement Permit by: C. Byrd RS date 1/14/99 Operation Permit by: Jeff Morgan date 1/27/99

Authorization to Construct by: C. Byrd RS date 1/14/99 Existing System Inspection by: _____ date _____

HEALTH DEPT. COPY: WHITE INSPECTION COPY (FINAL): GREEN OWNER COPY (FINAL): YELLOW INSPECTION COPY (INITIAL): PINK OWNER COPY (INITIAL): GOLD