IREDELL COUNTY HEALTH DEPARTMENT

STATESVILLE 704-878-5305 MOORESVILLE 704-664-5281

IMPROVEMENT PERMIT / AUTHORIZATION TO CONSTRUCT / OPERATION PERMIT / EXISTING SYSTEM INSPECTION

PERMIT# 74873 PIN# 4665 32 6695 DATE 3/3/99

OWNER OR CONTRACTOR McKNIGHT ENTERPRISES PHONE: Business Home 664-4080

ADDRESS 255 ROLLING HILLS RD. MOORESVILLE

LOCATION SHEARERS - TR ASHLEY WOODS - TL KNIGHT N GALE - ON LT

SUBDIVISION ASHLEY WOODS BLOCK / SECTION LOT 35 LOT AREA .42AC SITE CLASS. PS DESIGN FLOW 360 L.T.A.R. .30 AD/ET

Septic Tank: 1000 Gallons; STB 760 Date 5/23/99

Pump Tank: Gallons; PT Date

Pump Make: Model Serial No.

Nitrification Field: No Fields 1 Square Feet 900 Linear Feet 300

No Lines 6@50' Trench Width 36" Max Trench Bottom Depth 36" Gravel Depth NA

☑ New System ☐ Repair System Type: I, II, III, IV, V, VI

System Description: GRAVITY CHAMBERS OR HOS

Repair System Description: GRAV/PUMP PANEL

Maintenance Agreement Required: ☐ Yes ☑ No

☐ House/Mod. Home No. Bedrooms 3

☑ Mobile Home No. Bathrooms 2

☐ Business No. Employees

☐ Other


☐ Slab ☑ Crawl Space ☐ Basement w/plumbing ☐ Basement wo/plumbing

Water Supply: ☐ Individual ☐ Public ☐ Community

Comments/Conditions:

Comments/Conditions: 8/4/99 Trailer not on lot.

INITIAL SITE SKETCH 1"=50'

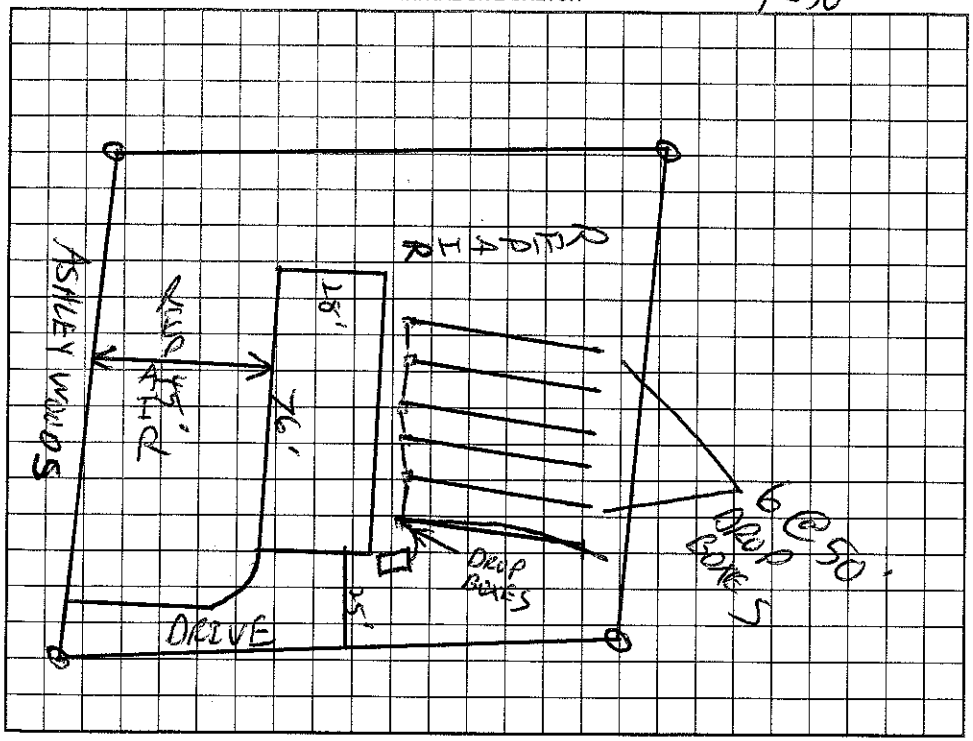

AS BUILT SKETCH

Permit can be suspended or revoked if any false information is supplied toward securing the permit/any unauthorized changes are made to the site/any unauthorized changes are made in the installation of the system. Improvement Permit with plat valid without expiration. Improvement Permit with site plan valid for sixty months. Authorization to Construct is valid for a period equal to that of Improvement Permit – not to exceed sixty months.

Signed: James Feeley date 3/5/99

Improvement Permit by: C. W. Thomas R.S. date 3/3/99

Authorization to Construct by: C. W. Thomas R.S. date 3/3/99

Installed by: Randy Melton

Operation Permit by: Wesley Sparks R.S. date 8/5/99

Existing System Inspection by: date

HEALTH DEPT. COPY: WHITE OWNER COPY (FINAL): YELLOW OWNER COPY (INITIAL): PINK