IREDELL COUNTY HEALTH DEPARTMENT

STATESVILLE 704-878-5305 MOORESVILLE 704-664-5281

IMPROVEMENT PERMIT / AUTHORIZATION TO CONSTRUCT / OPERATION PERMIT / EXISTING SYSTEM INSPECTIO

PERMIT# 074870 PIN# 4665 32-6831 DATE 3/3/99

OWNER OR CONTRACTOR McKNIGHT ENTERPRISES PHONE: Business Home 664-9080

ADDRESS 255 ROLLING HILLS RD MOORESVILLE NC 28115

LOCATION SHEARERS - TR ASHLEY WOODS - ON LT

SUBDIVISION ASHLEY WOODS BLOCK / SECTION LOT 30 LOT AREA SITE CLASS. RS DESIGN FLOW 360 GPD L.T.A.R. - 30.00/FT²

Septic Tank: 1000 Gallons; STB 1012 Date 8-2-99

Pump Tank: Gallons; PT Date

Pump Make: Model Serial No.

Nitrification Field: No Fields 1 Square Feet 400 Linear Feet 200

No Lines 4 @ 50' Trench Width 24" Max Trench Bottom Depth 36" Gravel Depth N/A

☑ New System ☐ Repair System Type: I, II, III, IV, V, VI

System Description: GRAVITY PANEL

Repair System Description: GRAV./PUMP PANEL

Maintenance Agreement Required: ☐ Yes ☑ No

☐ House/Mod. Home No. Bedrooms 3

☑ Mobile Home No. Bathrooms 2

☐ Business No. Employees

☐ Other


☐ Slab ☑ Crawl Space ☐ Basement w/plumbing ☐ Basement wo/plumbing

Water Supply: ☐ Individual ☐ Public ☑ Community


Comments:/Conditions: Home Not on site at time of INSpection

Comments:/Conditions Checked 1st, Trench 2nd, 3rd & 4th

INITIAL SITE SKETCH 1" = 50'

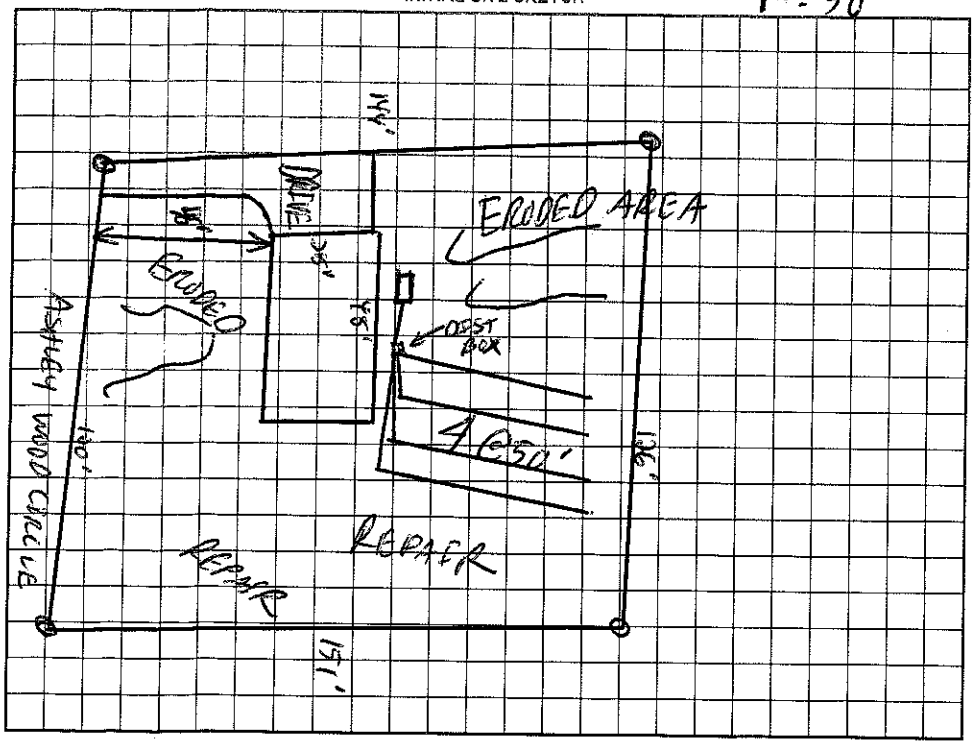

AS BUILT SKETCH

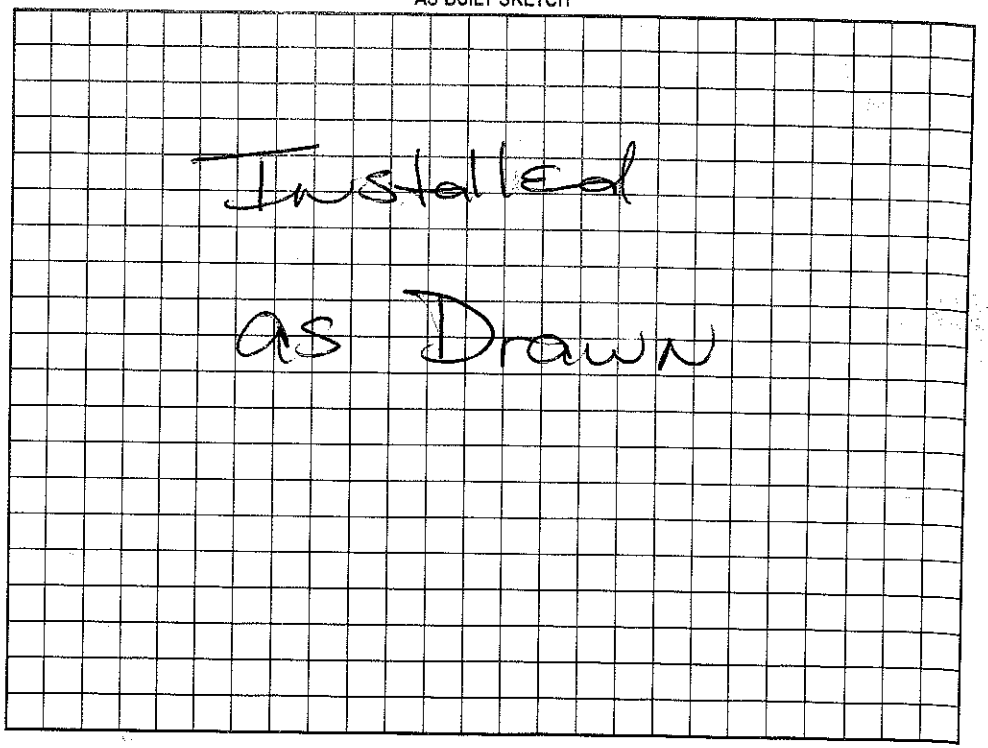

Permit can be suspended or revoked if any false information is supplied toward securing the permit/any unauthorized changes are made to the site/any unauthorized changes are made in the installation of the system. Improvement Permit with plat valid without expiration. Improvement Permit with site plan valid for sixty months. Authorization to Construct is valid for a period equal to that of Improvement Permit – not to exceed sixty months.

Signed: date 7/6/99

Improvement Permit by: KS date 3/3/99

Authorization to Construct by: KS date 3/3/99

Installed by: A-1 Backhoe

Operation Permit by: KS date 10/8/99

Existing System Inspection by: date

HEALTH DEPT. COPY: WHITE OWNER COPY (FINAL): YELLOW OWNER COPY (INITIAL): PINK