IREDELL COUNTY HEALTH DEPARTMENT

AUTHORIZATION TO CONSTRUCT

STATESVILLE 704-878-5305 MOORESVILLE 704-664-

IMPROVEMENT PERMIT / ~~CERTIFICATE OF COMPLETION~~ / OPERATION PERMIT / EXISTING SYSTEM INSPECTION

PROPERTY DESCRIPTION NO. 06-7415 DATE 11/12/97 TAX MAP NO. ~~6674546653289745~~ 6989 Watershed: ☐ Yes ☒ No

OWNER OR CONTRACTOR JAMES McKNIGHT PHONE: Business _____ Home 664-7050

ADDRESS 255 ROLLING HILLS RD. MOORESVILLE NC 28115

LOCATION ~~Hwy~~ SHEARERS RD - TR ASHLEY DR - ON RT

SUBDIVISION ASHLEY WOODS BLOCK / SECTION _____ LOT 8 LOT AREA .77AC SITE CLASS. PS DESIGN FLOW 360 GPD L.T.A.R. .36 GPD/FT²

Septic Tank: 1000 Gallons; STB 1012 Date 9/24/97

Pump Tank: _____ Gallons; PT _____ Date _____

Pump Make: _____ Model _____ Serial No. _____

Nitrification Field: No Fields 1 Square Feet 900 Linear Feet 300

No Lines 6 @ 50' Trench Width 36" Max Trench Bottom Depth 36" Gravel Depth N/A

☒ New System ☐ Repair System Type: I, II, (III), IV, V, VI

System Description: GRAVITY CHAMBER FOR HDS

Repair System Description: PANEL

Maintenance Agreement Required: ☐ Yes ☒ No

☐ House/Mod. Home ☒ Mobile Home ☐ Business ☐ Other

No. Bedrooms 3 No. Bathrooms 3 No. Employees _____


☐ Slab ☒ Crawl Space ☐ Basement w/plumbing ☐ Basement wo/plumbing

Water Supply: ☐ Individual ☒ Community ☐ Public

Comments:

Comments:

INITIAL SITE SKETCH 1"=60'

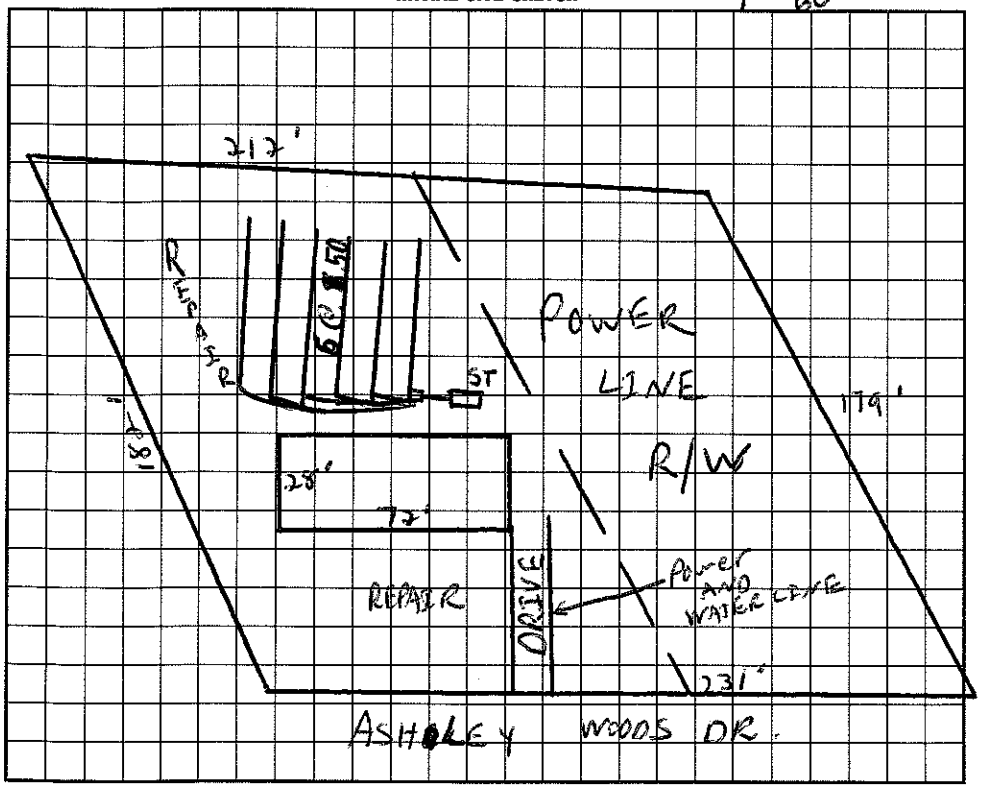

AS BUILT SKETCH

I understand that this permit can be suspended or revoked if any false information is supplied toward securing the permit/any unauthorized changes are made to the site/any unauthorized changes are made in the installation of the system. Improvement Permit is valid for 60 months from date of issuance.

Signed: _____

Improvement Permit by: C. Brady Teem RS date 11/12/97

~~Existing System Inspection~~ AUTHORIZATION TO CONSTRUCT by: C. Brady Teem RS date 11/12/97

Installed by: A1 BACKHOE

Certificate of Completion by: _____ date _____

Operation Permit by: C. Brady Teem date 12/4/97

HEALTH DEPT. COPY: WHITE INSPECTION COPY (FINAL): GREEN OWNER COPY (FINAL): YELLOW INSPECTION COPY (INITIAL): PINK OWNER COPY (INITIAL): GOLD