IREDELL COUNTY HEALTH DEPARTMENT

STATESVILLE 704-878-5305 MOORESVILLE 704-664-5281

IMPROVEMENT PERMIT / AUTHORIZATION TO CONSTRUCT / OPERATION PERMIT / EXISTING SYSTEM INSPECTION

PERMIT# 074863 PIN# 4665 32 75 71 DATE 2/10/99

OWNER OR CONTRACTOR MCKNIGHT ENTERPRISES PHONE: Business _____ Home _____

ADDRESS @ 255 ROLLING HILLS RD - MOORESVILLE NC 28115

LOCATION SHEARERS RD - TR ASHLEY WOODS - TL KNIGHT N GALE - ON LT

SUBDIVISION ASHLEY WOODS BLOCK / SECTION _____ LOT 21 LOT AREA .47AC SITE CLASS. PS DESIGN FLOW 360 GPD T.A.R. .30 DPD/FT²

Septic Tank: 1000 Gallons; STB 1015 Date 12/28/99
Pump Tank: _____ Gallons; PT _____ Date _____
Pump Make: _____ Model _____ Serial No. _____
Nitrification Field: No Fields 1 Square Feet 900 Linear Feet 300
No Lines 3 @100' Trench Width 36" Max Trench Bottom Depth 36" Gravel Depth N/A

☒ New System ☐ Repair System Type: I, II, (III), IV, V, VI
System Description: GRAVITY CHAMBERS OR RDS
Repair System Description: GRAV./PUMP PANEL
Maintenance Agreement Required: ☐ Yes ☒ No


☒ House/Mod. Home No. Bedrooms 3
☐ Mobile Home No. Bathrooms 3
☐ Business No. Employees ____
☐ Other _____
☐ Slab ☒ Crawl Space ☐ Basement w/plumbing ☐ Basement wo/plumbing

Water Supply:
☐ Individual
☐ Public
☐ Community

Comments:/Conditions:

Comments:/Conditions:

INITIAL SITE SKETCH 1"=40'

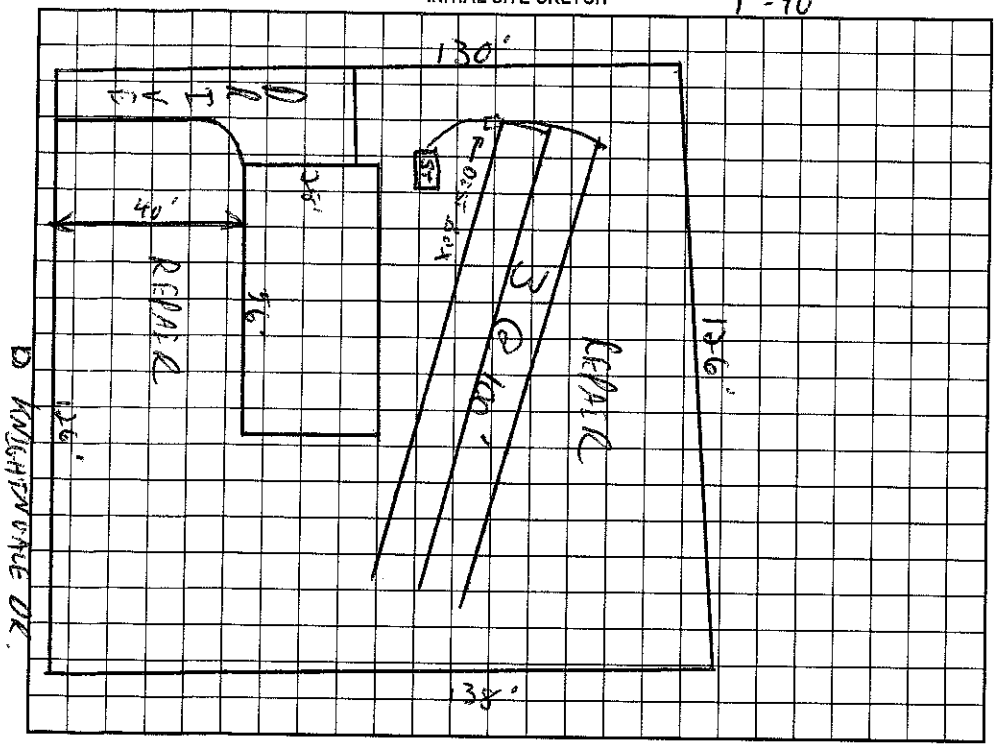

AS BUILT SKETCH

Permit can be suspended or revoked if any false information is supplied toward securing the permit/any unauthorized changes are made to the site/any unauthorized changes are made in the installation of the system. Improvement Permit with plat valid without expiration. Improvement Permit with site plan valid for sixty months. Authorization to Construct is valid for a period equal to that of Improvement Permit – not to exceed sixty months.

Signed: _____ date 2-10-99 Installed by: A1 BACKHOE

Improvement Permit by: C. Ryan CS date 2/10/99 Operation Permit by: C. Ryan CS date 2/15/99

Authorization to Construct by: C. Ryan CS date 2/10/99 Existing System Inspection by: _____ date _____

HEALTH DEPT. COPY: WHITE OWNER COPY (FINAL): YELLOW OWNER COPY (INITIAL): PINK