IREDELL COUNTY HEALTH DEPARTMENT

STATESVILLE 704-878-5305 MOORESVILLE 704-664-5281

IMPROVEMENT PERMIT / AUTHORIZATION TO CONSTRUCT / OPERATION PERMIT / EXISTING SYSTEM INSPECTION

PERMIT# 074869 PIN# 4665327892 DATE 10/23/98

OWNER OR CONTRACTOR McKnight, James PHONE: Business 664-9080 Home

ADDRESS 255 Rolling Hills Rd. Mooresville NC 28115

LOCATION Shearers Rd. TR Ashley Woods (On Right after Rocky River Rd) stay Right at fork on left

SUBDIVISION Ashley Woods BLOCK / SECTION 1 LOT 29 LOT AREA .59 Acre SITE CLASS. PS DESIGN FLOW 360gpd L.T.A.R. .3

Septic Tank: 1000 Gallons; STB 1012 Date 9/16/98

Pump Tank: Gallons; PT Date

Pump Make: Model Serial No.

Nitrification Field: No Fields 1 Square Feet 600' Linear Feet 200'

No Lines 4@50'eq Trench Width 36" Max Trench Bottom Depth 30" Gravel Depth N/A

[X] New System [ ] Repair System Type: I, II, III, IV, V, VI

System Description: Gravity - Panel Block ++

Repair System Description: Same

Maintenance Agreement Required: [ ] Yes [X] No

[ ] House/Mod. Home [X] Mobile Home [ ] Business [ ] Other

No. Bedrooms 3 No. Bathrooms 2 No. Employees


[ ] Slab [X] Crawl Space [ ] Basement w/plumbing [ ] Basement wo/plumbing

Water Supply: [ ] Individual [ ] Public [X] Community

Comments:/Conditions: *Setback House from Street ROW 35-40'-Do Not Exceed 40'. Keep Septic System 10' from PL & 5' from House.

Comments:/Conditions: ++ 50% Reduction in Drainfield Area.

INITIAL SITE SKETCH Scale 1:50

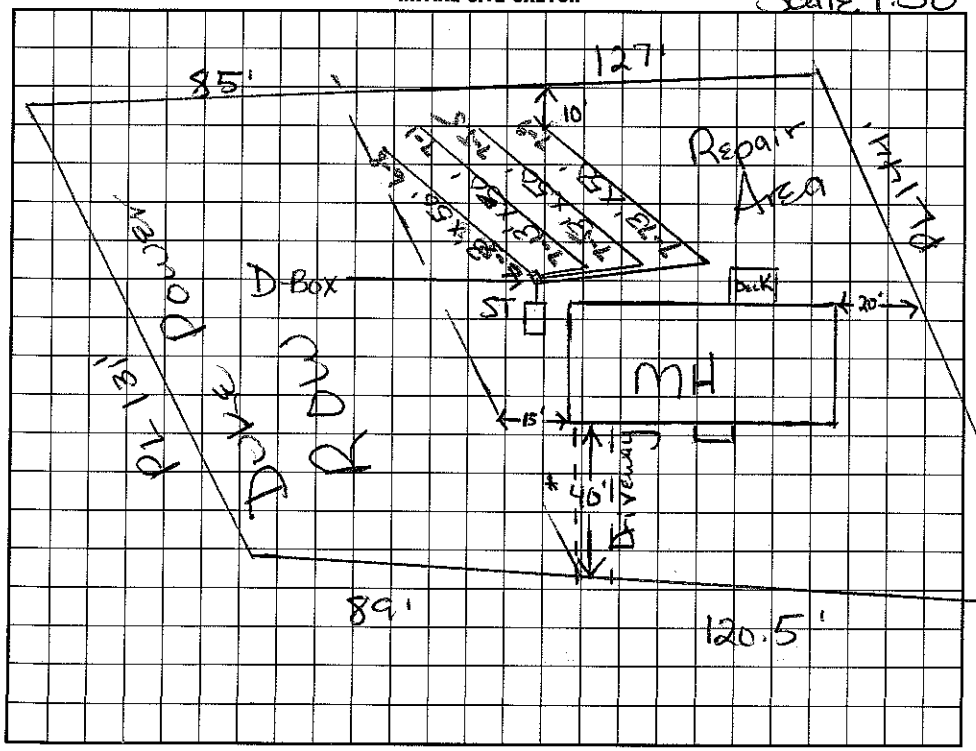

AS BUILT SKETCH

I understand that this permit can be suspended or revoked if any false information is supplied toward securing the permit/any unauthorized changes are made to the site/any unauthorized changes are made in the installation of the system. Improvement Permit with plat valid without expiration. Improvement Permit with site plan valid for sixty months. Authorization to Construct is valid for a period equal to that of Improvement Permit – not to exceed sixty months.

Signed: Jim Cooler date 10-26-98 Installed by: A-1 Backhoe

Improvement Permit by: Maria H. Dotson RS date 10/23/98 Operation Permit by: Wesley Sparks RS. date 11/19/98

Authorization to Construct by: Maria H. Dotson date 10/23/98 Existing System Inspection by: date

HEALTH DEPT. COPY: WHITE INSPECTION COPY (FINAL): GREEN OWNER COPY (FINAL): YELLOW INSPECTION COPY (INITIAL): PINK OWNER COPY (INITIAL): GOLD