4665 32 8051

IREDELL COUNTY HEALTH DEPARTMENT

STATESVILLE 704-878-5305 MOORESVILLE 704-664-5281

IMPROVEMENT PERMIT / CERTIFICATE OF COMPLETION / OPERATION PERMIT / EXISTING SYSTEM INSPECTION

PROPERTY DESCRIPTION NO. 20335 DATE 2/22/95 TAX MAP NO. 1C 3A 7 Watershed: ☐ Yes ☒ No

OWNER OR CONTRACTOR Randall Phillips PHONE: Business _____ Home 664-6435

ADDRESS Rt 10 Box 663-C Mooresville, NC 28115

LOCATION Sherrills Ford, TR on Wildwood CR, on (L) ~ 1/2 way down road

SUBDIVISION Wildwood Acres BLOCK / SECTION 1 LOT 7 LOT AREA ~1.62 AC. SITE CLASS. P DESIGN FLOW 360 L.T.A.R. .3

Septic Tank: 1000 Gallons; STB 794 Date 11-11-94

Pump Tank: _____ Gallons; PT _____ Date _____

Pump Make: _____ Model _____ Serial No. _____

Nitrification Field: No Fields 1 Square Feet 1200 Linear Feet 400

No Lines 5 Trench Width 36" Max Trench Bottom Depth 30-32" Gravel Depth 12"

☒ New System ☐ Repair System Type: I, II, III, IV, V, VI

System Description: CONV - DROP BOX

Repair System Description: SAME

Maintenance Agreement Required: ☐ Yes ☒ No

☒ House/Mod. Home No. Bedrooms 3

☐ Mobile Home No. Bathrooms 2

☐ Business No. Employees _____

☐ Other _____


☐ Slab ☒ Crawl Space ☐ Basement w/plumbing ☐ Basement wo/plumbing

Water Supply: ☒ Individual ☐ Community ☐ Public


Comments:

Comments: SAME AS INITIAL SKETCH. Lot. Home not located at time of inspection. Keep the Home the required distance from any part of septic system.

INITIAL SITE SKETCH

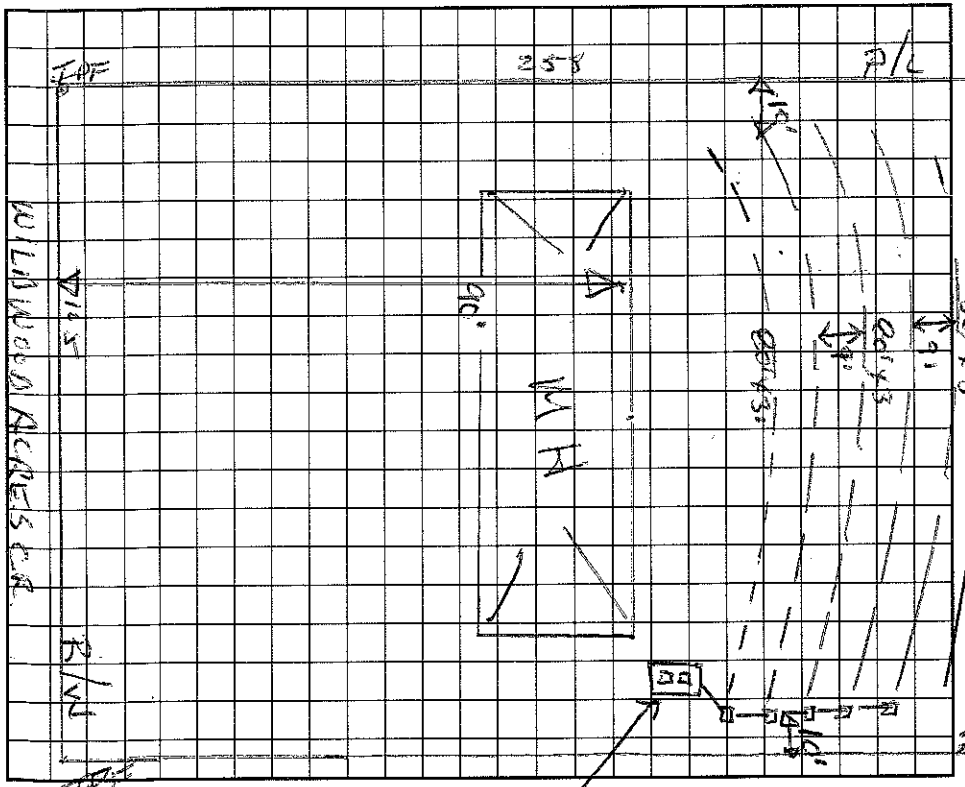

AS BUILT SKETCH

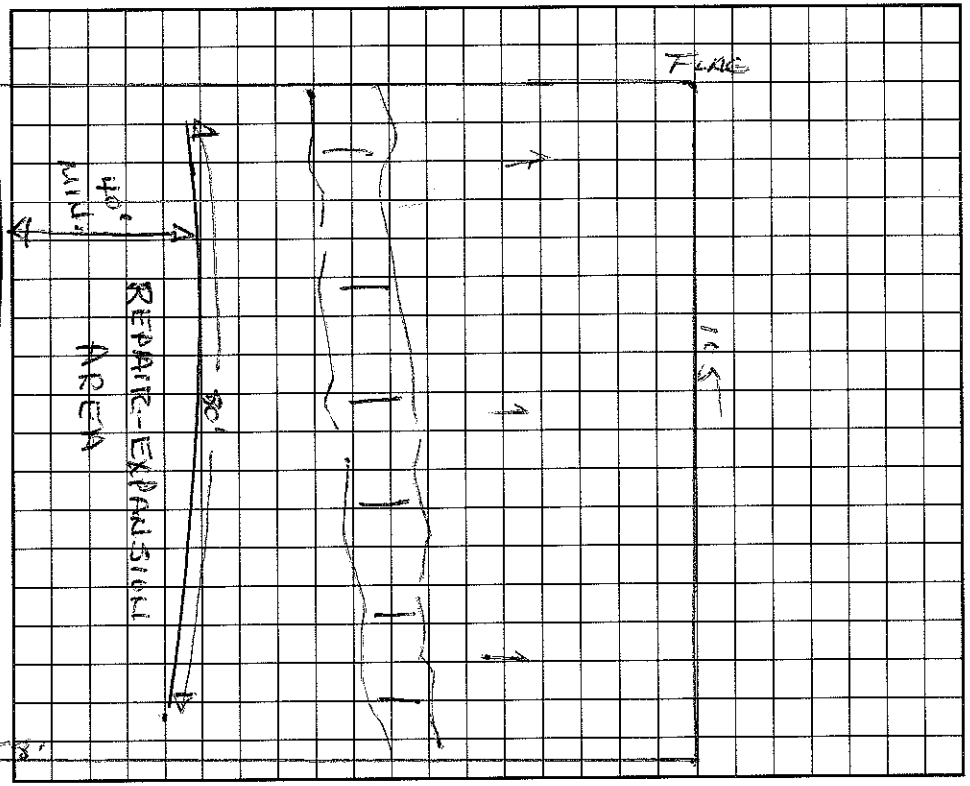

I understand that this permit can be suspended or revoked if any false information is supplied toward securing the permit/any unauthorized changes are made to the site/any unauthorized changes are made in the installation of the system. Improvement Permit is valid for 60 months from date of issuance.

Signed: Randall J Phillips

Improvement Permit by: Wesley Sparks RS. date 2/22/95

Existing System Inspection by: _____ date _____

Installed by: Tennant Const.

Certificate of Completion by: Michael D. Dennis date 3-17-95

Operation Permit by: _____ date _____

HEALTH DEPT. COPY: WHITE INSPECTION COPY (FINAL): GREEN OWNER COPY (FINAL): YELLOW INSPECTION COPY (INITIAL): PINK OWNER COPY (INITIAL): GOLD