IREDELL COUNTY HEALTH DEPARTMENT

STATESVILLE 704-878-5305 MOORESVILLE 704-664-5281

IMPROVEMENT PERMIT / AUTHORIZATION TO CONSTRUCT / OPERATION PERMIT / EXISTING SYSTEM INSPECTION

PERMIT# 72479 PIN# 4665328667

OWNER OR CONTRACTOR James McKnight DATE 5/6/98

ADDRESS 255 Rolling Hills Rd Mooresville, NC 28115 PHONE: Business (704) 664-9080 Home

LOCATION Shearers Rd TR Ashley Woods at Fork TL then on Right - Knight-N-Gail

SUBDIVISION Ashley Woods BLOCK / SECTION I LOT 36 LOT AREA 27,252 incl.Row SITE CLASS. PS DESIGN FLOW 360 gpd L.T.A.R. .3

Septic Tank: 1000 Gallons; STB 1062 Date 6/7/98

Pump Tank: ____ Gallons; PT ____ Date ____

Pump Make: ~~QE37~~ Model ____ Serial No. ____

Nitrification Field: No Fields 1 Square Feet ~~900~~ Linear Feet ~~300~~

No Lines ~~6~~ Trench Width 36" Max Trench Bottom Depth 36" Gravel Depth 12"

☒ New System ☐ Repair System Type: I, II, (III), IV, V, VI

System Description: Gravity - Plastic Chamber or Similar

Repair System Description Gravity/Pump Panel Blk

Maintenance Agreement Required: ☐ Yes ☒ No

☐ House/Mod. Home ☒ Mobile Home ☐ Business ☐ Other

No. Bedrooms 3 No. Bathrooms 2 No. Employees ____


☐ Slab ☒ Crawl Space ☐ Basement w/plumbing ☐ Basement wo/plumbing

Water Supply: ☐ Individual ☐ Public ☒ Community


Comments:/Conditions: ~~*~~ 25% reduction in Drainfield Area
Distribution: Flow divider to 2 separate D-Boxes.
Keep Septic System at least 10' from PL & 5' from House.

Comments:/Conditions:

INITIAL SITE SKETCH Scale 1:40

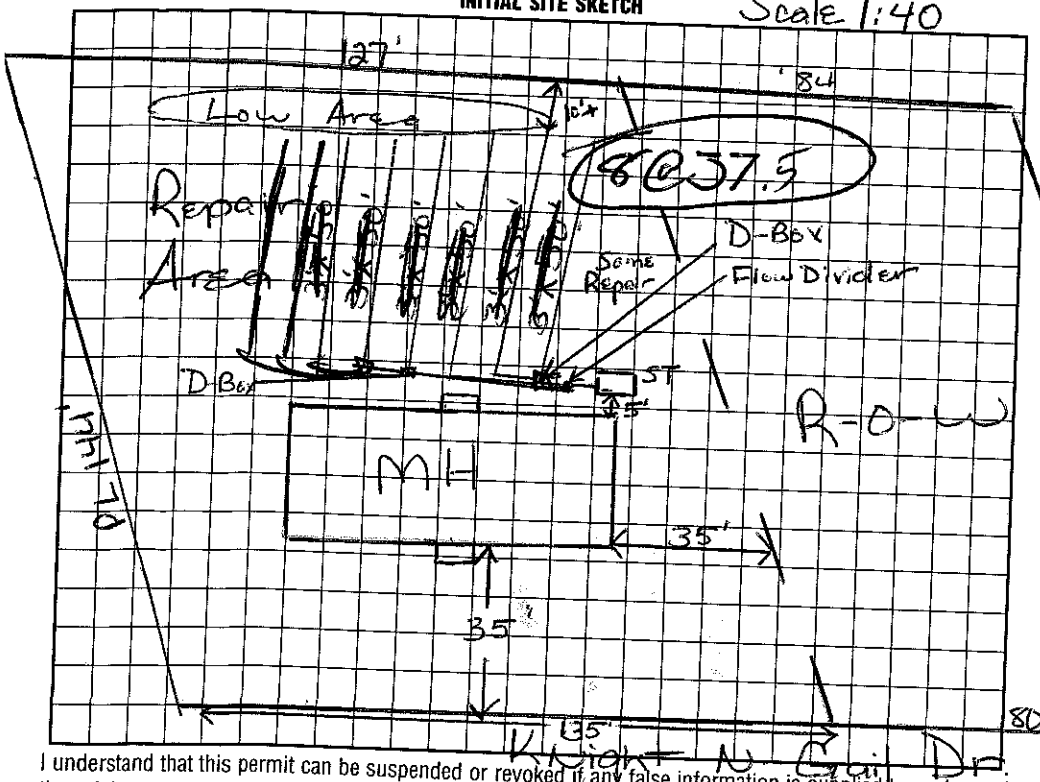

AS BUILT SKETCH

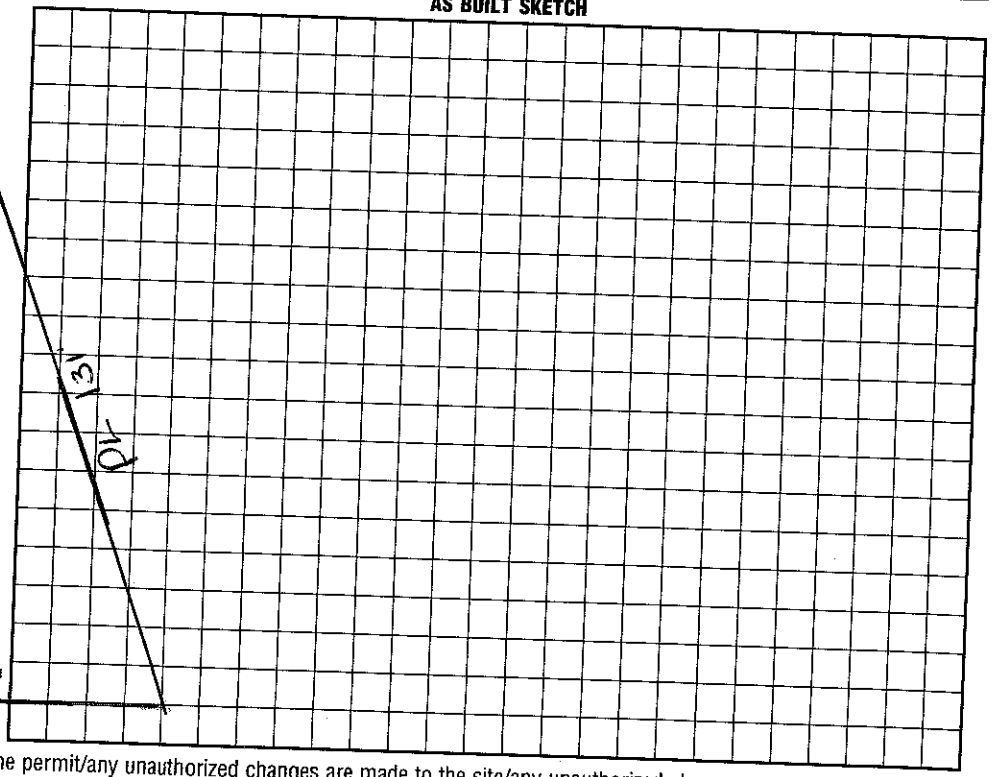

I understand that this permit can be suspended or revoked if any false information is supplied toward securing the permit/any unauthorized changes are made to the site/any unauthorized changes are made in the installation of the system. Improvement Permit with plat valid without expiration. Improvement Permit with site plan valid for sixty months. Authorization to Construct is valid for a period equal to that of Improvement Permit – not to exceed sixty months.

Signed: ____ date 5/12/98

Improvement Permit by: ____ date 5/6/98

Authorization to Construct by: ____ date 5/6/98

Installed by: A1 BACKHOE

Operation Permit by: ____ date 8/13/98

Existing System Inspection by: ____ date ____

HEALTH DEPT. COPY: WHITE INSPECTION COPY (FINAL): GREEN OWNER COPY (FINAL): YELLOW INSPECTION COPY (INITIAL): PINK OWNER COPY (INITIAL): GOLD