IREDELL COUNTY HEALTH DEPARTMENT

STATESVILLE 704-878-5305 MOORESVILLE 704-664-5281

IMPROVEMENT PERMIT / AUTHORIZATION TO CONSTRUCT / OPERATION PERMIT / EXISTING SYSTEM INSPECTION

PERMIT# 074865 PIN# 4665329552 DATE

OWNER OR CONTRACTOR McKnight Enterprises PHONE: Business Home

ADDRESS

LOCATION

SUBDIVISION Ashley Woods BLOCK / SECTION LOT 22 LOT AREA .57Acre SITE CLASS. P3 DESIGN FLOW 360gpd L.T.A.R. .25 gpd/

Septic Tank: 1000 Gallons; STB 1012 Date 7/5/99

Pump Tank: Gallons; PT Date

Pump Make: Model Serial No.

Nitrification Field: No Fields 1 Square Feet 486 Linear Feet 240

No Lines 4at60' Trench Width 24" Max Trench Bottom Depth 36" Gravel Depth N/A

☒ New System ☐ Repair System Type: I, II, III, IV, V, VI

System Description: Gravity Panel

Repair System Description: Grav/Pump Panel

Maintenance Agreement Required: ☐ Yes ☐ No

☐ House/Mod. Home ☒ Mobile Home ☐ Business ☐ Other

No. Bedrooms 3 No. Bathrooms 2 No. Employees


☐ Slab ☒ Crawl Space ☐ Basement w/plumbing ☐ Basement wo/plumbing

Water Supply: ☐ Individual ☐ Public ☒ Community

Comments:/Conditions: Filter installed

Comments:/Conditions:

INITIAL SITE SKETCH Scale 1"=50'

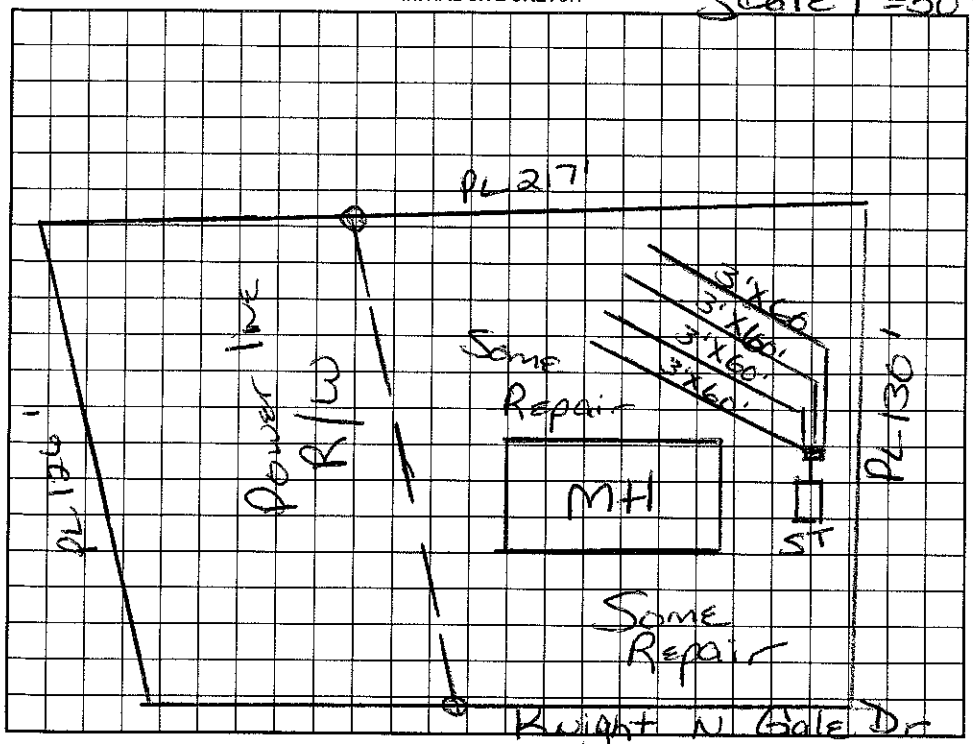

AS BUILT SKETCH

Permit can be suspended or revoked if any false information is supplied toward securing the permit/any unauthorized changes are made to the site/any unauthorized changes are made in the installation of the system. Improvement Permit with plat valid without expiration. Improvement Permit with site plan valid for sixty months. Authorization to Construct is valid for a period equal to that of Improvement Permit – not to exceed sixty months.

Signed: date

Improvement Permit by: date

Authorization to Construct by: date

Installed by: A-1 Back hoe

Operation Permit by: Maine H.H. Dotson date 9/17/99

Existing System Inspection by: date

HEALTH DEPT. COPY: WHITE OWNER COPY (FINAL): YELLOW OWNER COPY (INITIAL): PINK