2.

IREDELL COUNTY HEALTH DEPARTMENT

STATESVILLE 704-878-5305 MOORESVILLE 704-664-5281

IMPROVEMENT PERMIT / AUTHORIZATION TO CONSTRUCT / OPERATION PERMIT / EXISTING SYSTEM INSPEC.

PERMIT# 074865 PIN# 4665329552 DATE 1/25/99

OWNER OR CONTRACTOR McKNIGHT ENTERPRISES PHONE: Business Home 664-9080

ADDRESS 255 ROLLING HILLS RD MOORESVILLE NC 28115

LOCATION SHEARERS RD - TR ASHLEY WOODS. TL KNIGHT N GALE - ON LT

SUBDIVISION ASHLEY WOODS BLOCK / SECTION LOT 22 LOT AREA .57AC SITE CLASS. RS DESIGN FLOW 360GPD L.T.A.R. .25000/FT

Septic Tank: 1000 Gallons; STB 1012 Date 7/5/99
Pump Tank: Gallons; PT Date
Pump Make: Model Serial No.
Nitrification Field: No Fields 1 Square Feet 480 Linear Feet 240
No Lines 4@60' Trench Width 24" Max Trench Bottom Depth 36" Gravel Depth N/A

☑ New System ☐ Repair System Type: I, II, III, IV, V, VI
System Description: GRAVITY PANEL
Repair System Description: GRAVITY/PUMP PANEL
Maintenance Agreement Required: ☐ Yes ☑ No


☑ House/Mod. Home No. Bedrooms 3
☑ Mobile Home No. Bathrooms 2
☐ Business No. Employees
☐ Other
☐ Slab ☑ Crawl Space ☐ Basement w/plumbing ☐ Basement wo/plumbing

Water Supply:
☐ Individual
☐ Public
☑ Community

Comments:/Conditions: Filter installed

Comments:/Conditions:

INITIAL SITE SKETCH 1" = 50'

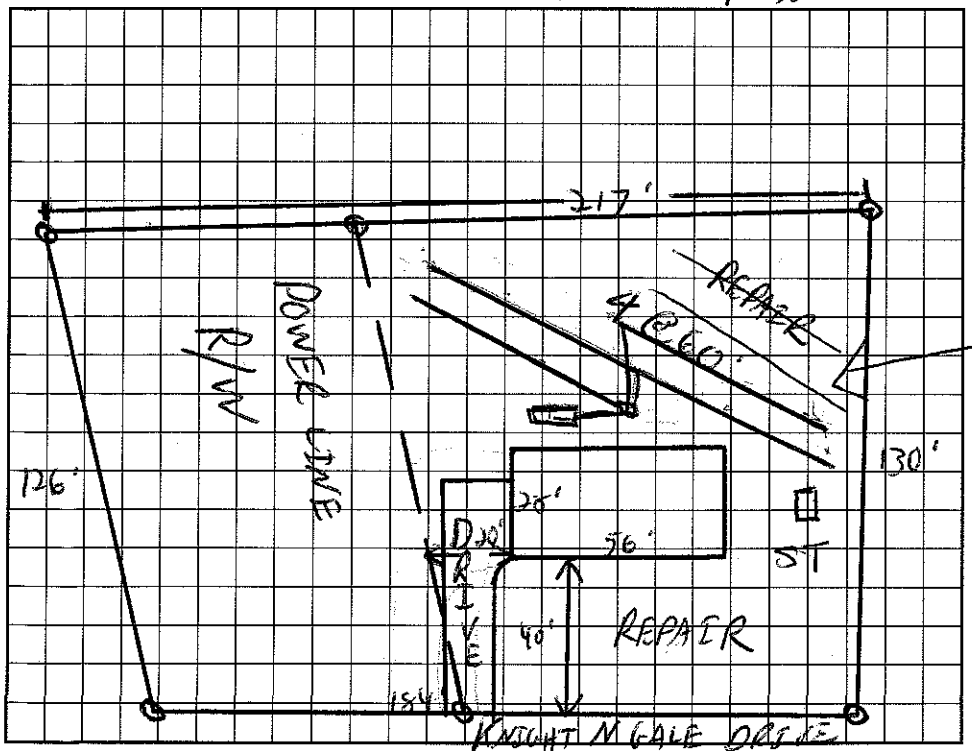

AS BUILT SKETCH

Moved tank over & installed 4-60' lines in a row.

See Attached Drawing

I understand that this permit can be suspended or revoked if any false information is supplied toward securing the permit/any unauthorized changes are made to the site/any unauthorized changes are made in the installation of the system. Improvement Permit with plat valid without expiration. Improvement Permit with site plan valid for sixty months. Authorization to Construct is valid for a period equal to that of Improvement Permit – not to exceed sixty months.

Signed: Floyd A Hamm date

Improvement Permit by: C. Byrum REHS date 1/25/99

Authorization to Construct by: C. Byrum REHS date 1/25/99

Installed by: A-1 Backhoe

Operation Permit by: Marvin H. Dixon date 9/17/99

Existing System Inspection by: date

HEALTH DEPT. COPY: WHITE INSPECTION COPY (FINAL): GREEN OWNER COPY (FINAL): YELLOW INSPECTION COPY (INITIAL): PINK OWNER COPY (INITIAL): GOLD